


Plat of Survey


Situated in the Township and Village of Perry, County of Lake & State of Ohio
 & being part of Lots 51, 52, 53, 61, 62 and 63, Township 11 North, Range 7 West
 of the Connecticut Western Reserve Survey,
 May 2007 Scale 1"=200'

LEGEND

	BUILDING		INDEX CONTOUR
	OBSCURED AREA		INTERMEDIATE CONTOUR
	PAVEMENT CENTERLINE		OBSCURED INDEX CONTOUR
	PAVEMENT EDGE		OBSCURED INTERMEDIATE CONTOUR
	RAILROAD		TOWER
	SPOT ELEVATION		STREAM (Less than 10')
			STREAM (Greater than 10')
			LAKE OR POND

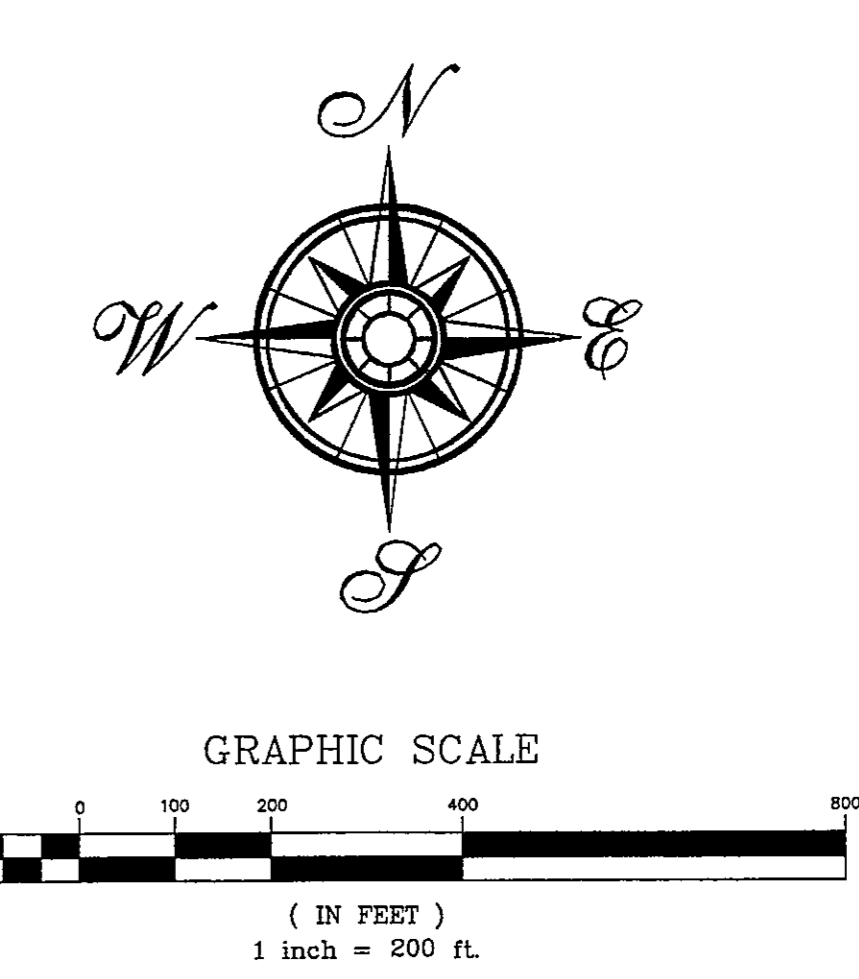

Notes Regarding Background Base Mapping:
 Actual Field Located Encroachments are shown in Red.
 Planimetric Mapping Based on
 O.S.P.C.S North Zone NAD83
 Vertical Datum NAVD88
 Date of Mapping April 2000
 Aerial Ortho Photo Mapping Date
 May 2004

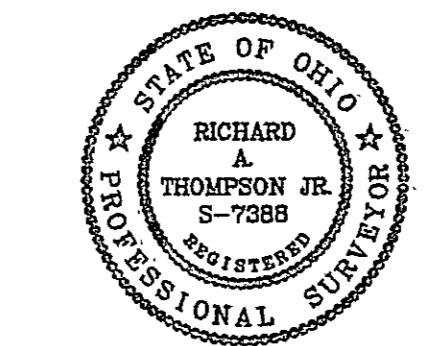

SURVEY CERTIFICATION:
 I hereby certify that this plat was prepared from a field survey made under my direct supervision. Measurements were found or set as indicated. Dimensions are expressed in feet and decimal parts thereof. Bearings refer to the meridian of Call Road being N 2°00'20" E. All of which are correct to the best of my knowledge and belief. This plat was prepared in accordance with the provisions of Chapter 4733-37 of the Ohio Administrative Code. This plat was prepared in accordance with the provisions of Chapter 4733-37 of the Ohio Administrative Code. This plat was prepared in accordance with the provisions of Chapter 4733-37 of the Ohio Administrative Code.
 Richard A. Thompson, Jr., P.S. 5/30/07



LAND DESIGN consultants
 www.landdesign.net
 ENGINEERS PLANNERS SURVEYORS
 8695 East Avenue Mentor, Ohio 44060
 TEL: (440) 255-9463 (440) 951-LAND
 (440) 354-6938 FAX: (440) 255-9575

DATE 5/30/07
 SCALE: HOR. 1"=200'
 VERT. _____
 FILENAME survey-split
 COMPUTER S:
 TAB NAME Boundary

Northerly Portion
 Village & Township of Perry
 Lake County - Ohio

SHEET 1 OF 2
 CONTRACT No. FIFTT1-0701