

PLAT OF SURVEY

LERoy TOWNSHIP, LAKE COUNTY, OHIO
 for: LEROY COMMUNITY CHAPEL
 CLIENT OWNER

ADDRESS STREET CITY ZIP
 SUBDIVISION NAME TRACT 20 MILDON DRIVE STREET
 VOL-PG. LOT 7A-5A-43&44
 SUBLOT NO. STREET VOL-PG. PERM. PARCEL NO.

LEGEND

SANITARY MANHOLE --- ○
 STORM MANHOLE --- ●
 INLET OR CATCH BASIN --- □
 HYDRANT --- ⊕
 EXISTING CONTOURS --- - - -
 PROPOSED CONTOURS --- ———

EXIST. ELEV. → 100.0
 100.0 ← PROP. ELEV.
 AS BUILT ELEVATION
 INDICATES DIRECTION OF SURFACE DRAINAGE

REMARKS

ALL BOUNDARY DATA SHOWN WAS OBTAINED FROM (DEEDS, RECORDED SUBDIVISION PLAT OR OTHER PUBLIC RECORDS)

LOCATIONS AS SHOWN OF ADJACENT WELLS AND SEPTIC TANKS OBTAINED FROM LAKE COUNTY HEALTH DEPARTMENT

DESIGN CERTIFICATION

THIS PLAT WAS PREPARED BY ME, AND IS CORRECT TO THE BEST OF MY KNOWLEDGE AND BELIEF.

NAME: *Harry S. Jones, Jr.* SURVEYOR REGISTRATION NO. 86313 10/28/02


CHECK LIST

NO. OF BEDROOMS	WATER MAIN SIZE, LOCATION
DIMENSIONS	SAN. SEWER SIZE % GR. LOC.
BEARINGS	SAN. MH. CAST. ELEV. INV. ELEV.
TIE TO NEAREST STREET	SAN. CONN. SIZE, LOC. DEPTH
SUBLOT NO. PARCEL NO.	STORM SEWER SIZE % GR. LOC.
SURROUNDING OWNERS	STORM MH. CAST. ELEV. INV. ELEV.
BLDG. DIMENSIONS FIN GR.	PAV'T TYPE GRADE CURBS
BLDG. TIES FL'R. GRADES	GAS LINE LOC. SIZE PRESSURE
APRON TYPE WIDTH THICKNESS	SEPTIC TANK LOCATION & DUPLICATION AREA
SIDEWALK TYPE WIDTH THICKNESS	WELL LOCATION
CULVERT TYPE DIA., LENGTH	ISOLATION RADIUS FROM WELL
ROCK OUTCROPPINGS	

REVISIONS			PLAN PREPARED BY:		
NO.	DATE	BY	BABCOCK JONES & ASSOCIATES, INC.		
1			PAINESVILLE, OHIO		
2			DRAWN BY B.P.	SCALE 1" = 30'	PHONE NO. 440-357-1811
3			CHK'D. H.J.	DATE 9/3/02	DRAWING NO.
4			CREW CHIEF W.B.	APP'D H.J.	01-034-LS
5					

"AS BUILT" CERTIFICATION
 I, HEREBY CERTIFY THAT THE CIRCLED GRADES ARE EXISTING FINISH GRADES CHECKED IN THE FIELD ON _____, 20____ AND ARE CORRECT TO THE BEST OF MY KNOWLEDGE AND BELIEF.


REGISTERED SURVEYOR _____ REG. NO _____

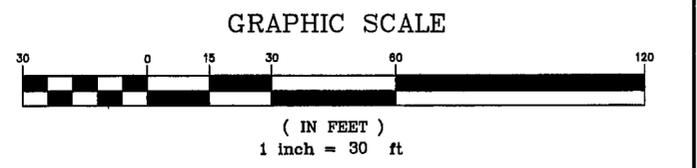

NOTE: ALL IRON PINS SET ARE 5/8" X 30" AND CAPPED BABCOCK JONES & ASSOC.



JAMES & GREGORY KONTE
 VOL 343-PG 1137
 7A-4-21

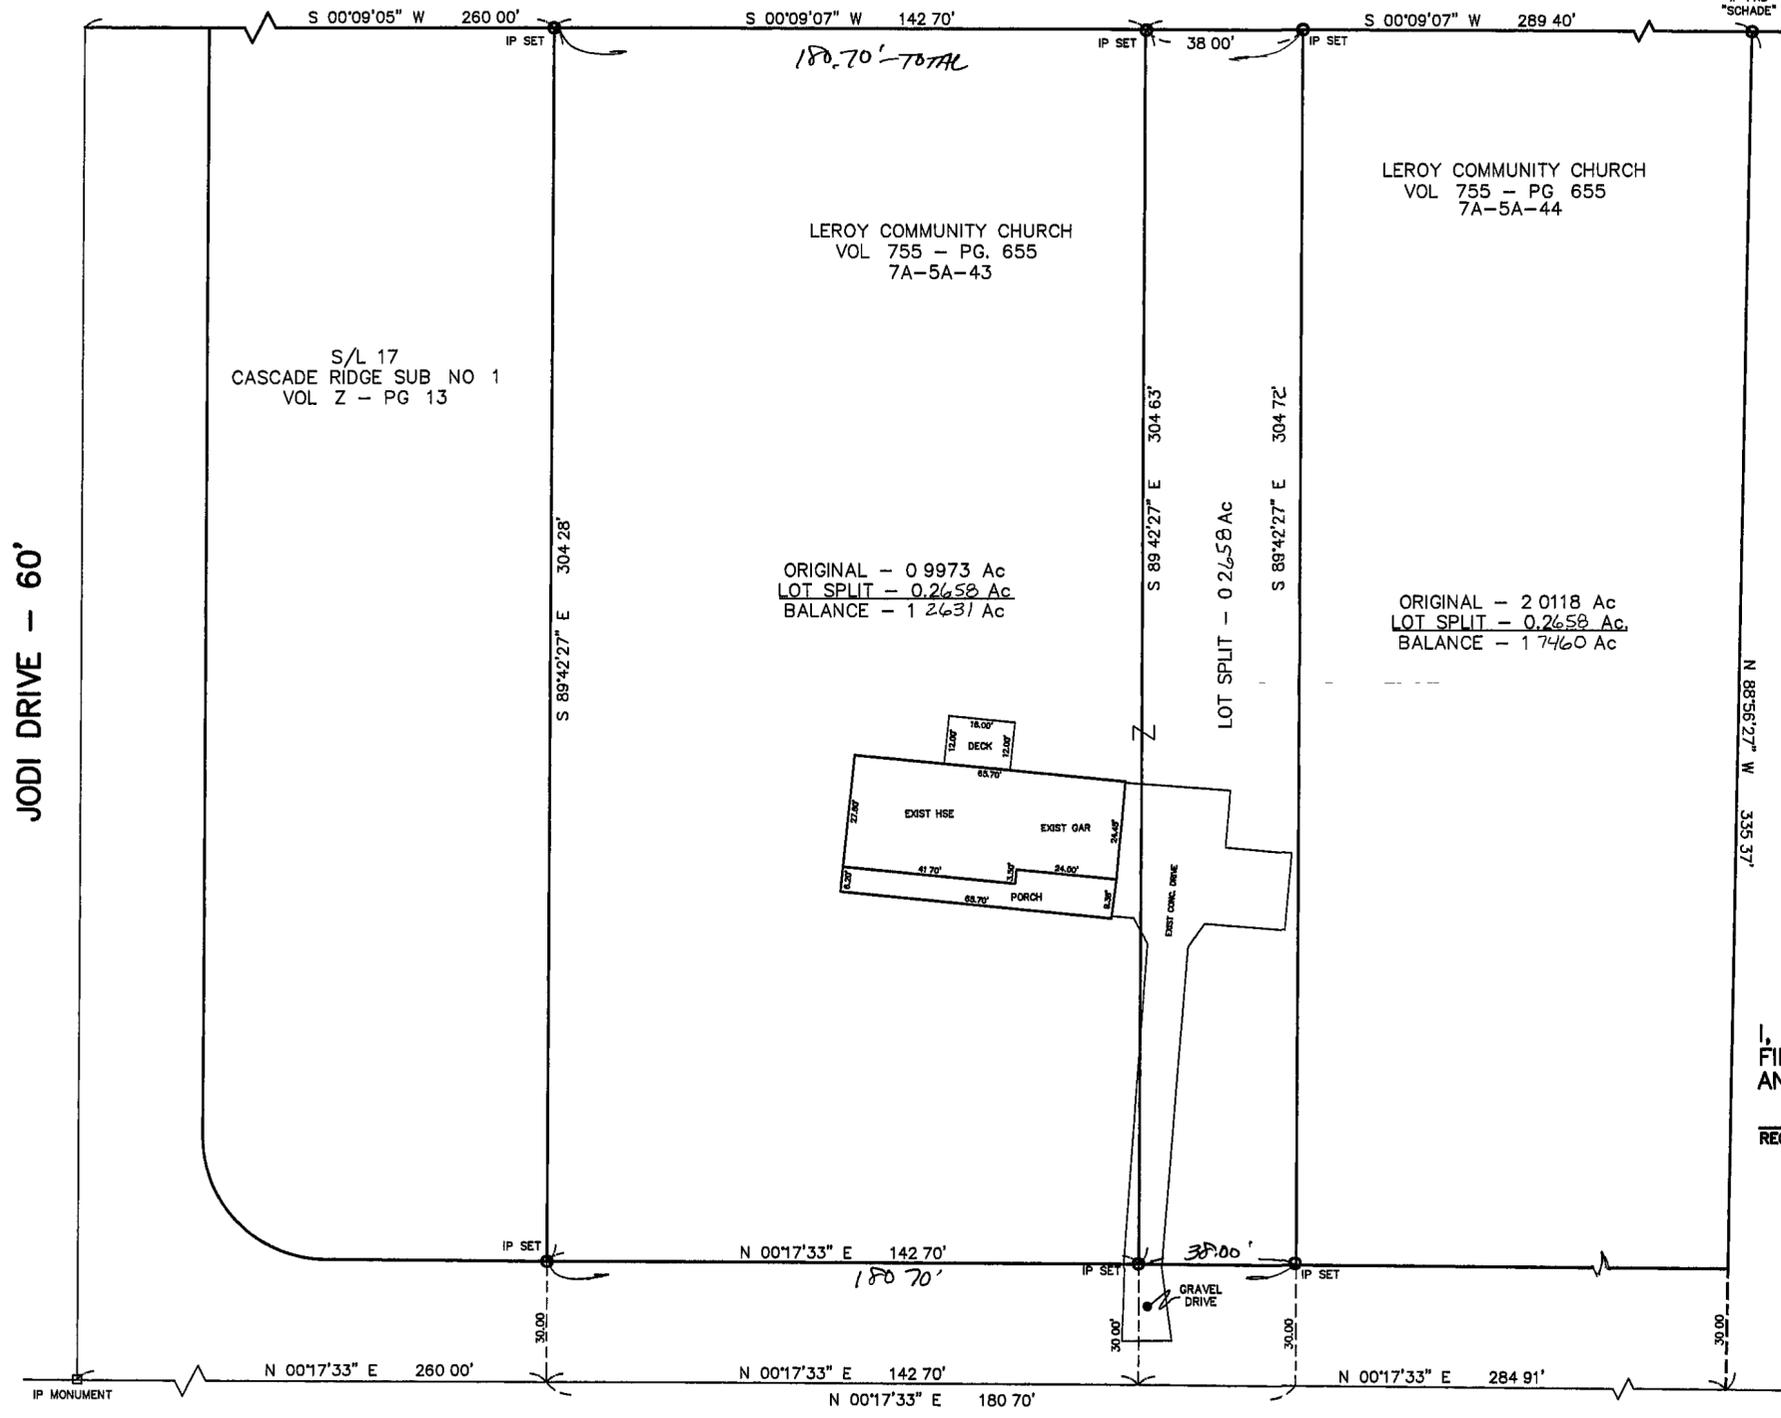

MILDON DRIVE - 60'

Bearings are based upon the centerline of Mildon Drive being South 0°17'33" West and are used to describe angles only