

PLAT OF SURVEY

LERROY TOWNSHIP, LAKE COUNTY, OHIO

for: BOB COLLINS

CLIENT	OWNER
ADDRESS	STREET CITY ZIP
SUBDIVISION	TRACT NAME
VOL.-PG.	LOT
SUBLOT NO.	STREET
	VOL.-PG.
	PERM. PARCEL NO.

LEGEND

SANITARY MANHOLE	---	EXIST. ELEV.	100.0	PROP. ELEV.	100.0
STORM MANHOLE	---	AS BUILT ELEVATION			
INLET OR CATCH BASIN	---	INDICATES			
HYDRANT	---	DIRECTION OF			
EXISTING CONTOURS	---	SURFACE DRAINAGE			
PROPOSED CONTOURS	---				

REMARKS

ALL BOUNDARY DATA SHOWN WAS OBTAINED FROM (DEEDS, RECORDED SUBDIVISION PLAT OR OTHER PUBLIC RECORDS)
 LOCATIONS AS SHOWN OF ADJACENT WELLS AND SEPTIC TANKS OBTAINED FROM LAKE COUNTY HEALTH DEPARTMENT

DESIGN CERTIFICATION

THIS PLAT WAS PREPARED BY ME, AND IS CORRECT TO THE BEST OF MY KNOWLEDGE AND BELIEF.

Harry S. Jones, Jr. #0343
 NAME SURVEYOR REGISTRATION NO



CHECK LIST

NO. OF BEDROOMS	WATER MAIN SIZE, LOCATION
DIMENSIONS	SAN. SEWER SIZE & GR. LOC.
BEARINGS	SAN. MH. CAST. ELEV. INV. ELEV.
TIE TO NEAREST STREET	SAN. CONN. SIZE, LOC. DEPTH
SUBLOT NO. PARCEL NO.	STORM SEWER SIZE & GR. LOC.
SURROUNDING OWNERS	STORM MH. CAST. ELEV. INV. ELEV.
BLDG. DIMENSIONS FIN GR	PAV'T TYPE GRADE CURBS
BLDG. TIES FL'R. GRADES	GAS LINE LOC. SIZE PRESSURE
APRON TYPE WIDTH THICKNESS	SEPTIC TANK LOCATION & DUPLICATION AREA
SIDEWALK TYPE WIDTH THICKNESS	WELL LOCATION
CULVERT TYPE DIA., LENGTH	ISOLATION RADIUS FROM WELL
ROCK OUTCROPPINGS	

REVISIONS			PLAN PREPARED BY:	
NO.	DATE	BY	Bj BABCOCK JONES & ASSOCIATES, INC.	
1	6/15/00	HJ	PAINESVILLE, OHIO	
2			DRAWN BY T.R.	SCALE 1"=50'
3			CHK'D. H.J.	PHONE NO. 440-357-1811
4			DATE 8/10/00	DRAWING NO.
5			CREW CHIEF W.B.	90-143
			APP'D H.J.	

"AS BUILT" CERTIFICATION
 I, HEREBY CERTIFY THAT THE CIRCLED GRADES ARE EXISTING FINISH GRADES CHECKED IN THE FIELD ON _____, 20____ AND ARE CORRECT TO THE BEST OF MY KNOWLEDGE AND BELIEF.

REGISTERED SURVEYOR _____ REG. NO. _____

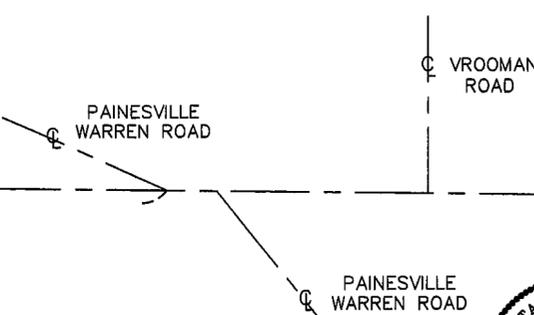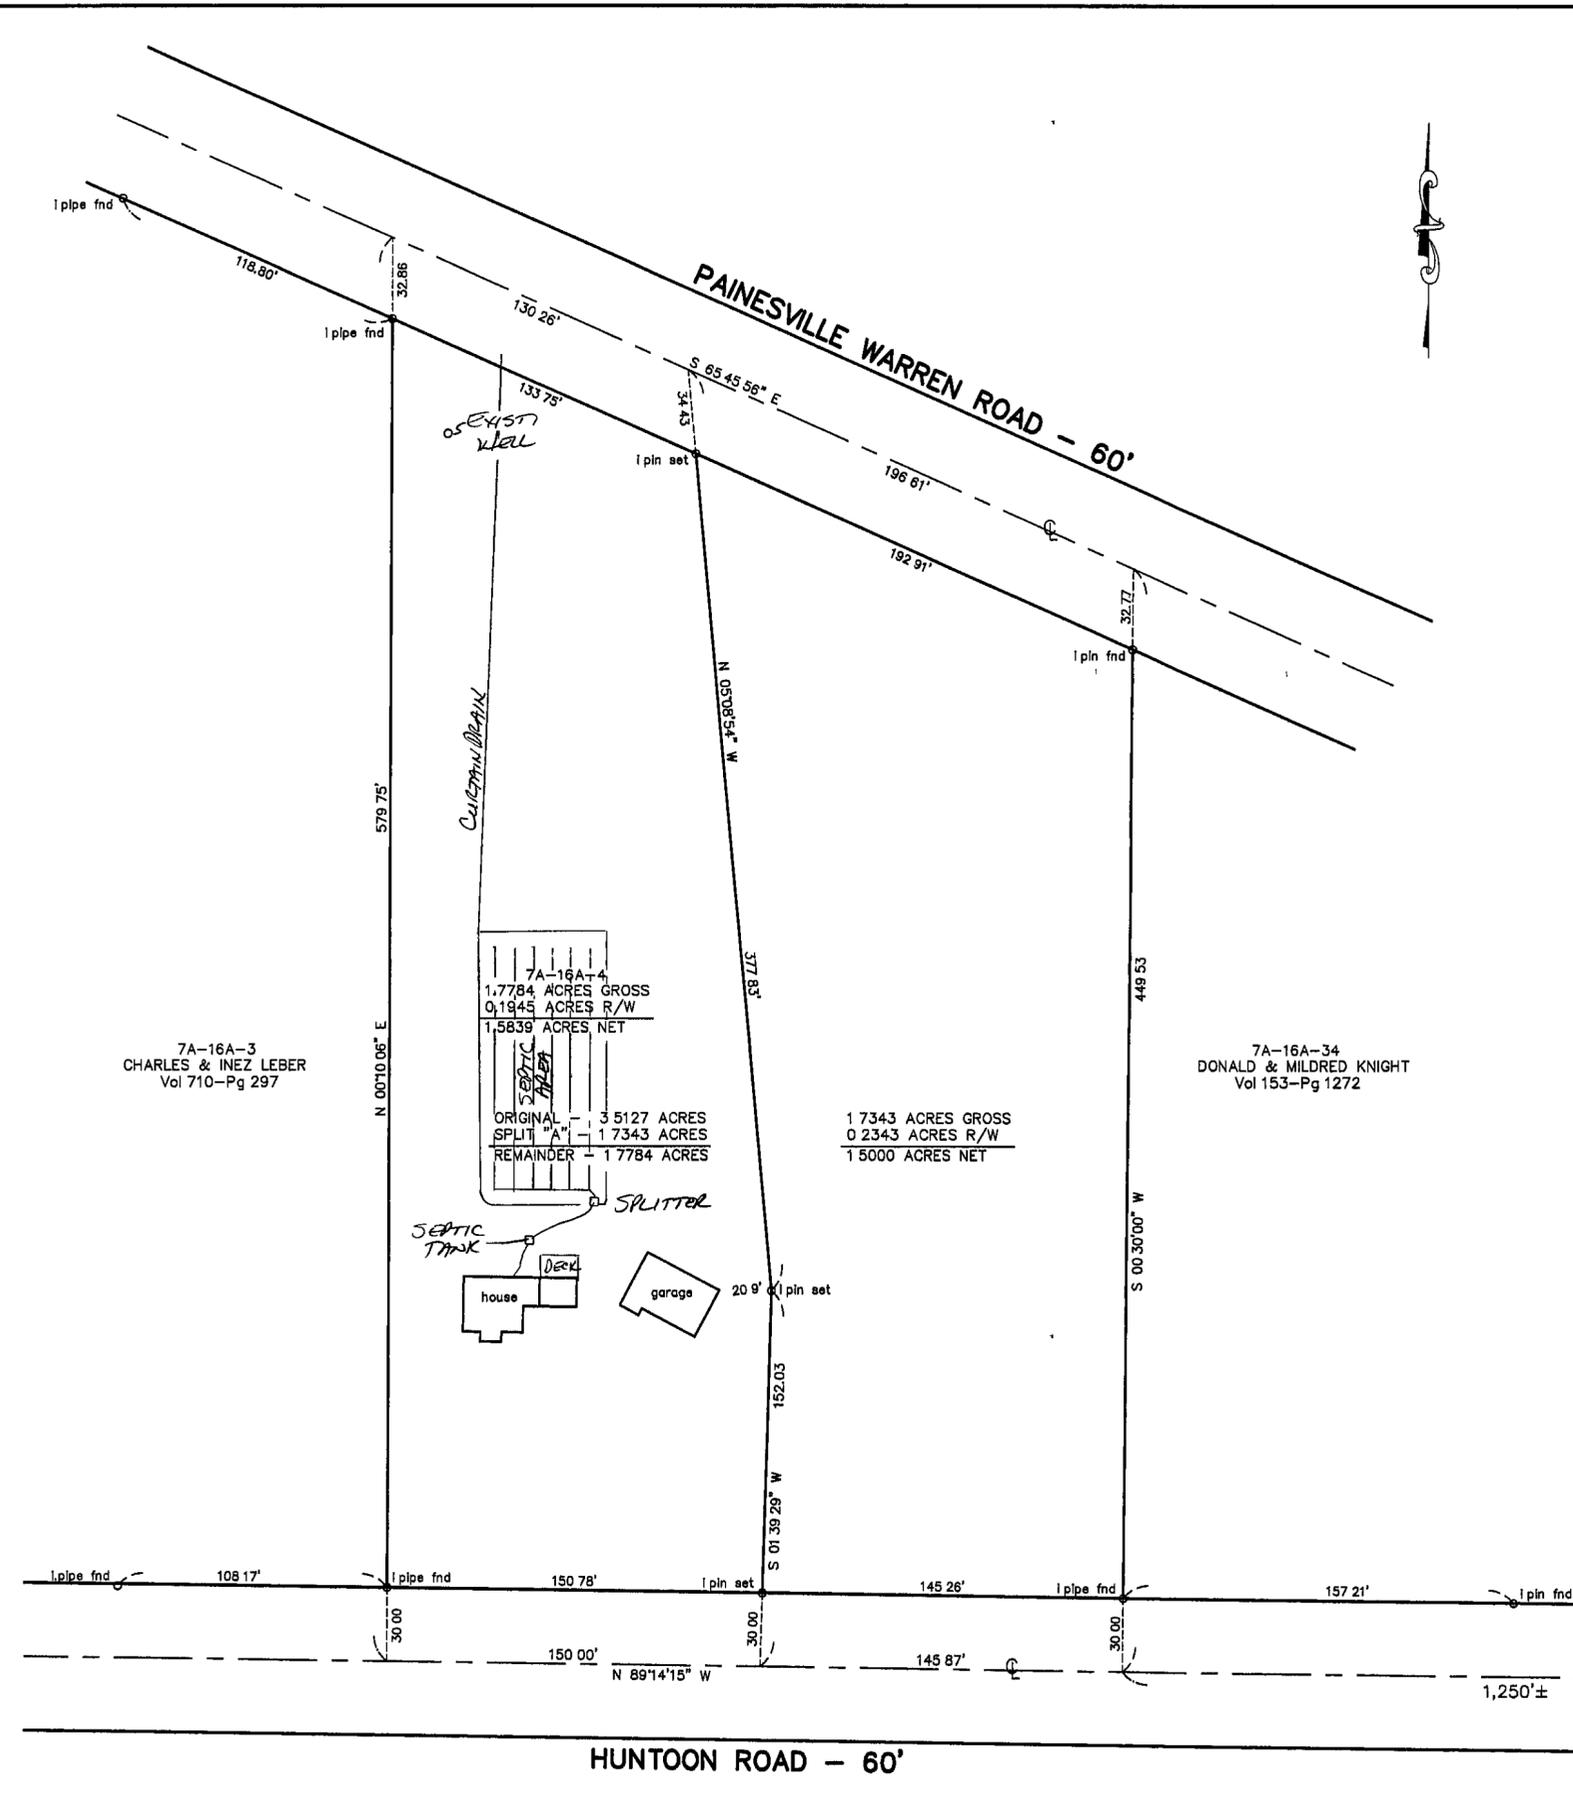

(R.H.)
 PER JONES BY PHONE 6/19/00
 ALL PIPES FD WERE 1"
 ALL PINS FD WERE 5/8"
 NOTE: ALL PINS SET ARE 5/8" X 30" W/CAP

