


CLYDE & HELEN
HACKER
VOL. 517 PG. 66

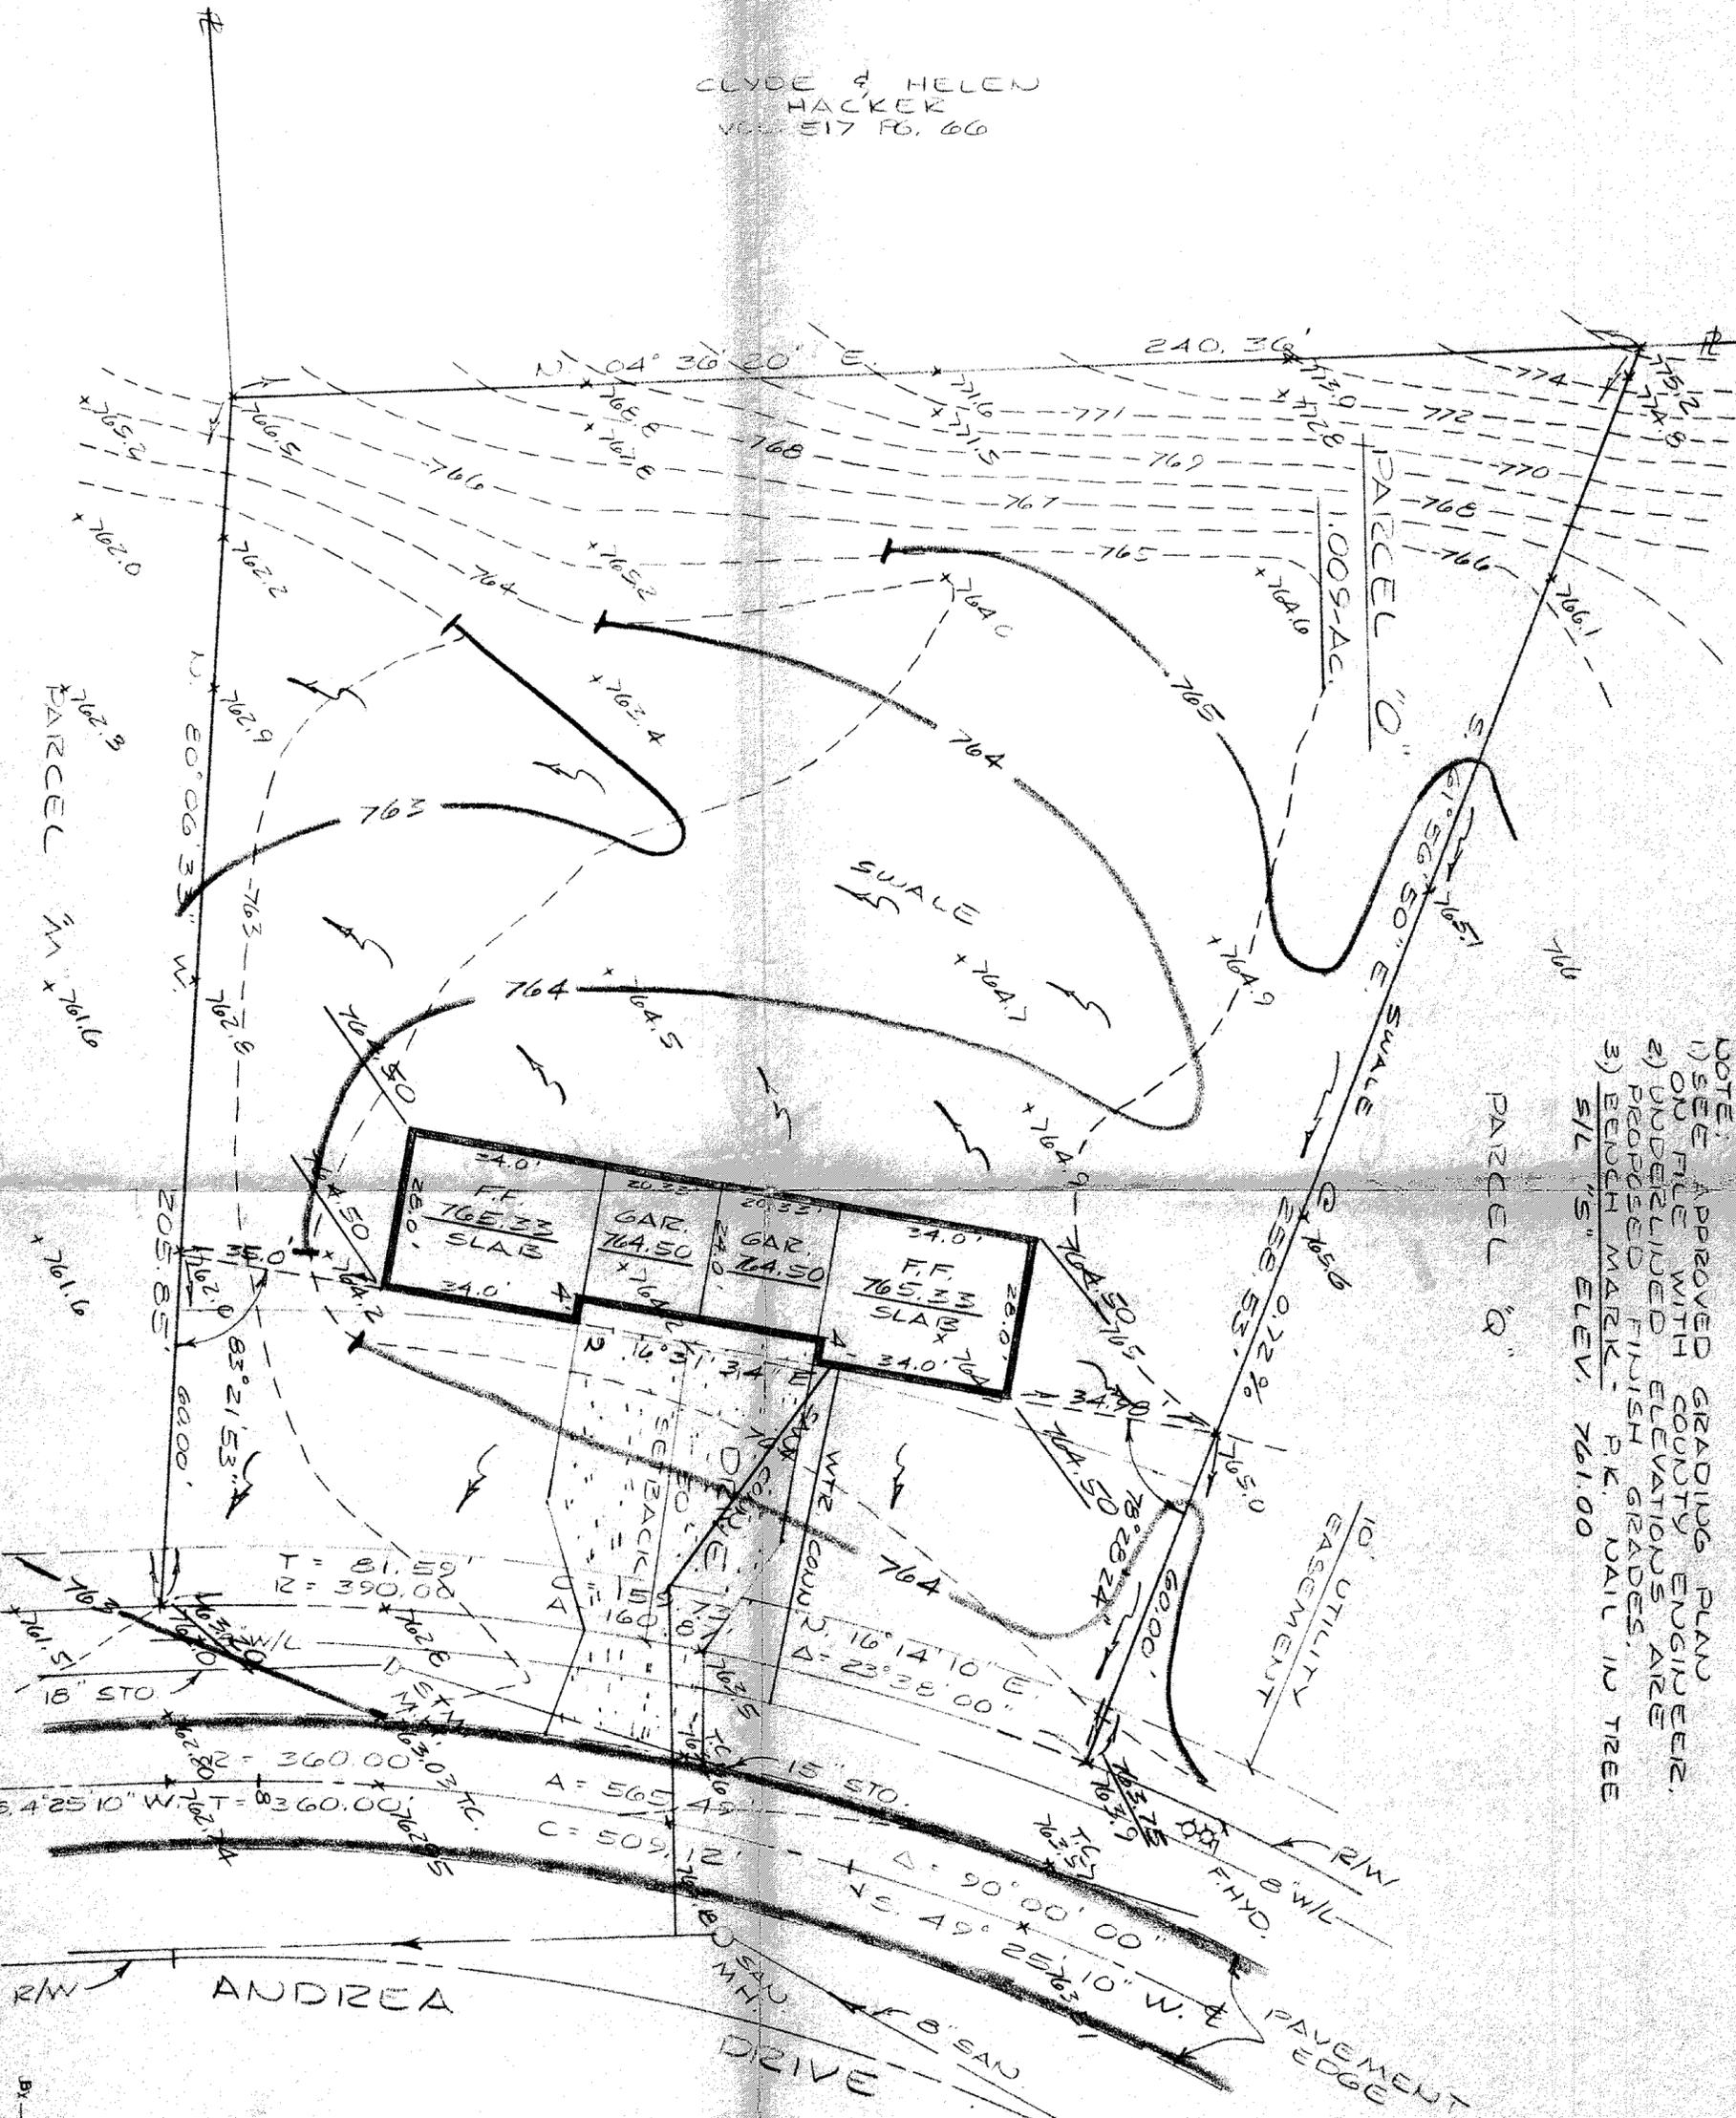

NOTE:
1) SEE APPROVED GRADING PLAN
ON FILE WITH COUNTY ENGINEER.
2) UNDEVELOPED ELEVATIONS ARE
PROPOSED FINISH GRADES.
3) BENCH MARK - P.K. NAIL IN TREE
51/ "S" ELEV. 761.00

DESIGN CERTIFICATION
THIS PLAN WAS PREPARED BY ME
AND IS CORRECT TO THE BEST OF
MY KNOWLEDGE AND BELIEF.

AS BUILT CERTIFICATION
I HEREBY CERTIFY THAT THE CONCRETE GRADES
AND ELEVATIONS SHOWN ON THIS PLAN
WERE FIELD CHECKED AND THE
SURVEY IS CORRECT TO THE BEST OF MY
KNOWLEDGE AND BELIEF.

SITE PLAN FOR:
SVA VELY COMPANY
PARCEL "O" SHADY KNOLL SUBDIVISION Ph 2
CORCORN TOWNSHIP, LAKE COUNTY, OHIO

COLPETZER & WOODS
CONSULTANTS, INC.
MENTOR, OHIO 44060

DATE: APR 83
SCALE: 1"=20'
DRAWN BY: [Signature]
CHECKED BY: [Signature]
DATE: 4/8/83

ZONING PERMIT # 4751
ISSUED 11-11-83

SUBJECT TO APPROVAL BY:
 Lake County Sanitary Eng.
 Lake County Eng. Dept.
 Lake County Planning Comm.
 Lake County Bldg. Dept.

Tom & Marlene
Grading Plan Approved
as shown and/or noted
THOMAS P. GILLES, P.E.
Lake County Engineer

By: [Signature] Date: 15 Nov 83