


S/L 44
TIMOTHY & MELISSA CONNOLY
No. 200026414
24A-BB-11
(VACANT)

S/L 43
24A-BB-10
5.277 Ac.

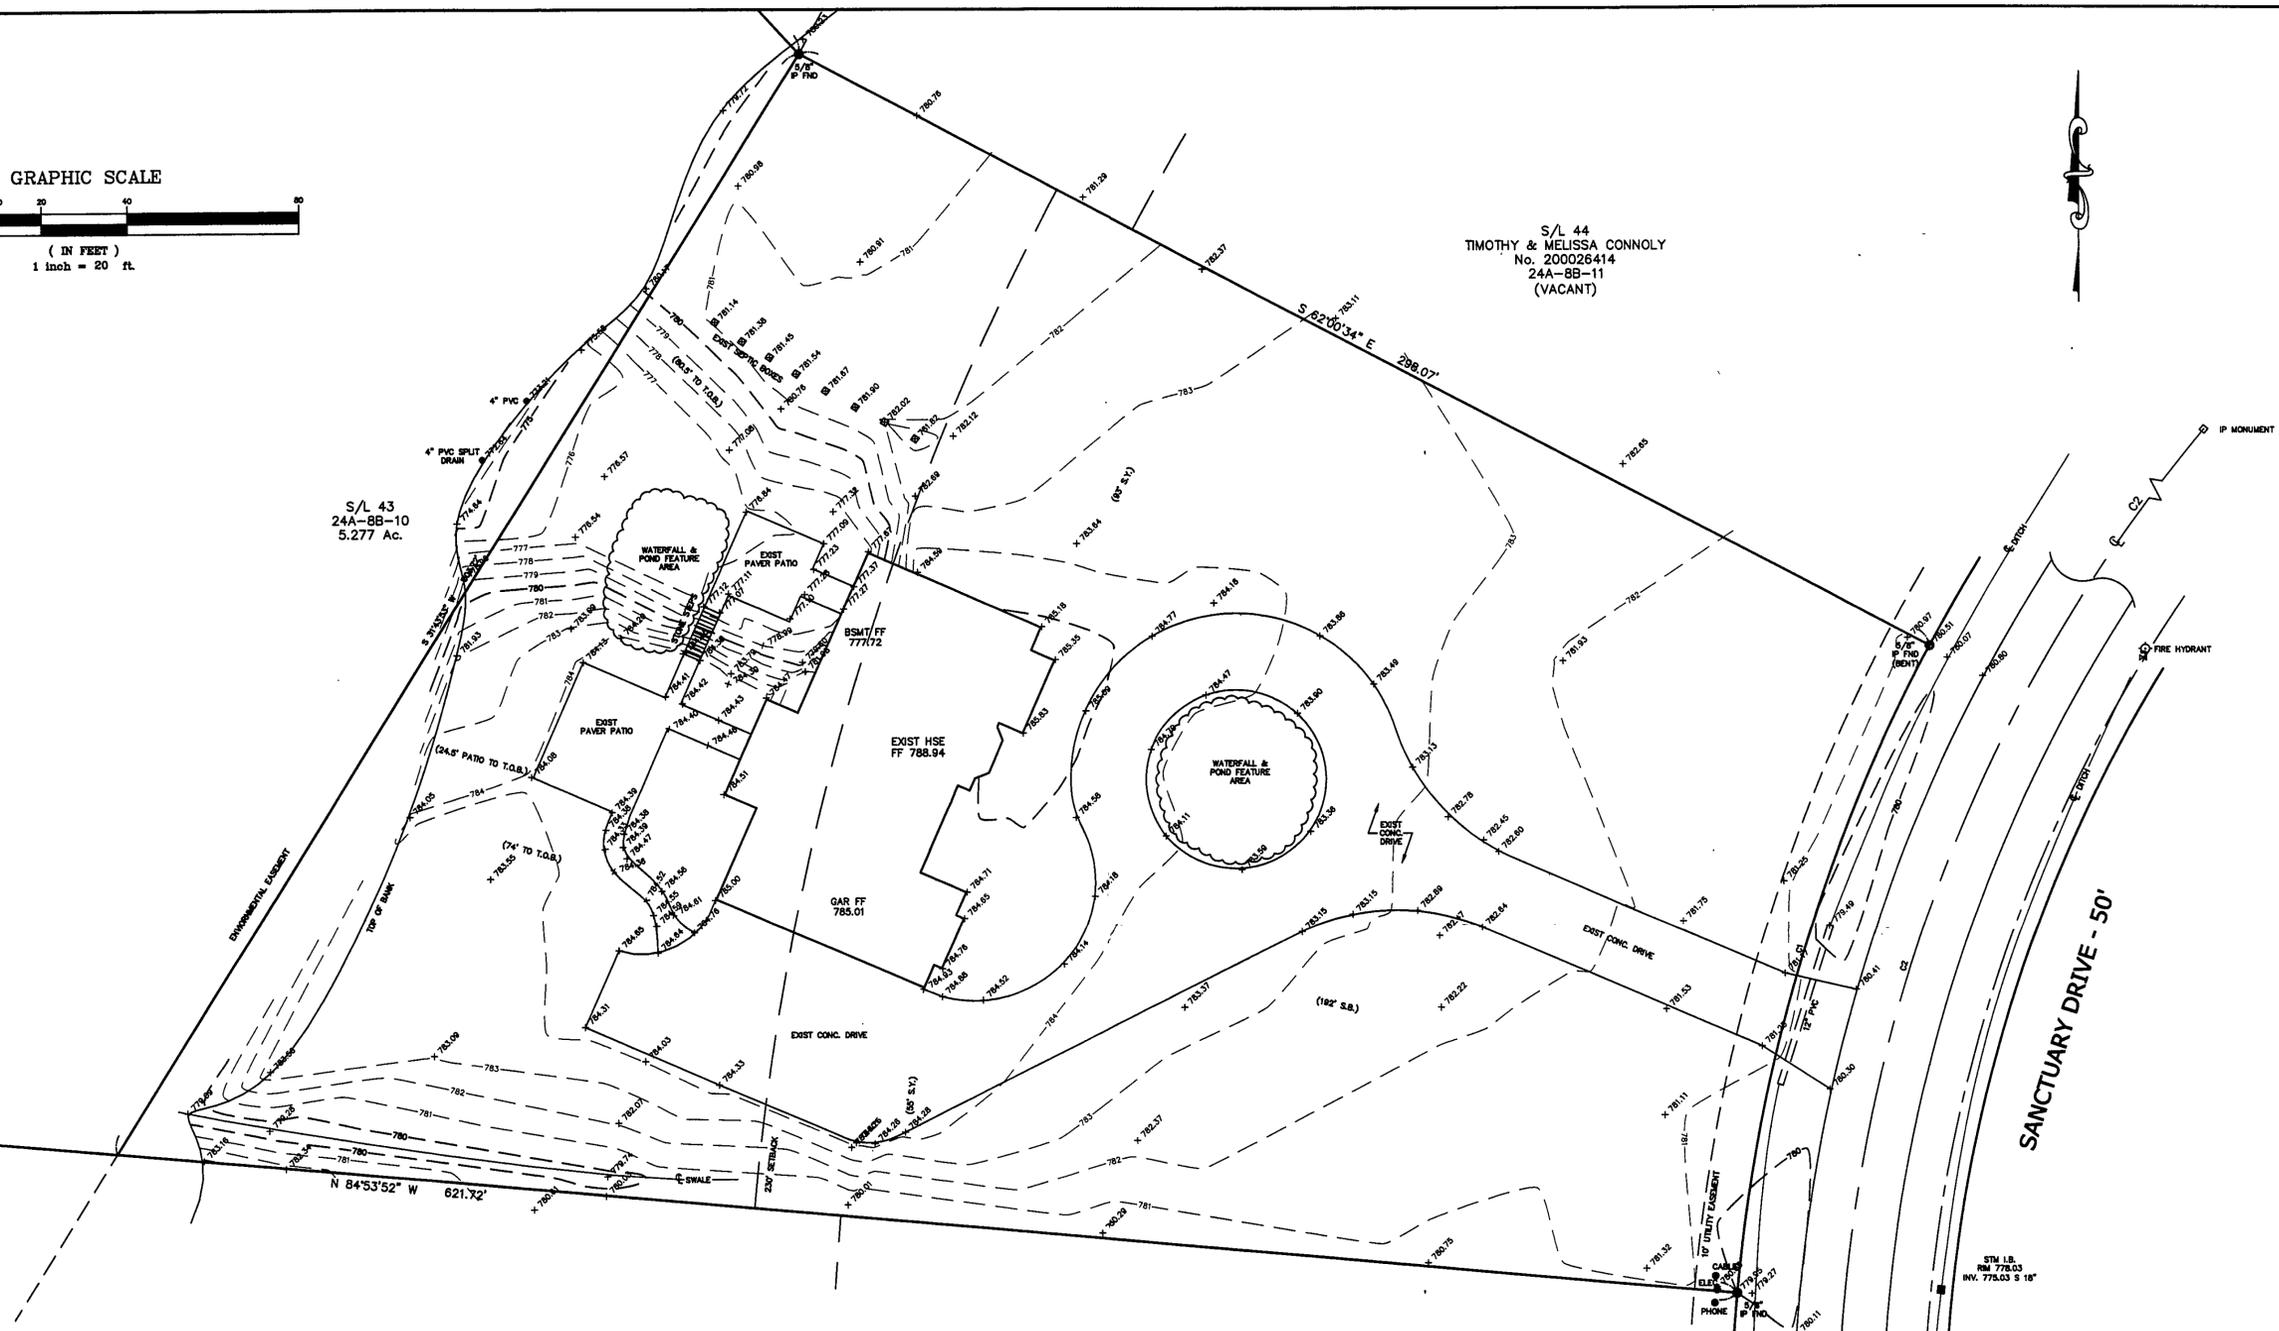

CURVE	LENGTH	RADIUS	TANGENT	CHORD	BEARING	DELTA
C1	159.79	400.00	80.98	158.73	S16°32'47\"/>	

S/L 42
CASH & ANDREA MISCHKA
No. 2006R019275
24A-BB-9

"AS BUILT" CERTIFICATION
I, HEREBY CERTIFY THAT THE GRADES ARE EXISTING
FINISH GRADES CHECKED IN THE FIELD ON Oct 20th, 2008
AND ARE CORRECT TO THE BEST OF MY KNOWLEDGE AND BELIEF.

TBM - IP MONUMENT
ELEV - 780.03

EXISTING UTILITIES NOTE:
THE SIZE AND LOCATION, BOTH HORIZONTAL AND VERTICAL
OF THE UNDERGROUND UTILITIES SHOWN HEREON, HAVE BEEN
OBTAINED BY A SEARCH OF AVAILABLE RECORDS.
VERIFICATION BY FIELD OBSERVATION HAS BEEN CONDUCTED
WHERE PRACTICAL. HOWEVER, BABCOCK, JONES AND ASSOCIATES
INC. DOES NOT GUARANTEE THE COMPLETENESS NOR ACCURACY
THEREOF.



REV. NO.	DESCRIPTION	DATE	BY	CHK'D
1	ADDED HOUSE & DRIVE	9/16/07	B.P.	H.J.
2	As Built	10/21/08	HJ	HJ

bj BABCOCK, JONES AND ASSOCIATES, INC
CIVIL ENGINEERS - SURVEYORS - LAND PLANNERS
PAINESVILLE OHIO 44077

DATE	10/27/08
DESIGN BY	H.J.
DRAWN BY	B.P.
APPROVED BY	H.J.
CREW CHIEF	W.B.

AS-BUILT
FOR
KERN BUILDING
S/L 43 SANCTUARY DRIVE (RIVER OAKS SUB)
KIRTLAND HILLS LAKE COUNTY STATE OF OHIO

SCALE	1"=20'
JOB NO	07-100-AB
SHEET	1 OF 1