

SITE PLAN

LERROY TOWNSHIP, LAKE COUNTY, OHIO

for: SHAMROCK CONSTRUCTION

CLIENT		OWNER	
ADDRESS	STREET	CITY	ZIP
GLENHAVEN Sub			
SUBDIVISION C-39	NAME	LOT	TRACT
VOL-PC		GROLED ROAD	PAGE
SUBLOT NO.	STREET	PERM. PARCEL NO.	STREET

LEGEND

SANITARY MANHOLE	---○---	EXIST. ELEV. → 100.0	100.0 = 2 PROP. ELEV.
STORM MANHOLE	---●---	AS BUILT ELEVATION	
INLET OR CATCH BASIN	---○---	INDICATES	
HYDRANT	---○---	DIRECTION OF	
EXISTING CONTOURS	---○---	SURFACE DRAINAGE	
PROPOSED CONTOURS	---○---		

REMARKS

ALL BOUNDARY DATA SHOWN WAS OBTAINED FROM (DEEDS, RECORDED SUBDIVISION PLAT OR OTHER PUBLIC RECORDS)
 LOCATIONS AS SHOWN OF ADJACENT WELLS AND SEPTIC TANKS OBTAINED FROM LAKE COUNTY HEALTH DEPARTMENT

DESIGN CERTIFICATION

THIS PLAT WAS PREPARED BY ME, AND IS CORRECT TO THE BEST OF MY KNOWLEDGE AND BELIEF.

Harry S. Jones, Jr. #6343
 NAME SURVEYOR REGISTRATION NO.

CHECK LIST

NO. OF BEDROOMS	WATER MAIN SIZE, LOCATION
DIMENSIONS	SAN. SEWER SIZE & GR. LOC.
BEARINGS	SAN. MH. CAST. ELEV. INV. ELEV.
TIE TO NEAREST STREET	SAN. CONN. SIZE, LOC. DEPTH
SUBLOT NO. PARCEL NO.	STORM SEWER SIZE & GR. LOC.
SURROUNDING OWNERS	STORM MH. CAST. ELEV. INV. ELEV.
BLDG. DIMENSIONS FIN GR.	PAV'T TYPE GRADE CURBS
BLDG. TIES FL'R. GRADES	GAS LINE LOC. SIZE PRESSURE
APRON TYPE WIDTH THICKNESS	SEPTIC TANK LOCATION & DUPLICATION AREA
SIDEWALK TYPE WIDTH THICKNESS	WELL LOCATION
CULVERT TYPE DIA., LENGTH	ISOLATION RADIUS FROM WELL
ROCK OUTCROPPINGS	

REVISIONS			PLAN PREPARED BY:		
NO.	DATE	BY	BABCOCK JONES & ASSOCIATES, INC.		
1			PAINESVILLE, OHIO		
2			DRAWN BY	TR.	SCALE 1"=40'
3			CHK'D.	H.J.	DATE 1/12/98
4			CREW CHIEF	K.J.	APP'D H.J.
5					PHONE NO. 218-357-1811
					DRAWING NO. 98-023-01

"AS BUILT" CERTIFICATION
 I, HEREBY CERTIFY THAT THE CIRCLED GRADES ARE EXISTING FINISH GRADES CHECKED IN THE FIELD ON _____, 19____, AND ARE CORRECT TO THE BEST OF MY KNOWLEDGE AND BELIEF.

REGISTERED SURVEYOR REG. NO.




REVIEWED AND ACCEPTED
 LAKE COUNTY GENERAL HEALTH DISTRICT
 Date 2-26-98 BY Daniel Lark
 See Note

TBM-TOP IRON PIPE 5/L1
 ELEV. 100.00

SEWAGE DISPOSAL PERMIT MUST BE OBTAINED BY A LAKE COUNTY LICENSED INSTALLER BEFORE INSTALLATION IS STARTED

#2504
 Zoning Inspector

"I, the undersigned hereby certify that this topographic map, showing 6", 1" or 2" contours, and elevations shown hereon represent an actual field survey made by me on the 17th day of FEB, 1998, and that the elevations were taken at appropriate intervals and that as of that date they existed as indicated hereon."
Harry S. Jones, Jr. #6343
 Name Reg. No.

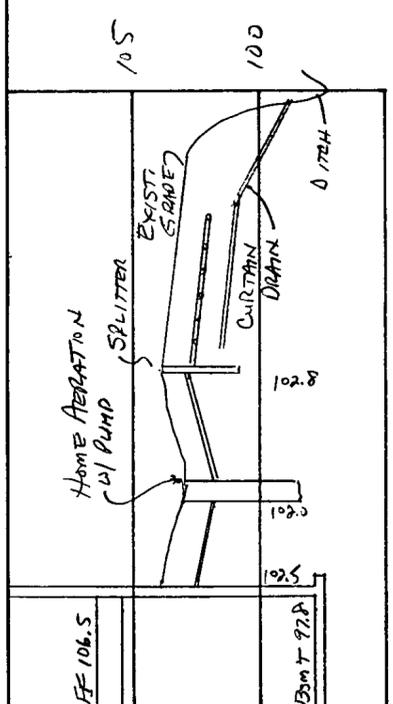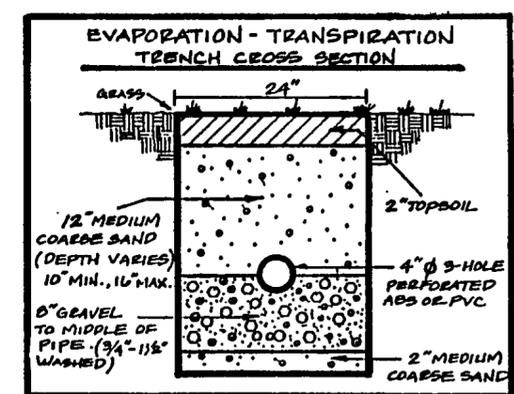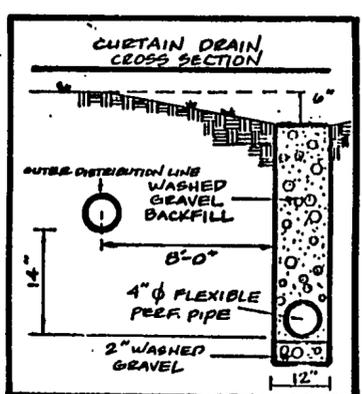

Grading Plan Approved as shown and/or noted
 THOMAS P. GILLES, P.E.
 Lake County Engineer
 By *THH* Date 3/12/98
 12" Drive Culvert
 minimum
 well must be 25' from Driveway
 well 50 ft.

