
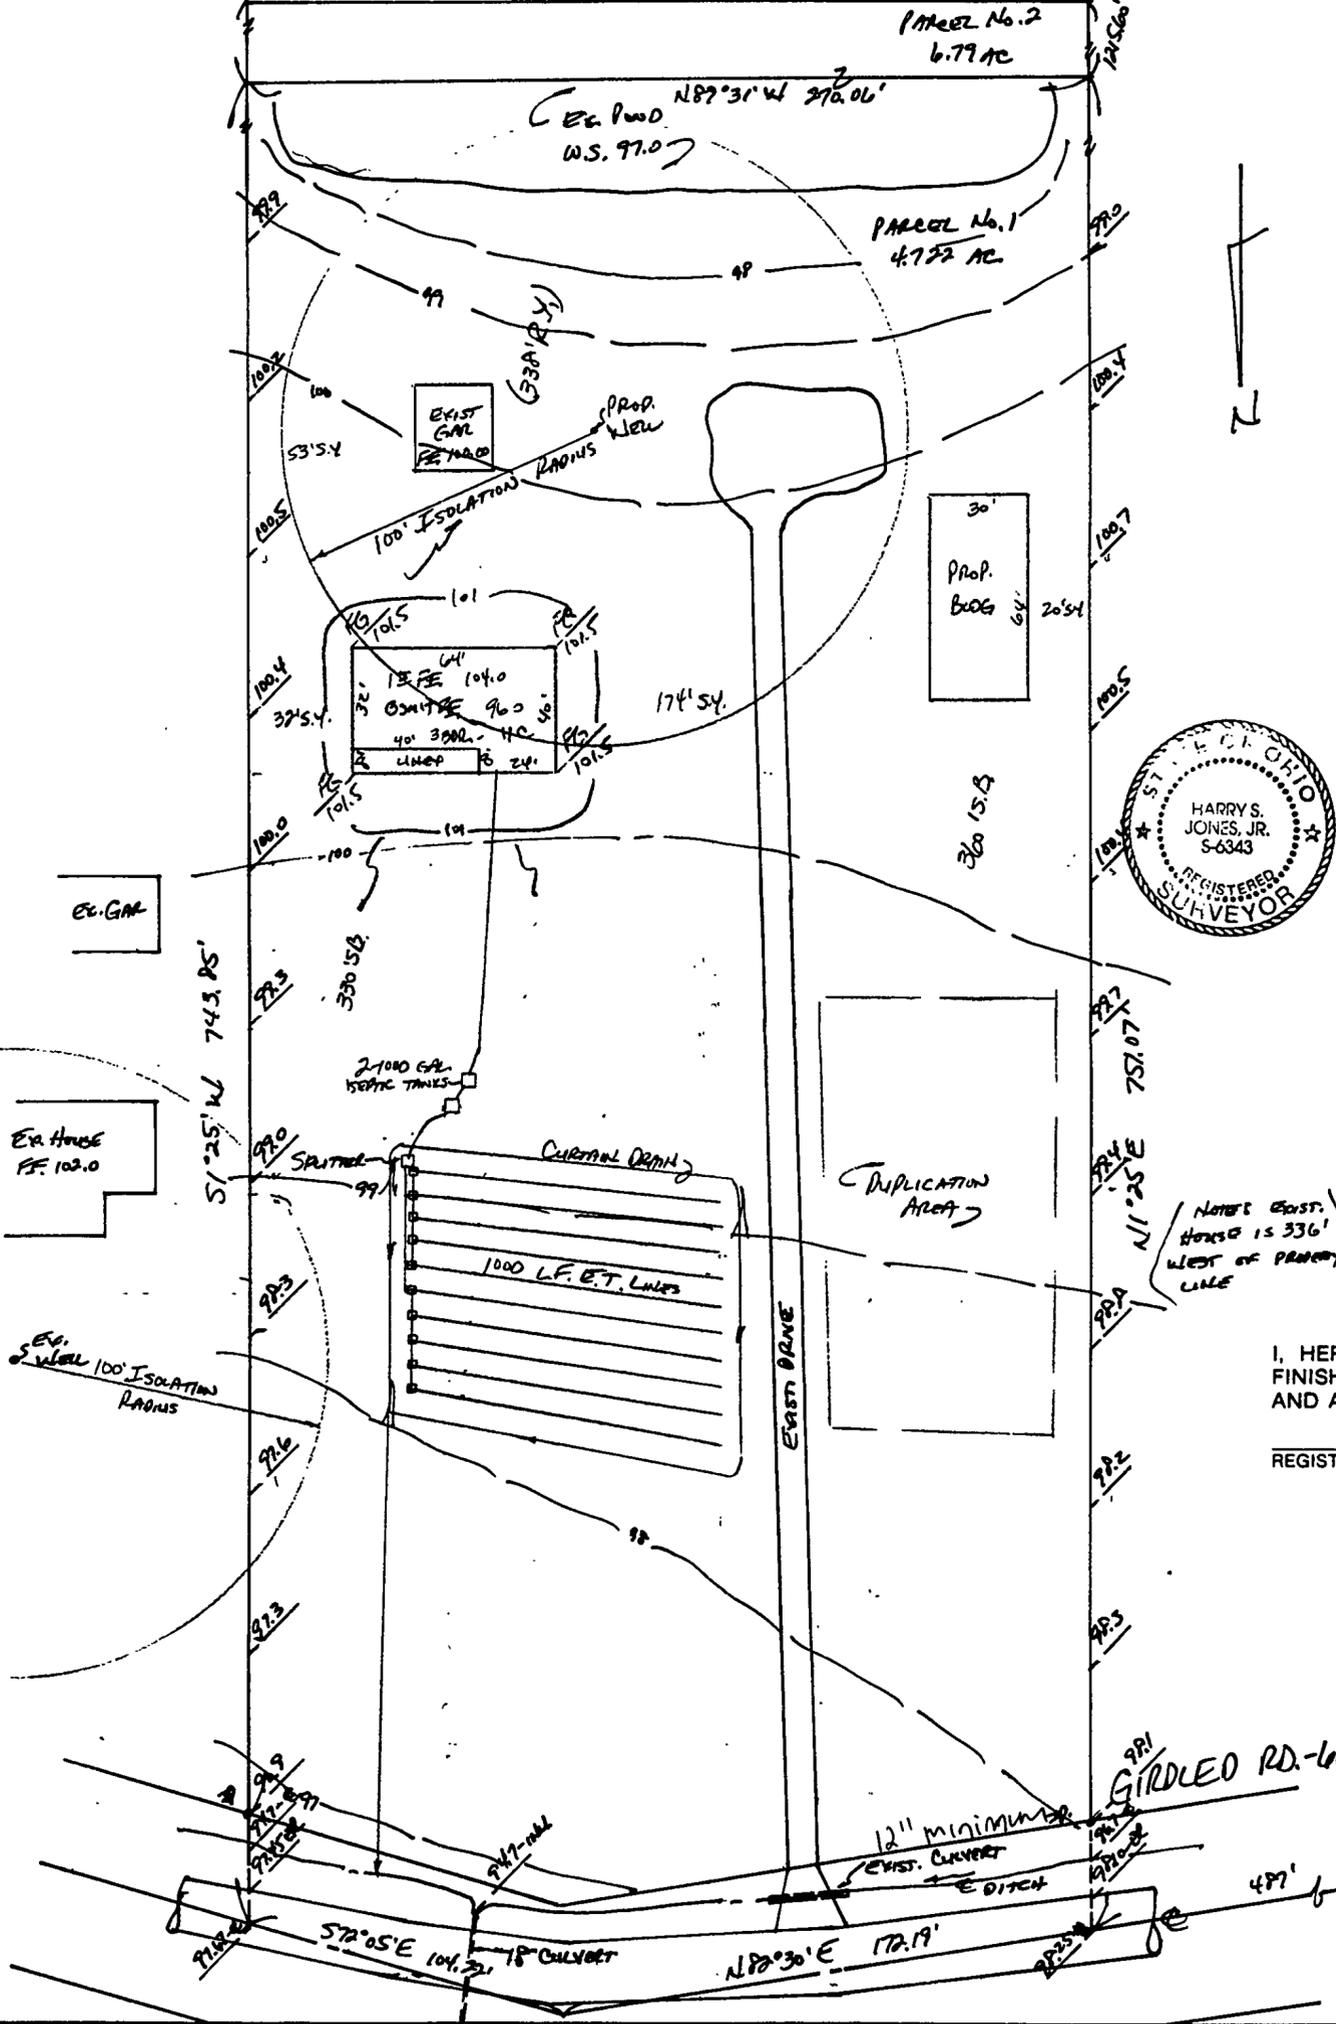


REVIEWED AND ACCEPTED
LAKE COUNTY GENERAL
HEALTH DISTRICT

Date: 5/25/98 BY: [Signature]

SEWAGE DISPOSAL PERMIT MUST BE
OBTAINED BY A LAKE COUNTY LICENSED
INSTALLER BEFORE INSTALLATION IS
STARTED

HYDRAULIC PROFILE
THREE V 1/4\"/>

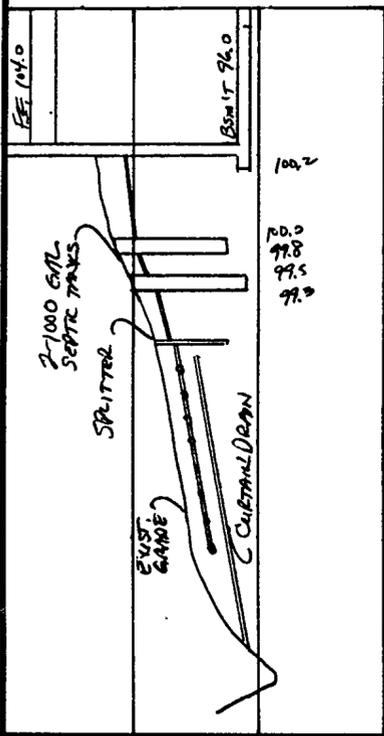

SITE PLAN
CONCORD TOWNSHIP, LAKE COUNTY, OHIO
for: KATHY CLARK 352-0196
CLIENT OWNER
4420 REDWOOD DR. PAINESVILLE
ADDRESS STREET CITY ZIP

SUBDIVISION	NAME	LOT	TRACT
		12	700
VOL. - PG.		905	
SUBLOT NO.	STREET	VOLUME	FILE
		79-1-14.15	GIRDLED RD.
		PERM. PARCEL NO.	STREET

LEGEND

SANITARY MANHOLE	-----○-----	WATER VALVE (GAS)	-----+-----
STORM MANHOLE	-----●-----	WATER METER (GAS)	-----M-----
INLET OR CATCH BASIN	-----□-----	AS BUILT ELEVATION	-----○-----
HYDRANT	-----◇-----	INDICATES DIRECTION OF SURFACE DRAINAGE	----->-----
EXISTING CONTOURS	-----○-----		
PROPOSED CONTOURS	-----○-----		
EXIST. ELEV.	-----○-----		
		100.0	
		100.0% PROP. ELEV.	

REMARKS

ALL BOUNDARY DATA SHOWN WAS OBTAINED FROM (DEEDS, RECORDED SUBDIVISION PLAT OR OTHER PUBLIC RECORDS)

LOCATIONS AS SHOWN OF ADJACENT WELLS AND SEPTIC TANKS OBTAINED FROM LAKE COUNTY HEALTH DEPARTMENT

DESIGN CERTIFICATION

THIS PLAT WAS PREPARED BY ME, AND IS CORRECT TO THE BEST OF MY KNOWLEDGE AND BELIEF.

NAME: [Signature] SURVEYOR REGISTRATION NO. 26343

CHECK LIST

NO. OF BEDROOMS	WATER MAIN SIZE, LOCATION
DIMENSIONS	SAN. SEWER SIZE % GR. LOC.
BEARINGS	SAN. MH. CAST. ELEV. INV. ELEV.
TIE TO NEAREST STREET	SAN. CONN. SIZE, LOC. DEPTH
SUBLOT NO. PARCEL NO.	STORM SEWER SIZE % GR. LOC.
SURROUNDING OWNERS	STORM MH. CAST. ELEV. INV. ELEV.
BLDG. DIMENSIONS FIN. GR.	PAVT TYPE GRADE CURBS
BLDG. TIES FLTR. GRADES	GAS LINE LOC. SIZE PRESSURE
APRON TYPE WIDTH THICKNESS	SEPTIC TANK LOCATION & DUPLICATION AREA
SIDEWALK TYPE WIDTH THICKNESS	WELL LOCATION
CULVERT TYPE DIA., LENGTH	ISOLATION RADIUS FROM WELL
ROCK OUTCROPPINGS	

REVISIONS

NO.	DATE	BY
1	6/17/98	HJG
2	5/15/98	HJG
3		
4		
5		

PLAN PREPARED BY:
BABCOCK • JONES & ASSOCIATES, INC.
PAINESVILLE, OHIO

DRAWN BY: HJG SCALE: 1" = 40' PHONE NO. 357-1811
CHK'D: HJG DATE: 5/14/98 DRAWING NO. 96-107
CREW CHIEF: LD APP'D: HJG

"AS BUILT" CERTIFICATION

I, HEREBY CERTIFY THAT THE CIRCLED GRADES ARE EXISTING FINISH GRADES CHECKED IN THE FIELD ON _____, 19____ AND ARE CORRECT TO THE BEST OF MY KNOWLEDGE AND BELIEF.

REGISTERED SURVEYOR _____ REG. NO. _____

TBM - Floor of EXIST. GARAGE FLOOR
ELEV. = 100.00
Grading Plan Approved as shown and/or noted
THOMAS P. GILLES, P.E.
Lake County Engineer

By: [Signature] Date: 6-1-98
"I, the undersigned hereby certify that this topography indicated by 6", 1" or 2" contours, and elevations shown hereon represent an actual field survey made by me on the 4th day of May, 1998 and that the elevations were taken at appropriate intervals and that as of that date they existed as indicated hereon."

Name: [Signature] Reg. No. 26343

