

SITE PLAN

WINDSOR, LAKE COUNTY, OHIO
 TOMNSHIP
FOR: WHELEED, INC.
 CLIENT
1536 CHERRY RD., WREGSVILLE OHIO
 ADDRESS CITY ZIP

Grading Plan Approved
 as shown and/or noted
 by THOMAS P. GILLES, P.E.
 Lake County Engineer
 Date 3.31.86

Wheleed's Sub.
 SUBDIVISION NAME Wheleed's Sub.
 VOL. 24 PAGE 24
 SUBLOT NO. 24 PERM. PARCEL NO. _____ STREET _____

LEGEND
 SANITARY MANHOLE (1)
 STORM MANHOLE (2)
 INLET OR CATCH BASIN (3)
 HYDRANT (4)
 EXISTING CONTOURS (5)
 PROPOSED CONTOURS (6)
 EXIST. ELEV. (7)
 PROP. ELEV. (8)
 WATER VALVE (GAS) (9)
 WATER METER (GAS) (10)
 AS BUILT ELEVATION (11)
 INDICATES DIRECTION OF SURFACE DRAINAGE (12)

REMARKS
 ALL BOUNDARY DATA SHOWN WAS OBTAINED FROM (DEEDS, RECORDED SUBDIVISION PLAT OR OTHER PUBLIC RECORDS)
 LOCATIONS AS SHOWN OF ADJACENT WELLS AND SEPTIC TANKS OBTAINED FROM LAKE COUNTY HEALTH DEPARTMENT

DESIGN CERTIFICATION
 THIS PLAT WAS PREPARED BY ME, AND IS CORRECT TO THE BEST OF MY KNOWLEDGE AND BELIEF.
 SURVEYOR REGISTRATION NO. 6343



CHECK LIST
 NO. OF BEARINGS DIMENSIONS
 TIE TO NEAREST STREET
 SUBLOT NO. PARCEL NO.
 SURROUNDING OWNERS
 BLDG. DIMENSIONS FIN. OR PAVED
 ASPHALT TYPE WIDTH THICKNESS
 SIDEWALK TYPE WIDTH THICKNESS
 SOLVENT TYPE DIA. LENGTH
 ROCK OUTCROPPINGS
 SIZE MAIN PIPE, LOCATION
 SAN. MAN. SIZE, INV. ELEV.
 STORM MAN. SIZE, INV. ELEV.
 STORM MAN. SIZE, GR. LOC.
 PAVT. TYPE GRADE CURVES
 GAS LINE LOC. SIZE PRESSURE
 SEPTIC TANK LOCATION & DUPLICATION AREA
 WELL LOCATION
 ISOLATION RADIUS FROM WELL


PLAN PREPARED BY: **BABCOCK • JONES & ASSOCIATES, INC.**
 PAINESVILLE, OHIO

NO.	DATE	BY	SCALE	PHONE NO.
1			1" = 20'	357-1811
2				
3				
4				
5				

DRAWN BY: HJ DATE: 1/24/86 DRAWING NO.: BS-120-24
 CHK'D. BY: HJ APP'D. BY: HJ

"AS BUILT" CERTIFICATION
 I HEREBY CERTIFY THAT THE CIRCLED GRADES ARE EXISTING FINISH GRADES CHECKED IN THE FIELD ON 19 AND ARE CORRECT TO THE BEST OF MY KNOWLEDGE AND BELIEF.

REGISTERED SURVEYOR REG. NO. _____

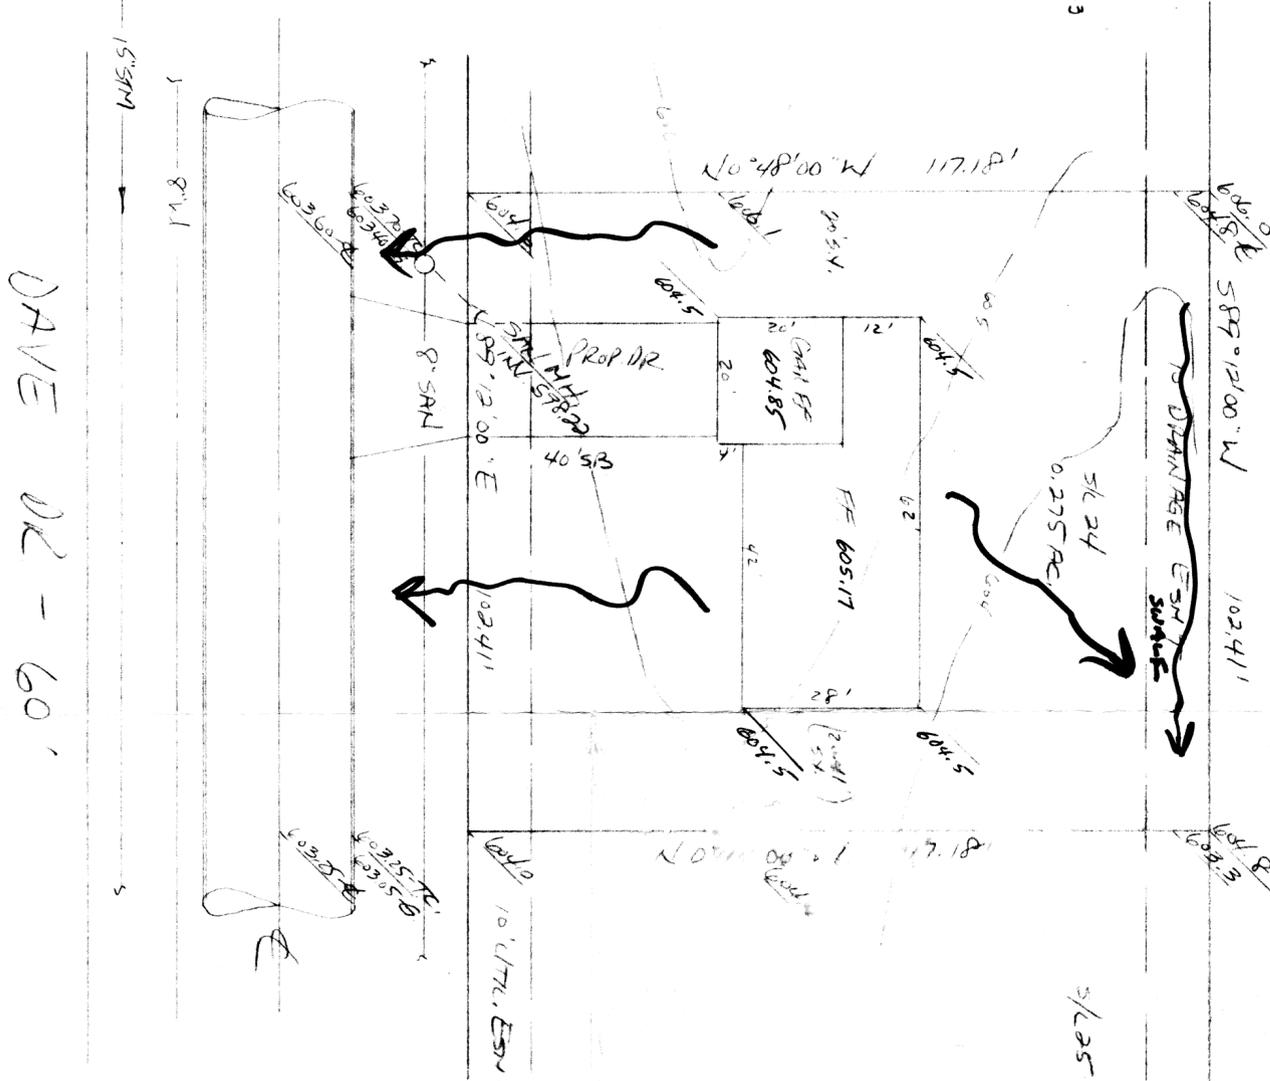

DAVE OR - 60'

MADISON
 200 E 106th St.
 Painesville, OH 44061