


Temporary Seeding Species Selection			
Seeding Dates	Species	Lb./1,000 ft. ²	Per Ac.
March 1 to August 15	Oats	3	4 bushel
	Tall Fescue	1	40 lb.
	Annual Ryegrass	1	40 lb.
August 16 to November 1	Perennial Ryegrass	1	40 lb.
	Tall Fescue	1	40 lb.
	Annual Ryegrass	1	40 lb.
November 1 to Spring Seeding	Rye	3	2 bushel
	Tall Fescue	1	40 lb.
	Annual Ryegrass	1	40 lb.
November 1 to Spring Seeding	Wheat	3	2 bushel
	Tall Fescue	1	40 lb.
	Annual Ryegrass	1	40 lb.
November 1 to Spring Seeding	Perennial Ryegrass	1	40 lb.
	Tall Fescue	1	40 lb.
	Annual Ryegrass	1	40 lb.

Note: Other approved seed sources may be substituted.

"I, the undersigned hereby certify that this topography indicated by 6", 1", or 2" contours, and elevations shown hereon represent an actual field survey made by me on the 27th day of Jan., 2004 and that the elevations were taken at appropriate intervals and that as of that date they existed as indicated hereon."

Harry Jones +6343
Name Reg. No.

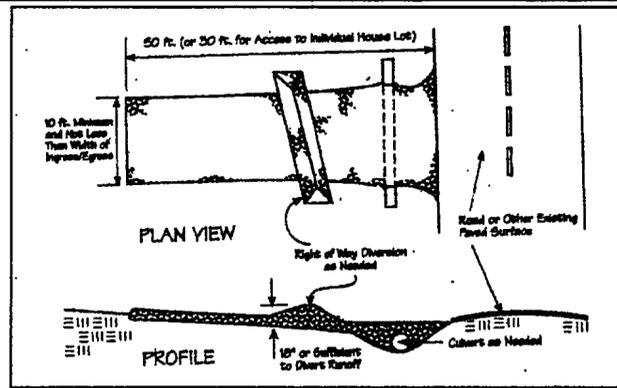

SITE PLAN
MADISON TOWNSHIP LAKE COUNTY, OHIO
for: **CAPUTO**
CLIENT _____ OWNER _____
ADDRESS _____ STREET _____ CITY _____ ZIP _____

WINDJAMMER SUB.
SUBDIVISION **33-15** NAME _____ TRACT _____ STREET _____
50 VOL.-Pg. **FISHERMANS TRAIL** LOT _____
SUBLOT NO. _____ STREET _____ VOL.-Pg. _____ PERM. PARCEL NO. _____

LEGEND

SANITARY MANHOLE	---○---	EXIST. ELEV. - 5'-100.0
STORM MANHOLE	---●---	100.0 ± 2' PROP. ELEV.
INLET OR CATCH BASIN	---□---	AS BUILT ELEVATION
HYDRANT	---◇---	INDICATES DIRECTION OF SURFACE DRAINAGE
EXISTING CONTOURS	--- ---	
PROPOSED CONTOURS	--- ---	

REMARKS
ALL BOUNDARY DATA SHOWN WAS OBTAINED FROM (DEEDS, RECORDED SUBDIVISION PLAT OR OTHER PUBLIC RECORDS)
LOCATIONS AS SHOWN OF ADJACENT WELLS AND SEPTIC TANKS OBTAINED FROM LAKE COUNTY HEALTH DEPARTMENT

DESIGN CERTIFICATION
THIS PLAT WAS PREPARED BY ME, AND IS CORRECT TO THE BEST OF MY KNOWLEDGE AND BELIEF.
Harry Jones +6343
NAME SURVEYOR REGISTRATION NO.

CHECK LIST

NO. OF BEDROOMS	_____	WATER MAIN SIZE, LOCATION	_____
DIMENSIONS	_____	SAN. SEWER SIZE & GR. LOC.	_____
BEARINGS	_____	SAN. MH. CAST. ELEV. INV. ELEV.	_____
TIE TO NEAREST STREET	_____	SAN. CONN. SIZE, LOC. DEPTH	_____
SUBLOT NO. PARCEL NO.	_____	STORM SEWER SIZE & GR. LOC.	_____
SURROUNDING OWNERS	_____	STORM MH. CAST. ELEV. INV. ELEV.	_____
BLDG. DIMENSIONS FIN GR.	_____	PAV'T TYPE GRADE CURBS	_____
BLDG. TIES FL'R. GRADES	_____	GAS LINE LOC. SIZE PRESSURE	_____
APRON TYPE WIDTH THICKNESS	_____	SEPTIC TANK LOCATION & DUPLICATION AREA	_____
SIDEWALK TYPE WIDTH THICKNESS	_____	WELL LOCATION	_____
CULVERT TYPE DIA. LENGTH	_____	ISOLATION RADIUS FROM WELL	_____
ROCK OUTCROPPINGS	_____		

REVISIONS

NO.	DATE	BY
1		
2		
3		
4		
5		

PLAN PREPARED BY:
BABCOCK · JONES & ASSOCIATES, INC.
PAINESVILLE, OHIO

DRAWN BY	N.S.	SCALE	1" = 20'	PHONE NO.	440-367-1811
CHK'D.	H.J.	DATE	1/30/04	DRAWING NO.	97-268-50
CHK'D.	E.W.H.	APP'D	H.J.		



"AS BUILT" CERTIFICATION
I, HEREBY CERTIFY THAT THE CIRCLED GRADES ARE EXISTING FINISH GRADES CHECKED IN THE FIELD ON _____, 20____ AND ARE CORRECT TO THE BEST OF MY KNOWLEDGE AND BELIEF.

REGISTERED SURVEYOR _____ REG. NO. _____

BM SANITARY MANHOLE
ELEV-633.23

CURVE	LENGTH	RADIUS	CHORD	BEARING	DELTA
C1	71.82	230.00	71.53	N33°58'53"W	17°53'27"

EXISTING UTILITIES NOTE:
THE SIZE AND LOCATION, BOTH HORIZONTAL AND VERTICAL OF THE UNDERGROUND UTILITIES SHOWN HEREON, HAVE BEEN OBTAINED BY A SEARCH OF AVAILABLE RECORDS. VERIFICATION BY FIELD OBSERVATION HAS BEEN CONDUCTED WHERE PRACTICAL, HOWEVER, BABCOCK, JONES AND ASSOCIATES INC. DOES NOT GUARANTEE THE COMPLETENESS NOR ACCURACY THEREOF.

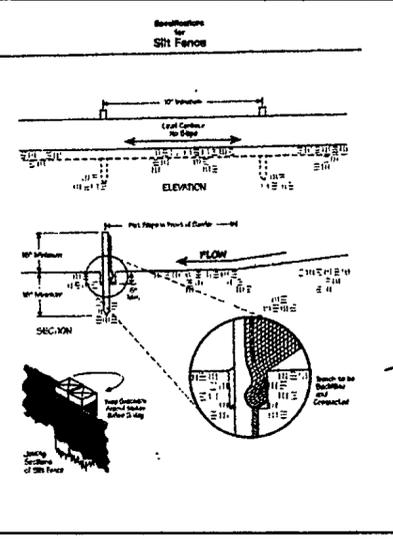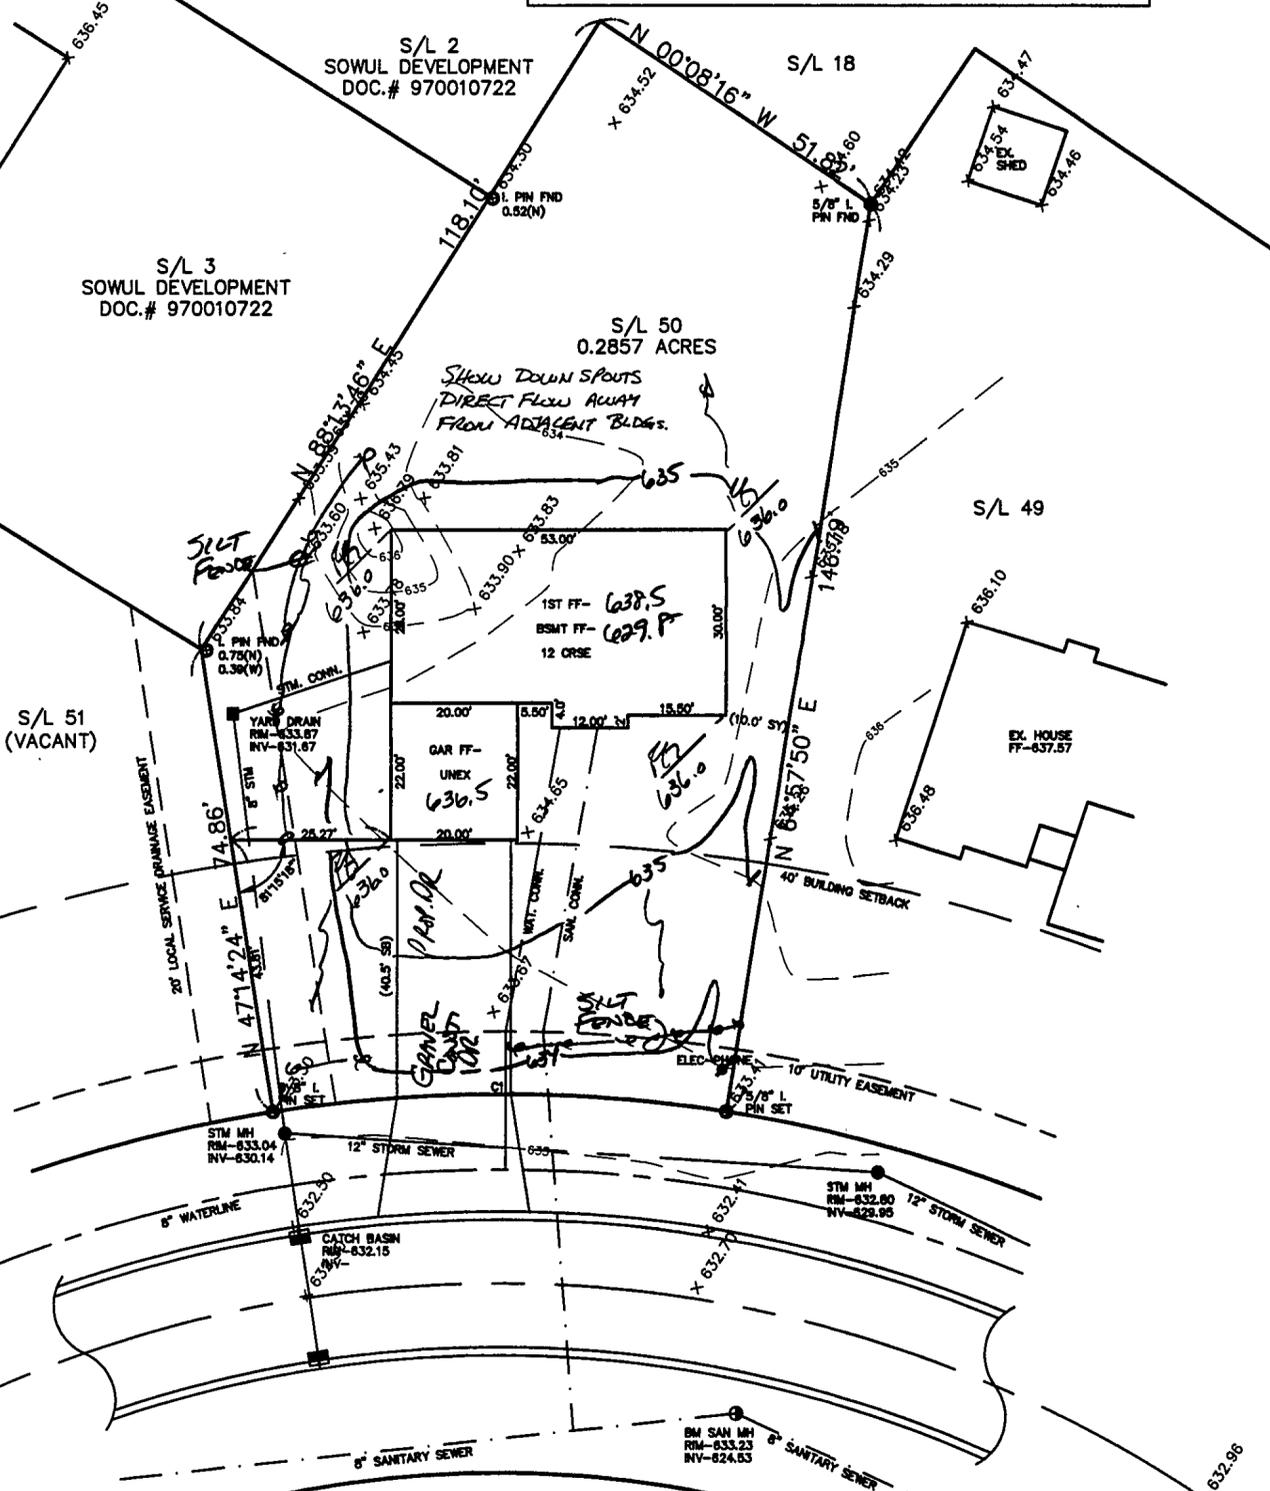

Subject to approval by: TOP OF HYD. ELEV-633.67

- Zoning Department
- LC General Health District
- LC Soil & Water Conservation District
- LC Building Department (final approval)

Stormwater Management Plan
Approved as shown and/or noted
JAMES R. GILLS, P.E.
County Drainage Engineer
By L.S. Date 2/10/04

ROOF DRAINS SHALL DISCHARGE TO SPLASH BLOCKS.
FISHERMANS TRAIL - 60'

UNLESS DISCHARGE FLOWS INTO DETENTION POND WITH WAVER QUALITY FEATURES

APPROVED
MADISON TOWNSHIP ZONING
DATE 2/9/04
BY JK 21671