




* R = 60.00'
 L = 54.03'
 T = 29.00'
 C = 52.22'
 Δ = 51°35'40"
 N 54°08'55" E

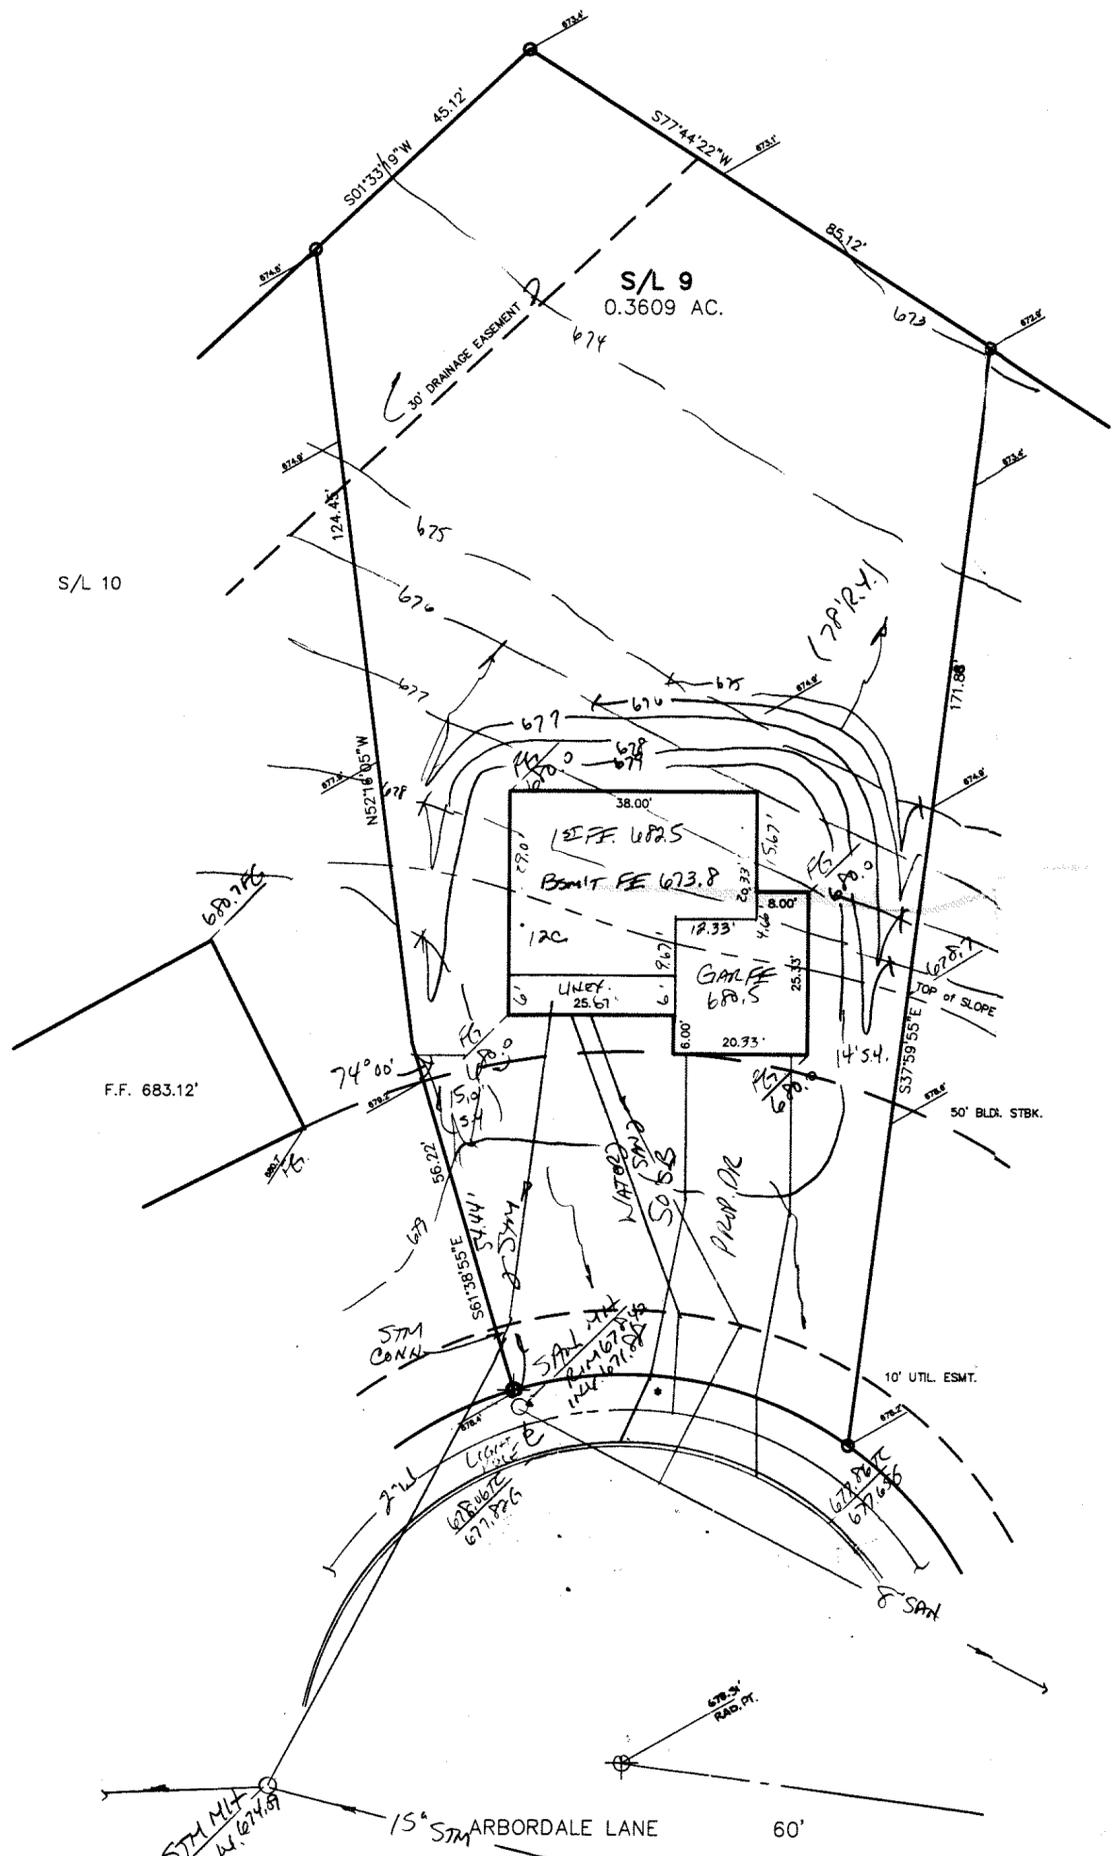

SITE PLAN

PAINESVILLE TWP., LAKE COUNTY, OHIO

for: **SHAMROCK CONSTRUCTION**

CLIENT _____ OWNER _____
 ADDRESS _____ STREET _____ CITY _____ ZIP _____

BRIARWOOD FARMS			
SUBDIVISION	29-22	NAME	LOT
9		VOL. PG.	TRACT
		ARBORDALE LN	VOLUME
SUBLOT NO.		STREET	PERM. PARCEL NO.
			STREET

LEGEND

SANITARY MANHOLE	---●---	EXIST. ELEV. → 100.0	100.0 ← PROP. ELEV.
STORM MANHOLE	---●---	AS BUILT ELEVATION	
INLET OR CATCH BASIN	---■---	INDICATES DIRECTION OF SURFACE DRAINAGE	
HYDRANT	---○---	100.0	
EXISTING CONTOURS	---○---		
PROPOSED CONTOURS	---○---		

REMARKS

ALL BOUNDARY DATA SHOWN WAS OBTAINED FROM (DEEDS, RECORDED SUBDIVISION PLAT OR OTHER PUBLIC RECORDS)
 LOCATIONS AS SHOWN OF ADJACENT WELLS AND SEPTIC TANKS OBTAINED FROM LAKE COUNTY HEALTH DEPARTMENT

DESIGN CERTIFICATION

THIS PLAT WAS PREPARED BY ME, AND IS CORRECT TO THE BEST OF MY KNOWLEDGE AND BELIEF.

NAME Harry S. Jones, Jr. #6343
 SURVEYOR REGISTRATION NO.

CHECK LIST

NO. OF BEDROOMS	WATER MAIN SIZE, LOCATION
DIMENSIONS	SAN. SEWER SIZE % GR. LOC.
BEARINGS	SAN. MH. CAST. ELEV. INV. ELEV.
TIE TO NEAREST STREET	SAN. CONN. SIZE, LOC. DEPTH
SUBLOT NO. PARCEL NO.	STORM SEWER SIZE % GR. LOC.
SURROUNDING OWNERS	STORM MH. CAST. ELEV. INV. ELEV.
BLDG. DIMENSIONS FIN GR.	PAV'T TYPE GRADE CURBS
BLDG. TIES FL'R. GRADES	GAS LINE LOC. SIZE PRESSURE
APRON TYPE WIDTH THICKNESS	SEPTIC TANK LOCATION & DUPLICATION AREA
SIDEWALK TYPE WIDTH THICKNESS	WELL LOCATION
CULVERT TYPE DIA., LENGTH	ISOLATION RADIUS FROM WELL
ROCK OUTCROPPINGS	

REVISIONS

NO.	DATE	BY
1		
2		
3		
4		
5		

PLAN PREPARED BY:
bj BABCOCK · JONES & ASSOCIATES, INC.
 PAINESVILLE, OHIO

DRAWN BY M.S. SCALE 1"=20' PHONE NO. 216-357-1811
 CHK'D. HJT DATE 9-22-97 DRAWING NO. 97-070-09
 CREW CHIEF KJ APP'D HJT

"AS BUILT" CERTIFICATION
 I, HEREBY CERTIFY THAT THE CIRCLED GRADES ARE EXISTING FINISH GRADES CHECKED IN THE FIELD ON _____, 19____ AND ARE CORRECT TO THE BEST OF MY KNOWLEDGE AND BELIEF.

REGISTERED SURVEYOR _____ REG. NO. _____

TBM - Rim SAN. M.H. S/L 9 & S/L 10
 Elev. = 678.42

Grading Plan Approved
 as shown and/or noted
THOMAS P. GILLES, P.E.
 Lake County Engineer

By GJH Date 10.6.97

APPROVED
 PAINESVILLE TOWNSHIP
 ZONING DEPARTMENT
P19970254
D Rust