

PAINESVILLE TOWNSHIP, LAKE COUNTY, OHIO

for: MALKAMALKI HOMES

CLIENT	OWNER
ADDRESS	STREET CITY ZIP
HEATHERSTONE	
SUBDIVISION	NAME LOT TRACT
81	VOL.-PG. BOWDOIN CRT. VOLUME PAGE
SUBLOT NO.	STREET PERM. PARCEL NO. STREET

**LEGEND**

SANITARY MANHOLE	---●---	EXIST. ELEV. → 100.0	PROF. ELEV. ← 100.0
STORM MANHOLE	---●---		
INLET OR CATCH BASIN	---■---	AS BUILT ELEVATION	
HYDRANT	---○---	INDICATES DIRECTION OF SURFACE DRAINAGE	
EXISTING CONTOURS	---○---		
PROPOSED CONTOURS	---○---		

**REMARKS**

ALL BOUNDARY DATA SHOWN WAS OBTAINED FROM (DEEDS, RECORDED SUBDIVISION PLAT OR OTHER PUBLIC RECORDS).

LOCATIONS AS SHOWN OF ADJACENT WELLS AND SEPTIC TANKS OBTAINED FROM LAKE COUNTY HEALTH DEPARTMENT

**DESIGN CERTIFICATION**

THIS PLAT WAS PREPARED BY ME, AND IS CORRECT TO THE BEST OF MY KNOWLEDGE AND BELIEF.

*Harry S. Jones, Jr.* #4343

NAME SURVEYOR REGISTRATION NO.

**CHECK LIST**

NO. OF BEDROOMS	WATER MAIN SIZE, LOCATION
DIMENSIONS	SAN. SEWER SIZE % GR. LOC.
BEARINGS	SAN. MH. CAST. ELEV. INV. ELEV.
TIE TO NEAREST STREET	SAN. CONN. SIZE, LOC. DEPTH
SUBLOT NO. PARCEL NO.	STORM SEWER SIZE % GR. LOC.
SURROUNDING OWNERS	STORM MH. CAST. ELEV. INV. ELEV.
BLDG. DIMENSIONS FIN GR.	PAV'T TYPE GRADE CURBS
BLDG. TIES FL'R. GRADES	GAS LINE LOC. SIZE PRESSURE
APRON TYPE WIDTH THICKNESS	SEPTIC TANK LOCATION & DUPLICATION AREA
SIDEWALK TYPE WIDTH THICKNESS	WELL LOCATION
CULVERT TYPE DIA., LENGTH	ISOLATION RADIUS FROM WELL
ROCK OUTCROPPINGS	

REVISIONS			PLAN PREPARED BY:		
NO.	DATE	BY	Bj BABCOCK · JONES & ASSOCIATES, INC.		
1			PAINESVILLE, OHIO		
2			DRAWN BY	SCALE	PHONE NO.
3			T.R.	1" = 20'	218-357-1811
4			CHR'D.	DATE	DRAWING NO.
5			H.J.	1/17/98	92-186-81
			CREW CHIEF	APP'D	
			W.B.	H.J.	

**"AS BUILT" CERTIFICATION:**

I, HEREBY CERTIFY THAT THE CIRCLED GRADES ARE EXISTING FINISH GRADES CHECKED IN THE FIELD ON \_\_\_\_\_, 19\_\_\_\_ AND ARE CORRECT TO THE BEST OF MY KNOWLEDGE AND BELIEF.


REGISTERED SURVEYOR REG. NO.

TBM-SAN. MH. RIM  
ELEV. = 709.77

Δ = 38° 21' 30"  
R = 65.00'  
L = 43.52'  
C = 42.71'  
N.41° 57' 57" E.

APPROVED  
PAINESVILLE TOWNSHIP  
ZONING DEPARTMENT

*[Signature]*

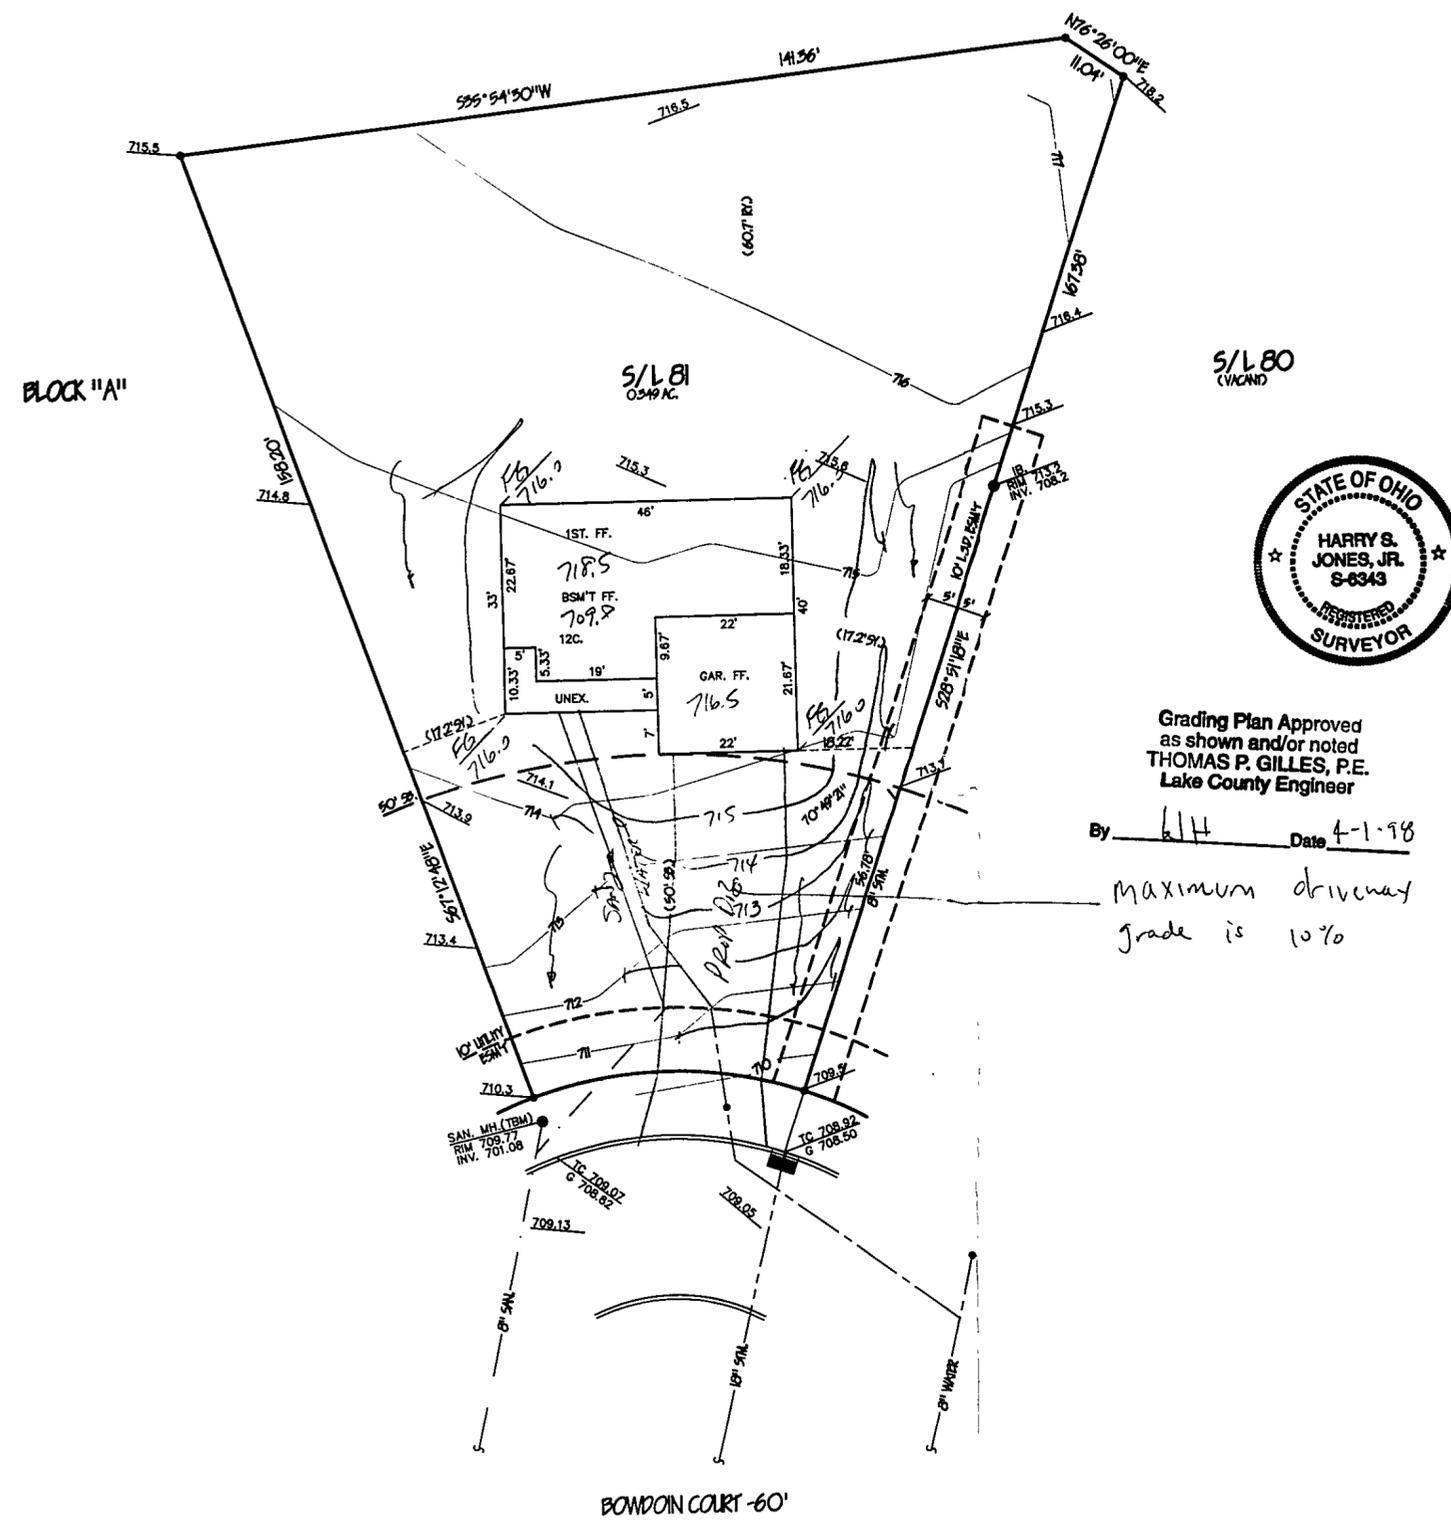

Grading Plan Approved  
as shown and/or noted  
THOMAS P. GILLES, P.E.  
Lake County Engineer

By GH Date 4-1-98

Maximum driveway  
grade is 10%

BOWDOIN COURT - 60'