


"I, the undersigned hereby certify that this topography indicated by 6", 1', or 2' contours, and elevations shown hereon represent an actual field survey made by me on the 3rd day of March, 2003 and that the elevations were taken at appropriate intervals and that as of that date they existed as indicated hereon."

Harry Jones
Name Harry Jones Reg. No. #6343

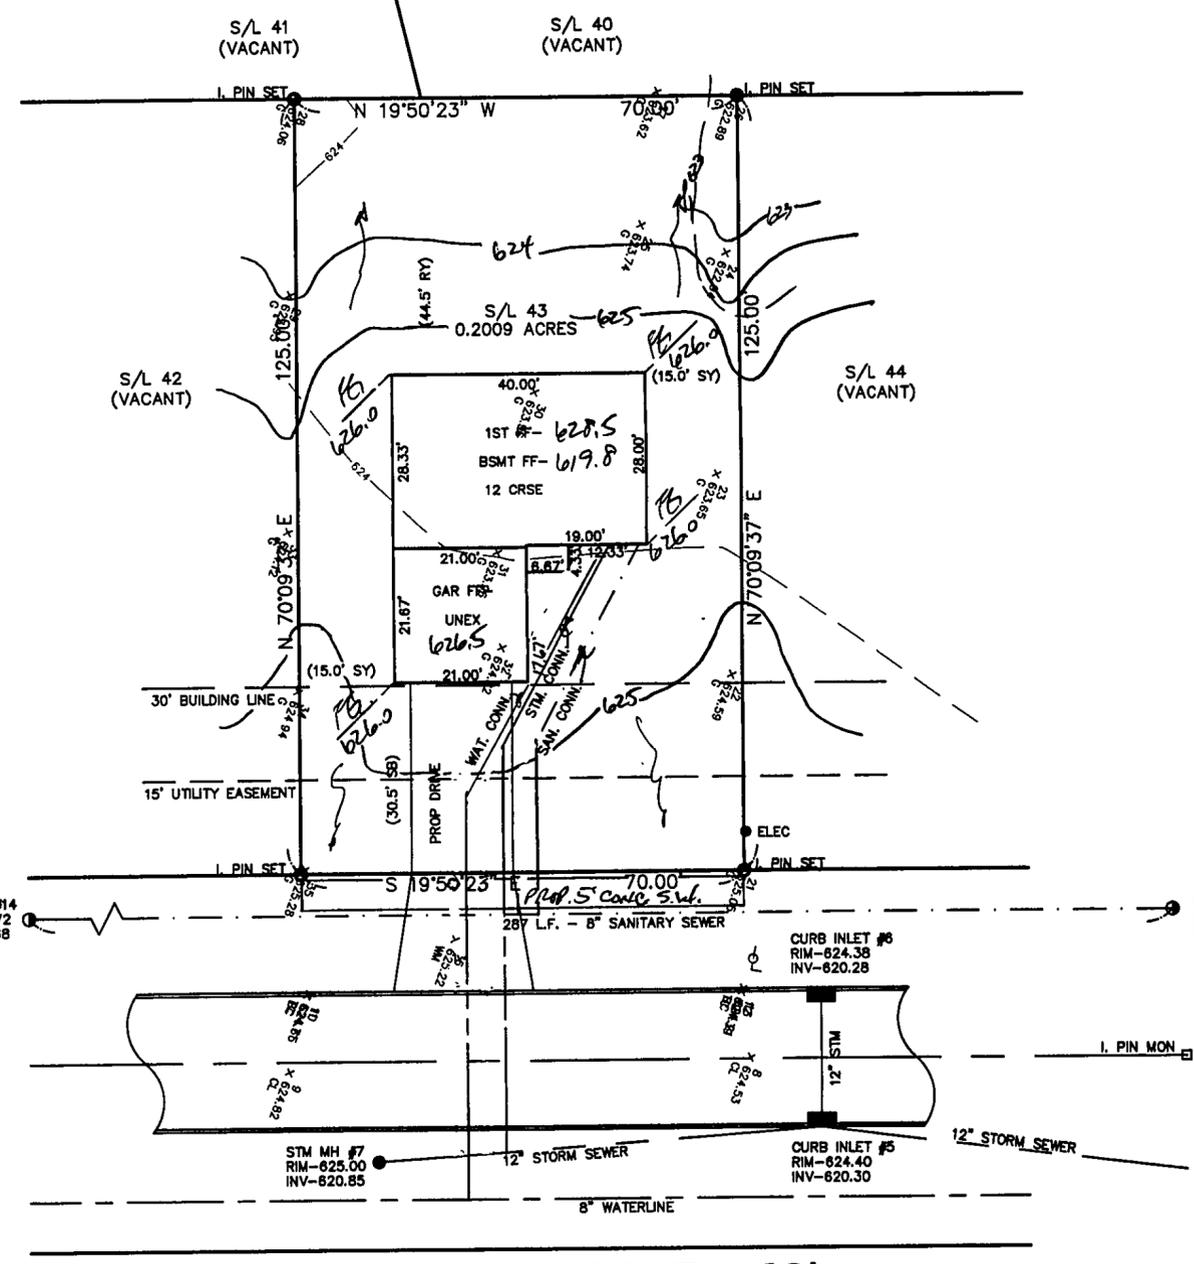

PEBBLE BEACH COVE - 60'

NOTE: ALL IRON PINS SET ARE 5/8" X 30" AND CAPPED
BABCOCK, JONES & ASSOC.

APPROVED
PAINESVILLE TOWNSHIP
ENGINEERING DEPARTMENT
2003051
W. Rust

SITE PLAN
PAINESVILLE TWP., LAKE COUNTY, OHIO
for: **WILSHIRE HOMES**

CLIENT _____ OWNER _____
ADDRESS _____ STREET _____ CITY _____ ZIP _____
LAKE ERIE SHORES
SUBDIVISION 42-25 NAME _____ TRACT _____ STREET _____
43 VOL.-PG. _____ LOT _____
SUBLOT NO. _____ STREET _____ VOL.-PG. _____ PERM. PARCEL NO. _____

LEGEND
SANITARY MANHOLE --- ○ --- EXIST. ELEV. 100.0 PROP. ELEV. 100.0
STORM MANHOLE --- ○ --- AS BUILT ELEVATION
INLET OR CATCH BASIN --- ○ --- INDICATES DIRECTION OF SURFACE DRAINAGE
HYDRANT --- ○ ---
EXISTING CONTOURS --- - - - -
PROPOSED CONTOURS --- ————

REMARKS
ALL BOUNDARY DATA SHOWN WAS OBTAINED FROM (DEEDS, RECORDED SUBDIVISION PLAT OR OTHER PUBLIC RECORDS)
LOCATIONS AS SHOWN OF ADJACENT WELLS AND SEPTIC TANKS OBTAINED FROM LAKE COUNTY HEALTH DEPARTMENT

DESIGN CERTIFICATION
THIS PLAT WAS PREPARED BY ME, AND IS CORRECT TO THE BEST OF MY KNOWLEDGE AND BELIEF.
Harry Jones #6343
NAME SURVEYOR REGISTRATION NO.

CHECK LIST

NO. OF BEDROOMS	WATER MAIN SIZE, LOCATION
DIMENSIONS	SAN. SEWER SIZE & GR. LOC.
BEARINGS	SAN. MH. CAST. ELEV. INV. ELEV.
TIE TO NEAREST STREET	SAN. CONN. SIZE, LOC. DEPTH
SUBLOT NO. PARCEL NO.	STORM SEWER SIZE & GR. LOC.
SURROUNDING OWNERS	STORM MH. CAST ELEV. INV. ELEV.
BLDG. DIMENSIONS FIN GR.	PAVT TYPE GRADE CURBS
BLDG. TIES FL'R. GRADES	GAS LINE LOC. SIZE PRESSURE
APRON TYPE WIDTH THICKNESS	SEPTIC TANK LOCATION & DUPLICATION AREA
SIDEWALK TYPE WIDTH THICKNESS	WELL LOCATION
CULVERT TYPE DIA., LENGTH	ISOLATION RADIUS FROM WELL
ROCK OUTCROPPINGS	

REVISIONS			PLAN PREPARED BY:		
NO.	DATE	BY	BABCOCK · JONES & ASSOCIATES, INC.		
1			PAINESVILLE, OHIO		
2			DRAWN BY	N.S.	SCALE 1" = 20"
3			CHK'D.	H.J.	DATE 3/5/03
4			CREW CHIEF	W.B.	APP'D H.J.
5			PHONE NO.	440-357-1811	DRAWING NO.
					02-008-43

"AS BUILT" CERTIFICATION
I, HEREBY CERTIFY THAT THE CIRCLED GRADES ARE EXISTING FINISH GRADES CHECKED IN THE FIELD ON 3/5/03, 2003 AND ARE CORRECT TO THE BEST OF MY KNOWLEDGE AND BELIEF.

REGISTERED SURVEYOR _____ REG. NO. _____

BM SANITARY MANHOLE
ELEV-624.26

Grading Plan Approved as shown and/or noted
JAMES R. GILLS, P.E.
Lake County Engineer
By *James R. Gills* Date 3/20/03

EXISTING UTILITIES NOTE:
THE SIZE AND LOCATION, BOTH HORIZONTAL AND VERTICAL OF THE UNDERGROUND UTILITIES SHOWN HEREON, HAVE BEEN OBTAINED BY A SEARCH OF AVAILABLE RECORDS. VERIFICATION BY FIELD OBSERVATION HAS BEEN CONDUCTED WHERE PRACTICAL, HOWEVER, BABCOCK, JONES AND ASSOCIATES INC. DOES NOT GUARANTEE THE COMPLETENESS NOR ACCURACY THEREOF.

