
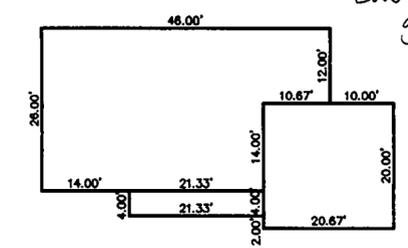


SYMBOL LEGEND	
	Fire Hydrant
	Iron Pen Found
	Yard Drain
	Electric Box
	Water Meter
	Manhole
	Iron Pin Set

Zoning District R-1
 Front Setback 50'
 Side Setback 10'
 Rear Setback 25'

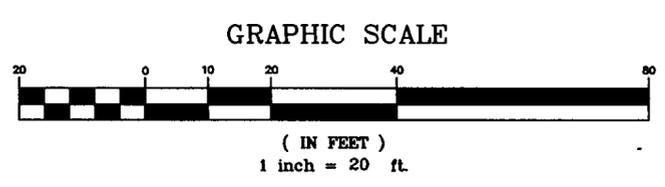

Grading Plan Approved as shown and/or noted
THOMAS P. GILLES, P.E.
 Lake County Engineer
 By G.H. Date 10/14/98
 Lower ext. finished grade to 697.0.

APPROVED
 PAINESVILLE TOWNSHIP
 ZONING DEPARTMENT
19980295
DR

SITE PLAN

for : R. L. Moore Homes
CLIENT
7121 Revenna Road Concord OH 44077
ADDRESS CITY STATE ZIP

138 Cedar Glen Phase 8
SUBLOT No. SUBDIVISION NAME VOL. PAGE
Painville Twp. Ohio
LOT TRACT CITY STATE

Foresight Engineering Group
Engineers & Surveyors
 440 286-1010 fax
 440 286-1034 fax
 320 Center Street, Unit F
 Chardon, Ohio 44024

DESIGN CERTIFICATION

This Site Plan was prepared by Foresight Engineering Group, Inc., and is correct to the best of my knowledge and belief.
SLAR
NAME

CHECK LIST

- LOT DIMENSIONS & BEARINGS
- TIE TO NEAREST STREET
- SUBLOT No. (PARCEL No.)
- SURROUNDING OWNERS
- BUILDING DIMENSIONS
- SETBACK, SIDEYARD, REARYARD
- FINISH GRADES
- DRIVE & APRON TYPE, WIDTH, THICKNESS
- SIDEWALK TYPE, WIDTH, THICKNESS
- CULVERT TYPE, DIAM., LENGTH
- WATER MAIN SIZE, LOCATION
- SAN. SEWER SIZE, % GRADE, LOC.
- SAN. MH. CAST. ELEV., INV. ELEV.
- SAN. CONN. SIZE, % GRADE, LOC.
- STORM SEWER SIZE, % GRADE, LOC.
- STORM MH. CAST. ELEV., INV. ELEV.
- PAVT TYPE, GRADE, CURBS
- GAS LINE LOC. SIZE
- SEPTIC SYSTEM & DUPLICATION
- WELL LOCATION & ISOLATION RADIUS



STATE SEAL

"AS BUILT" CERTIFICATION

I hereby certify that the circled information is existing as obtained on the site _____ 19__ and is correct to the best of my knowledge and belief.

NAME _____

SCALE : 1" = 20'	1
FILE NAME: I:\Rim19814\SL138.Dwg	2
DATE : October 6, 1998	3

BENCHMARK: STS MH. Rim = 693.47

"I, the undersigned hereby certify that this topography, indicated by 6", 1' or 2' contours, and the elevations shown hereon represent an actual field survey made by Foresight Engineering Group, Inc. on the 31 day of August 19 98 and that the elevations were taken at appropriate intervals and that as of that date they existed as indicated hereon."

SLAR
NAME



EXISTING UNDERGROUND UTILITIES NOTES:
 The location both horizontal and vertical of the underground utilities shown hereon, have been obtained by a diligent and comprehensive search of available records. Verification by field observation, has been conducted where practical. However, Foresight Engineering Group, Inc. does not guarantee the completeness nor accuracy thereof.