


S/L 16 (VACANT)

S/L 15 2.201 ACRES

S/L 14

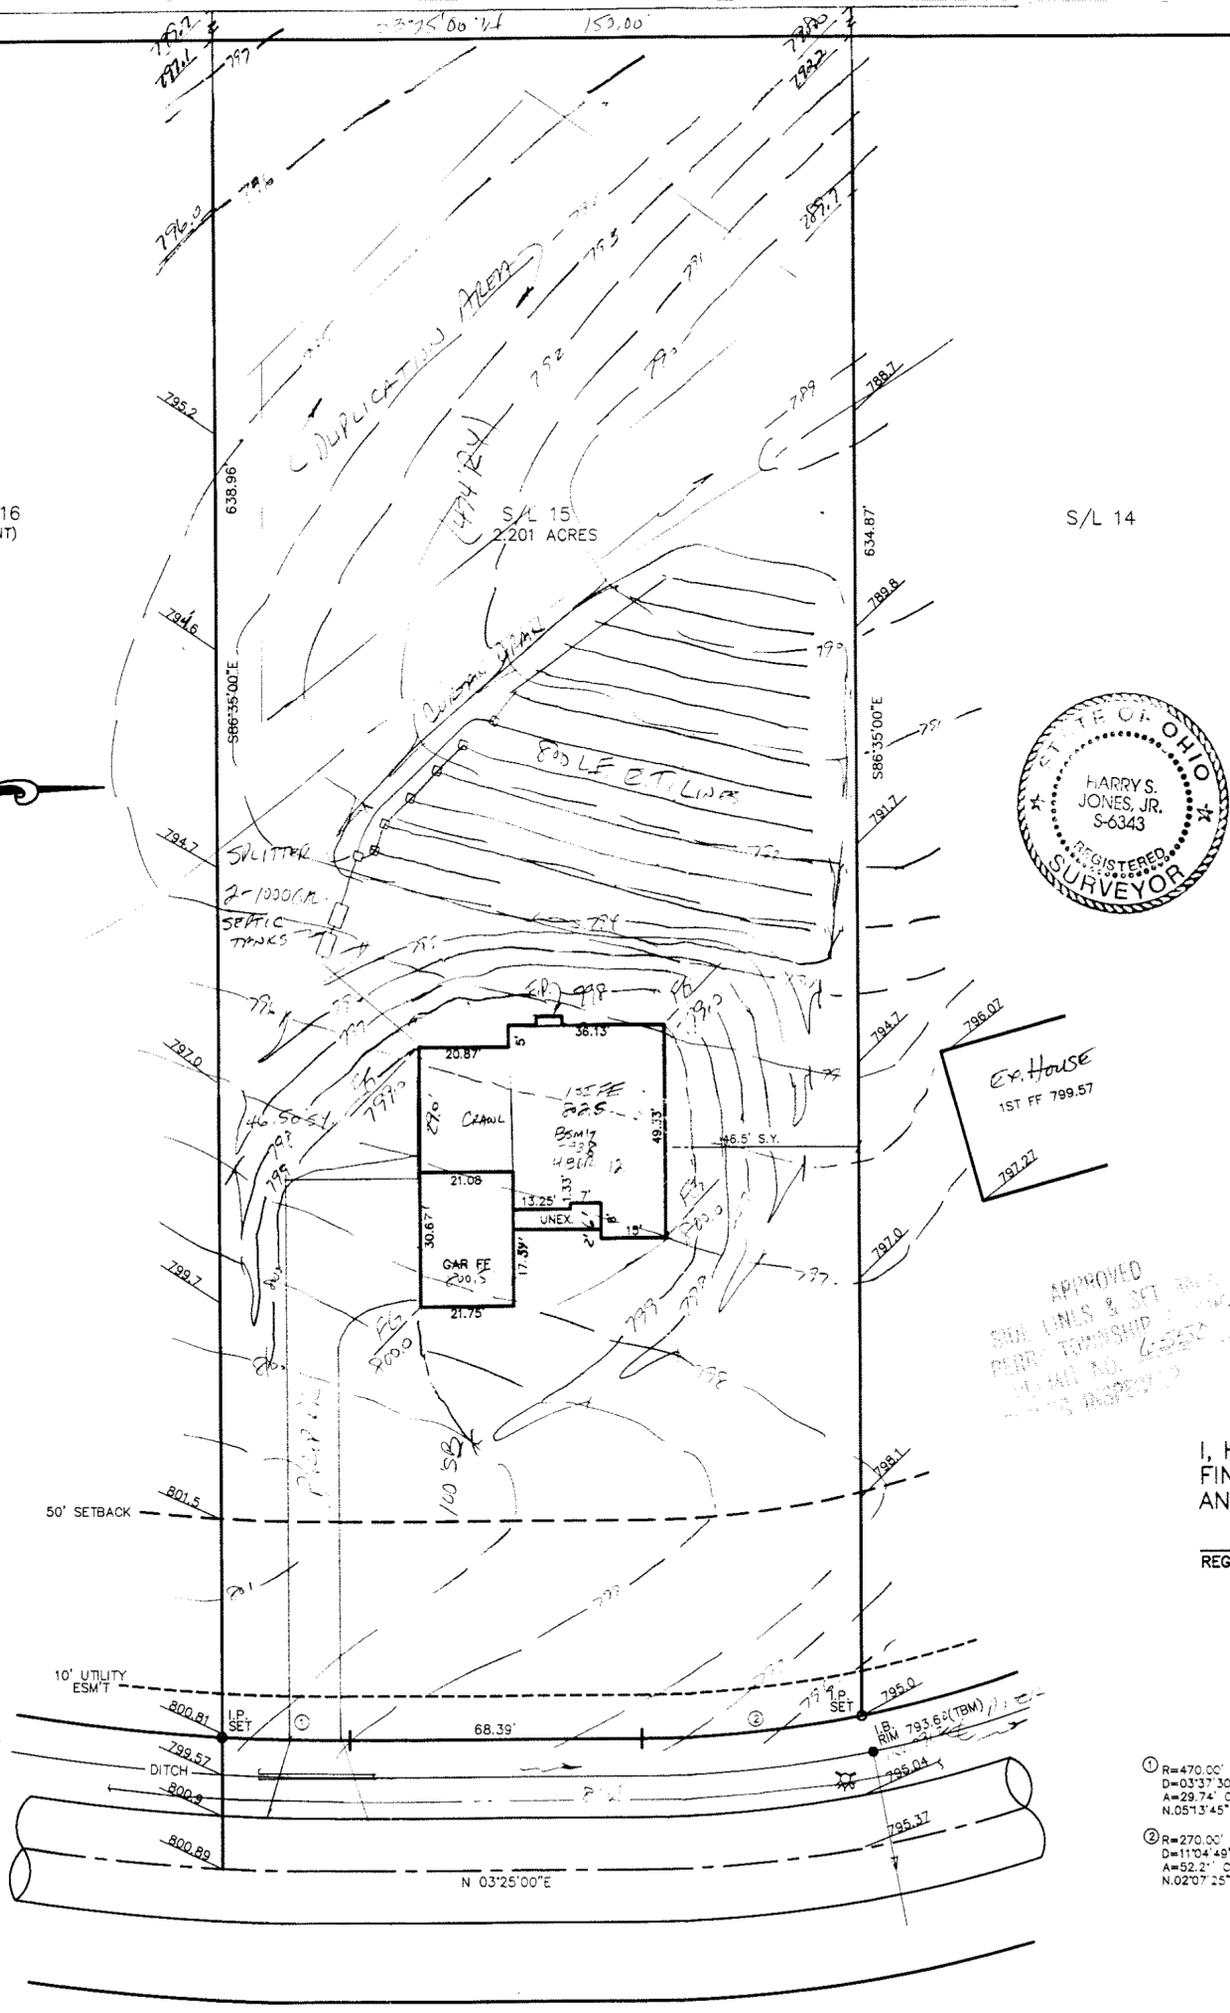

SITE PLAN

PERRY TWP., LAKE COUNTY, OHIO

for: MERKOSKY CLIENT OWNER

ADDRESS STREET CITY ZIP

RIVERWOOD SUB.

SUBDIVISION	27-28	NAME	LOT	TRACT
15	VOL-PG	RIVERWOOD DR	VOLUME	PAGE
SUBLOT NO.	STREET	PERM. PARCEL NO.	STREET	

LEGEND

SANITARY MANHOLE	---○---	EXIST. ELEV. → 100.0	PROP. ELEV. ← 100.0
STORM MANHOLE	---●---	AS BUILT ELEVATION	
INLET OR CATCH BASIN	---□---	INDICATES DIRECTION OF SURFACE DRAINAGE	
HYDRANT	---○---		
EXISTING CONTOURS	---○---		
PROPOSED CONTOURS	---○---		

REMARKS

ALL BOUNDARY DATA SHOWN WAS OBTAINED FROM (DEEDS, RECORDED SUBDIVISION PLAT OR OTHER PUBLIC RECORDS)

LOCATIONS AS SHOWN OF ADJACENT WELLS AND SEPTIC TANKS OBTAINED FROM LAKE COUNTY HEALTH DEPARTMENT

DESIGN CERTIFICATION

THIS PLAT WAS PREPARED BY ME, AND IS CORRECT TO THE BEST OF MY KNOWLEDGE AND BELIEF.

Harry S. Jones, Jr. #6343

NAME SURVEYOR REGISTRATION NO.

CHECK LIST

NO. OF BEDROOMS	WATER MAIN SIZE, LOCATION
DIMENSIONS	SAN. SEWER SIZE % GR. LOC.
BEARINGS	SAN. M.H. CAST. ELEV. INV. ELEV.
TIE TO NEAREST STREET	SAN. CONN. SIZE, LOC. DEPTH
SUBLOT NO. PARCEL NO.	STORM SEWER SIZE % GR. LOC.
SURROUNDING OWNERS	STORM M.H. CAST. ELEV. INV. ELEV.
BLDG. DIMENSIONS FIN GR.	PAV'T TYPE GRADE CURBS
BLDG. TIES FL'R. GRADES	GAS LINE LOC. SIZE PRESSURE
APRON TYPE WIDTH THICKNESS	SEPTIC TANK LOCATION & DUPLICATION AREA
SIDEWALK TYPE WIDTH THICKNESS	WELL LOCATION
CULVERT TYPE DIA., LENGTH	ISOLATION RADIUS FROM WELL
ROCK OUTCROPPINGS	

REVISIONS			PLAN PREPARED BY:		
NO.	DATE	BY	BABCOCK · JONES & ASSOCIATES, INC.		
1			PAINESVILLE, OHIO		
2			DRAWN BY	SCALE	PHONE NO.
3			T.R.	1" = 30'	216-357-1811
4			CHK'D.	DATE	DRAWING NO.
5			WJ	10/1/97	96-272-15
			CREW	APP'D	
			WJ	WJ	

"AS BUILT" CERTIFICATION

I, HEREBY CERTIFY THAT THE CIRCLED GRADES ARE EXISTING FINISH GRADES CHECKED IN THE FIELD ON _____, 19____ AND ARE CORRECT TO THE BEST OF MY KNOWLEDGE AND BELIEF.

REGISTERED SURVEYOR REG. NO.

TBM - RIM INLET BASIN
ELEV. = 793.60

① R=470.00'
D=03°37'30"
A=29.74' C=29.73'
N.05°13'45"E

② R=270.00'
D=11°04'49"
A=52.21' C=52.16'
N.02°07'25"E

Grading Plan Approved as shown and/or noted THOMAS P. GILLES, P.E. Lake County Engineer

By 614 Date 10.23.97

"I, the undersigned hereby certify that this topographic map, created by 6", 1" or 2" contours, and elevations shown hereon represent an actual field survey made by me on the 30th day of SEPT, 1997 and that the elevations were taken at appropriate intervals and that as of that date they existed as indicated hereon."

Harry S. Jones, Jr. #6343
Name Reg. No.

