

SITE PLAN

PERRY TOWNSHIP, LAKE COUNTY, OHIO

for: **VIDMAR**

CLIENT _____ OWNER _____
 ADDRESS _____ STREET _____ CITY _____ ZIP _____

RED MILL
 SUBDIVISION 32-26 NAME _____ TRACT _____ STREET _____
 VOL.-PG. 43 WHITE ANGEL EOT _____
 SUBLT NO. _____ STREET _____ VOL.-PG. _____ PERM. PARCEL NO. _____

LEGEND

SANITARY MANHOLE --- (Symbol) --- EXIST. ELEV. --- 100.0 --- PROP. ELEV. --- 100.0 ---
 STORM MANHOLE --- (Symbol) --- AS BUILT ELEVATION
 INLET OR CATCH BASIN --- (Symbol) --- INDICATES DIRECTION OF SURFACE DRAINAGE
 HYDRANT --- (Symbol) ---
 EXISTING CONTOURS --- (Symbol) ---
 PROPOSED CONTOURS --- (Symbol) ---

REMARKS

ALL BOUNDARY DATA SHOWN WAS OBTAINED FROM (DEEDS, RECORDED SUBDIVISION PLAT OR OTHER PUBLIC RECORDS)
 LOCATIONS AS SHOWN OF ADJACENT WELLS AND SEPTIC TANKS OBTAINED FROM LAKE COUNTY HEALTH DEPARTMENT

DESIGN CERTIFICATION

THIS PLAT WAS PREPARED BY ME, AND IS CORRECT TO THE BEST OF MY KNOWLEDGE AND BELIEF

NAME Harry S. Jones SURVEYOR REGISTRATION NO. 6343

CHECK LIST

NO. OF BEDROOMS _____
 DIMENSIONS _____
 BEARINGS _____
 TIE TO NEAREST STREET _____
 SUBLT NO. PARCEL NO. _____
 SURROUNDING OWNERS _____
 BLDG. DIMENSIONS FIN GR. _____
 BLDG. TIES FL'R. GRADES _____
 APRON TYPE WIDTH THICKNESS _____
 SIDEWALK TYPE WIDTH THICKNESS _____
 CULVERT TYPE DIA. LENGTH _____
 ROCK OUTCROPPINGS _____
 WATER MAIN SIZE, LOCATION _____
 SAN. SEWER SIZE X GR. LOC. _____
 SAN. MH. CAST. ELEV. INV. ELEV. _____
 SAN. CONN. SIZE, LOC. DEPTH _____
 STORM SEWER SIZE X GR. LOC. _____
 STORM MH. CAST. ELEV. INV. ELEV. _____
 PAV'T TYPE GRADE CURBS _____
 GAS LINE LOC. SIZE PRESSURE _____
 SEPTIC TANK LOCATION & DUPLICATION AREA _____
 WELL LOCATION _____
 ISOLATION RADIUS FROM WELL _____

REVISIONS		
NO.	DATE	BY
1		
2		
3		
4		
5		

PLAN PREPARED BY:
BABCOCK · JONES & ASSOCIATES, INC.
 PAINESVILLE, OHIO
 DRAWN BY T.R. SCALE 1"=20' PHONE NO. 440-357-1811
 CHK'D. H.J. DATE 5/2/99 DRAWING NO. _____
 CREW CHIEF H.J. APP'D H.J. 93-032-43

"AS BUILT" CERTIFICATION
 I, HEREBY CERTIFY THAT THE CIRCLED GRADES ARE EXISTING FINISH GRADES CHECKED IN THE FIELD ON 5/2/99 AND ARE CORRECT TO THE BEST OF MY KNOWLEDGE AND BELIEF.


REGISTERED SURVEYOR _____ REG. NO. _____

C1: R=65.00'
 L=57.40'
 T=30.72'
 D=50°35'47"
 C=55.55'
 N71°20'46"E

TBM-SANITARY MH.
 RIM=696.30

Grading as shown by **THOMAS P. Lake County** S.P.E. 1999

swale as shown with 12" culvert
ROOF DRAINS SHALL DISCHARGE TO SPASH BLO

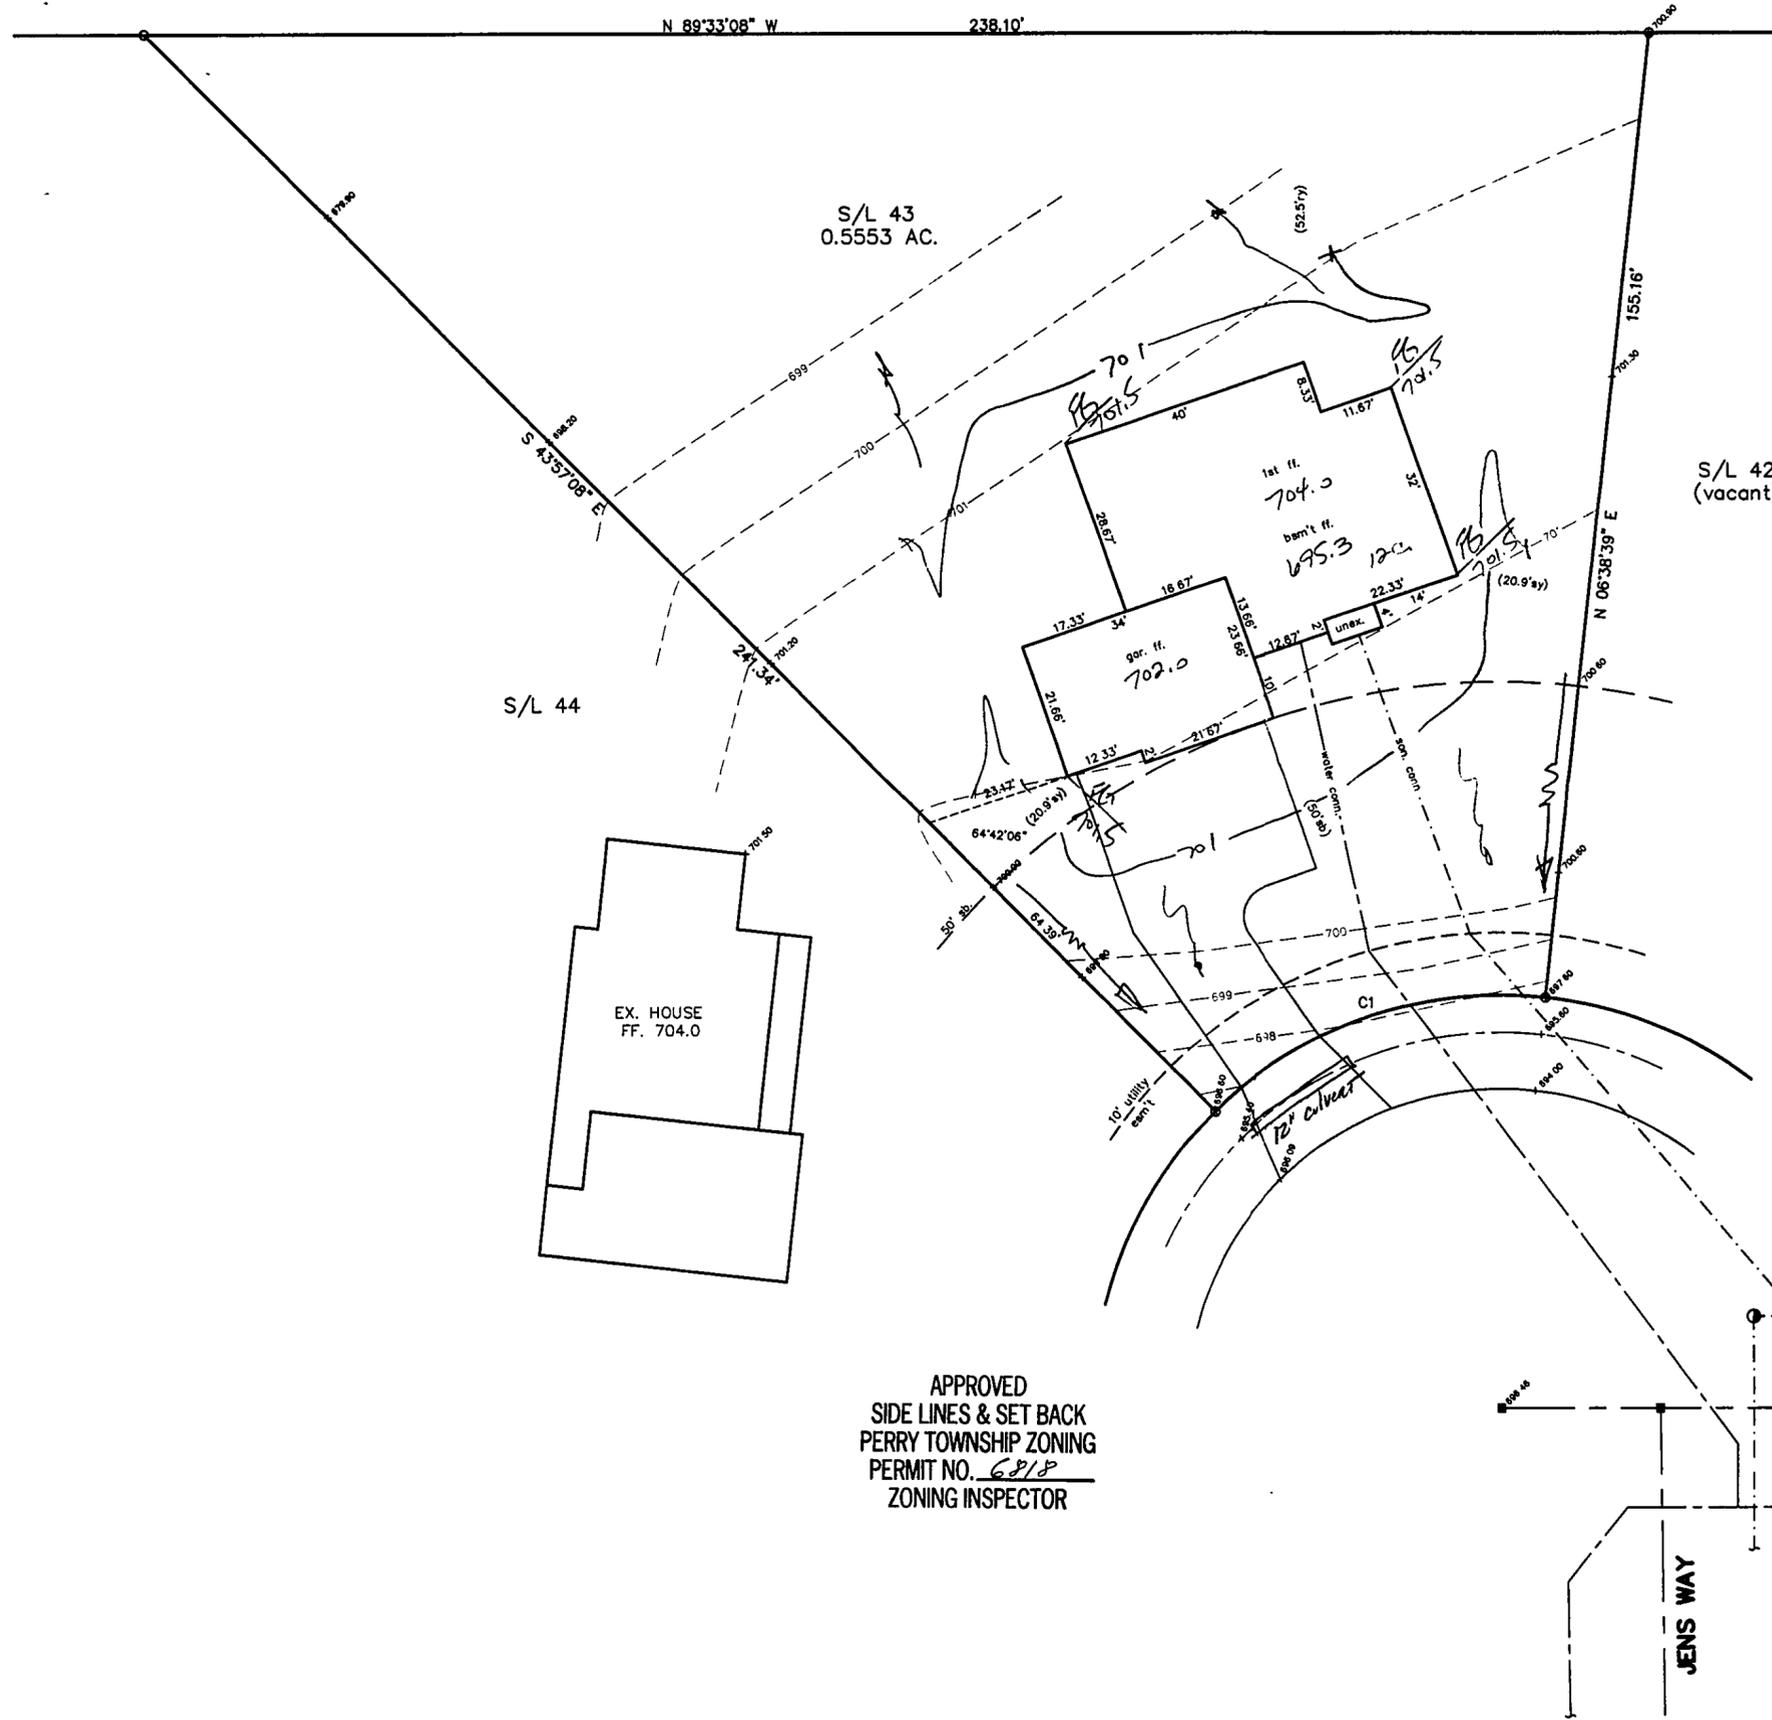

APPROVED
 SIDE LINES & SET BACK
 PERRY TOWNSHIP ZONING
 PERMIT NO. 6818
 ZONING INSPECTOR

WHITE ANGEL DR. - 60'

JENS WAY