

REVIEWED BY:

Polaris Engineering & Surveying, Inc.


Chuck Szum *3/19/15*

Name Date
This Review is for general plan & scope only and does not relieve the author of these documents from professional responsibility for accuracy of design conformity to applicable ordinances and errors or omissions.

Stormwater Management Plan
Approved as shown and/or noted
JAMES R. GILLS, P.E.
County Drainage Engineer
By GJH Date 3/20/15

Shoreland Circle (60')

Lakewick Lane (60')

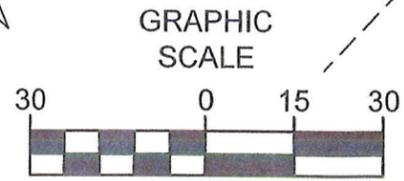

2 WORKING DAYS BEFORE YOU DIG

CALL TOLL FREE 800-362-2764

OHIO UTILITIES PROTECTION SERVICE
NON-MEMBERS MUST BE CALLED DIRECT





NOTES:
Backflow Preventor Required For Sanitary Connections.
Cleanouts shall be provided for sanitary connections. Cleanouts to be located @ the back of utility easement. All Cleanout Risers should be 6" diameter and have Cast Iron Caps.
Sanitary Connections Shall Be 6" At Minimum 1.0%
Downspouts and Sump Pump To Be Splashblocked.
Water Connections To Be 1"

SITE PLAN FOR:
SUBLOT No.10, Address.#193
PPN:28-A-041-N-00-010-0
SHORELAND CROSSINGS No.2
CITY OF WILLOWICK - LAKE COUNTY - OHIO

SURVEYOR CERTIFICATION

I HEREBY CERTIFY THAT I HAVE SURVEYED THE PREMISES AND PREPARED THE ATTACHED PLAT IN ACCORDANCE WITH THE PROVISIONS OF CHAPTER 4733-37 OF THE OHIO ADMINISTRATIVE CODE AND THE DIMENSIONS OF THE LOTS AND ROAD ARE IN FEET AND DECIMAL PARTS THEREOF, ALL OF WHICH ARE CORRECT TO THE BEST OF MY KNOWLEDGE AND BELIEF. IRON MONUMENTS OR PINS AS INDICATED WERE FOUND OR SET AS SHOWN HEREON.

Daniel Laux
DANIEL LAUX P.S. #7087 DATE

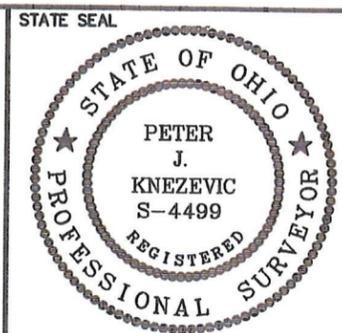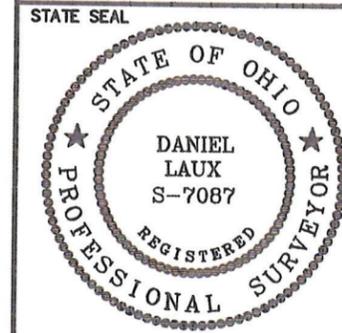

DESIGN CERTIFICATION
THIS PLAN WAS PREPARED BY ME, AND IS CORRECT TO THE BEST OF MY KNOWLEDGE AND BELIEF.

Peter J. Knezevic

PETER J. KNEZEVIC, P.S.4499 DATE 3/19/15

"AS-BUILT" CERTIFICATION

I HEREBY CERTIFY THAT THE CIRCLED INFORMATION IS EXISTING AS OBTAINED ON THE SITE AND IS CORRECT TO THE BEST OF MY KNOWLEDGE AND BELIEF.

NAME DATE

Prepared By:
PETER J. KNEZEVIC, P.S.
30102 Rickey Lane
Wickliffe, Ohio 44092
(440)944-3794

Prepared For:
B.R. Knez Construction, Inc.
7555 Fredle Drive
Suite 210
Concord Township, Ohio 44077
(440)710-0711

BENCHMARK:
B.M. = T.B.M Set On Top Of Hydrant
Located As Noted
Elevation 619.64

DATE: 3/19/15
SCALE: HOR. 1"=30'
VERT. 1"=0'
FILENAME: Sublot10
DRAWN: KTH

CONTRACT No.
07067-S/L10
SHEET **1** OF **1**

EXISTING UNDERGROUND UTILITIES NOTE:
THE SIZE AND LOCATION, BOTH HORIZONTAL AND VERTICAL OF THE UNDERGROUND UTILITIES SHOWN HEREON, HAVE BEEN OBTAINED BY A SEARCH OF AVAILABLE RECORDS. VERIFICATION BY FIELD OBSERVATION HAS BEEN CONDUCTED WHERE PRACTICAL. HOWEVER, DESIGNER DOES NOT GUARANTEE THE COMPLETENESS NOR ACCURACY THEREOF.

