


MAY 07 2008

WILLOWICK BUILDING DEPT

GRAPHIC SCALE

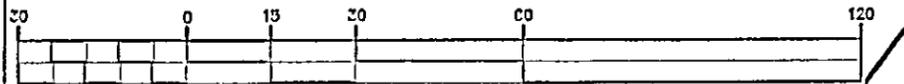

(IN FEET)
1 inch = 30 ft.

REVIEWED BY:

Peter Engineering & Surveying, Inc.
4/18/08

Name: Peter Engineering & Surveying, Inc.
This Plan is for general information only and does not constitute the author of this document from professional responsibility for accuracy of detail conformity to applicable ordinances and errors or omissions.

Top/Hyd.
620.75



NOTE: HOUSE DIMENSIONS AND FLOOR ELEVATIONS TO BE VERIFIED BY ARCHITECT & BUILDER.

NOTE: Backflow Preventer Required For Sanitary Connections.

G.O. = Cleanout
NOTE Sanitary Sewer Cleanout located 42' off E (Type)

SITE PLAN FOR:
SUBLOT No.4, Add.#181
PPN:28-A-041-N-00-004-0
SHORELAND CROSSINGS No.
CITY OF WILLOWICK - LAKE COUNTY - OHIO


SURVEYOR CERTIFICATION

I HEREBY CERTIFY THAT I HAVE SURVEYED THE PREMISES AND PREPARED THE ATTACHED PLAN IN ACCORDANCE WITH THE PROVISIONS OF CHAPTER 4733-37 OF THE OHIO ADMINISTRATIVE CODE AND THE DIMENSIONS OF THE LOTS AND ROAD ARE IN FEET AND DECIMAL PARTS THEREOF, ALL OF WHICH ARE CORRECT TO THE BEST OF MY KNOWLEDGE AND BELIEF, FROM MONUMENTS OR FMS AS INDICATED WERE FOUND OR SET AS SHOWN HEREON.


Daniel Laux P.S. #7087 4/14/08 DATE

Stormwater Management Plan
Approved as shown and/or noted
JAMES R. GILLS, P.E.
County Drainage Engineer
By L.S. Date 5/13/08

STATE SEAL

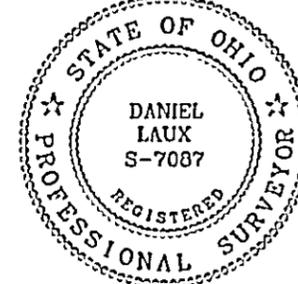

STATE SEAL

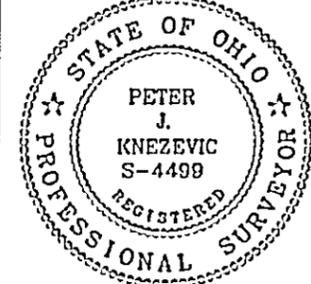

DESIGN CERTIFICATION

THIS PLAN WAS PREPARED BY ME, AND IS CORRECT TO THE BEST OF MY KNOWLEDGE AND BELIEF.

Peter J. Knezevic P.S. 4499
PETER J. KNEZEVIC, P.S.4499 4/15/08 DATE

"AS-BUILT" CERTIFICATION

I HEREBY CERTIFY THAT THE CIRCLED INFORMATION IS EXISTING AS OBTAINED ON THE SITE AND IS CORRECT TO THE BEST OF MY KNOWLEDGE AND BELIEF.

NAME DATE

Prepared By:
PETER J. KNEZEVIC, P.S.
30102 Ricker Lane
Wickliffe, Ohio 44092
(440)944-3704

Prepared For:
B.R. Knoz Construction, Inc.
3375 Blackmore Road
Perry Township, Ohio 44081
(440)259-0087

BENCHMARK:

B.M. = T.B.M Set On Top Of Hydrant
Located In Front Of S/L's 6&7
Elevation 620.75

DATE: 4/14/08
SCALE: HOR. 1"=30'
VERT. 1"=0'
FILENAME: Exhibit 4 top.dwg
COMPUTER: S
CREW CHIEF: R.O.W.

CONTRACT No.
07067-S/L 4
SHEET 1 OF 1

Site & Grada Now Hso. 4-14-08
Site & Grada Hso. 10-30-07

EXISTING UNDERGROUND UTILITIES NOTE:
THE SIZE AND LOCATION, BOTH HORIZONTAL AND VERTICAL OF THE UNDERGROUND UTILITIES SHOWN HEREON, HAVE BEEN OBTAINED BY A SEARCH OF AVAILABLE RECORDS. VERIFICATION BY FIELD OBSERVATION HAS BEEN CONDUCTED WHERE PRACTICAL. HOWEVER, DESIGNER DOES NOT GUARANTEE THE COMPLETENESS NOR ACCURACY THEREOF.

APPROVED AS NOTED
WILLOWICK BUILDING DEPT.

Signature

Date

4-9-08

Sanitary MH
Rim 617.05
Inv 607.97

Lakewick Lane (60')
CL/CL Hcn

2 WORKING DAYS BEFORE YOU DIG
CALL TOLL FREE 800-362-2764
OHIO UTILITIES PROTECTION SERVICE
NON-MEMBERS MUST BE CALLED DIRECT



CALL TOLL FREE 800-362-2764

OHIO UTILITIES PROTECTION SERVICE
NON-MEMBERS MUST BE CALLED DIRECT