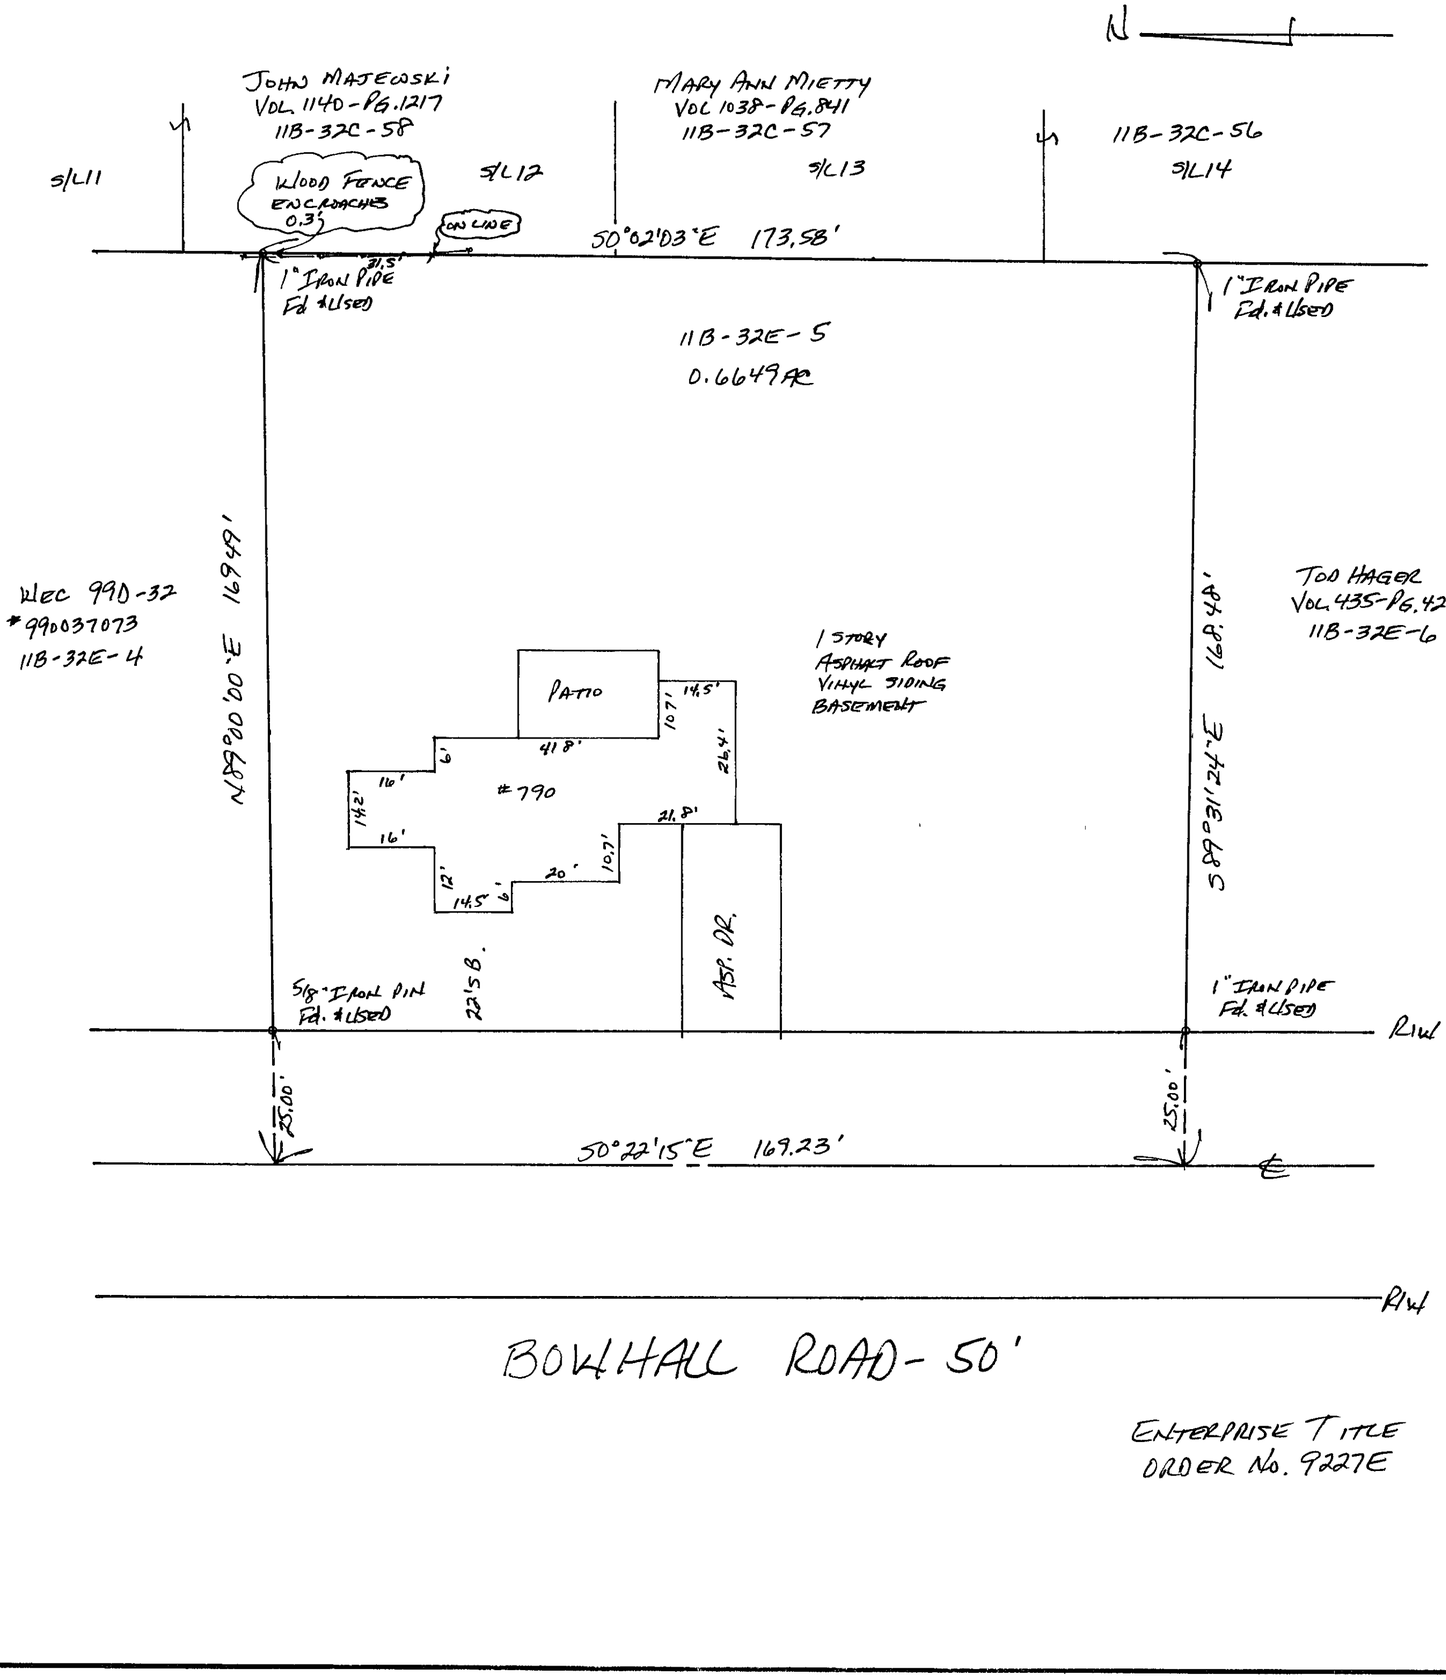

ENTERPRISE TITLE
ORDER No. 9227E

603288

PLAT OF SURVEY

PAINESVILLE TOWNSHIP, LAKE COUNTY, OHIO

for: C/O GEOFF HANAHAN
CLIENT OWNER

ADDRESS STREET CITY ZIP

SUBDIVISION NAME | LOT 11 | TRACT 1

VOL – PG | VOLUME 11B-32E-5 | PAGE BOWHALL ROAD

SUBLOT NO STREET | PERM PARCEL NO STREET

LEGEND

SANITARY MANHOLE	WATER VALVE (GAS)
STORM MANHOLE	WATER METER (GAS)
INLET OR CATCH BASIN	AS BUILT ELEVATION (1000)
HYDRANT	INDICATES DIRECTION OF SURFACE DRAINAGE
EXISTING CONTOURS	
PROPOSED CONTOURS	
EXIST ELEV 100.0 / 100.0 PROP ELEV	

REMARKS

ALL BOUNDARY DATA SHOWN WAS OBTAINED FROM (DEEDS RECORDED SUBDIVISION PLAT OR OTHER PUBLIC RECORDS)

LOCATIONS AS SHOWN OF ADJACENT WELLS AND SEPTIC TANKS OBTAINED FROM LAKE COUNTY HEALTH DEPARTMENT

DESIGN CERTIFICATION

THIS PLAT WAS PREPARED BY ME, AND IS CORRECT TO THE BEST OF MY KNOWLEDGE AND BELIEF

NAME SURVEYOR REGISTRATION NO 6343

CHECK LIST

NO OF BEDROOMS
DIMENSIONS
BEARINGS
TIE TO NEAREST STREET
SUBLOT NO PARCEL NO
SURROUNDING OWNERS
BLDG DIMENSIONS FIN GR
BLDG TIES FL'R GRADES
APRON TYPE WIDTH THICKNESS
SIDEWALK TYPE WIDTH THICKNESS
CULVERT TYPE DIA LENGTH
ROCK OUTCROPPINGS

WATER MAIN SIZE LOCATION
SAN SEWER SIZE % GR LOC
SAN MH CAST ELEV INV ELEV
SAN CONN SIZE LOC DEPTH
STORM SEWER SIZE % GR LOC
STORM MH CAST ELEV INV ELEV
PAV'T TYPE GRADE CURBS
GAS LINE LOC SIZE PRESSURE
SEPTIC TANK LOCATION & DUPLICATION AREA
WELL LOCATION
ISOLATION RADIUS FROM WELL

REVISIONS		
NO	DATE	BY
1		
2		
3		
4		
5		

PLAN PREPARED BY
BABCOCK • JONES & ASSOCIATES, INC
PAINESVILLE OHIO

DRAWN BY HAT	SCALE 1" = 20'	PHONE NO 357-1811
CHK'D HAT	DATE 10/15/01	DRAWING NO 01-216
CREW CHIEF WB	APP'D HAT	

"AS BUILT" CERTIFICATION

I, HEREBY CERTIFY THAT THE CIRCLED GRADES ARE EXISTING FINISH GRADES CHECKED IN THE FIELD ON _____, 19____ AND ARE CORRECT TO THE BEST OF MY KNOWLEDGE AND BELIEF

REGISTERED SURVEYOR REG NO

100 50 10 0 25 75

GRAPHICAL SCALE

STATE OF OHIO
HARRY S JONES, JR
S-6343
REGISTERED SURVEYOR