SITE PLAN

CONCORD TOWNSHIP — LAKE COUNTY, OHIO

for: Ryland (CLIENT) — OWNER

ADDRESS — STREET — CITY — ZIP

CONCORD HILLS #3 (SUBDIVISION NAME)	LOT / TRACT
131 (SUBLOT NO.) — VOL. — PG. — AMANDA (STREET)	VOLUME / PAGE
	PERM. PARCEL NO. / STREET

Grading Plan Approved as shown and/or noted
THOMAS P. GILLES, P.E.
Lake County Engineer
By [signature] Date 8-28-79

ZONING PERMIT
4033
ISSUED 8-27-79
SUBJECT TO APPROVAL BY:
Lake County Sanitary Eng. ☐
Lake County Eng. Dept. ☒
Lake County Planning Comm. ☐
Lake County Bldg. Dept. ☒

LEGEND

SANITARY MANHOLE
STORM MANHOLE
INLET OR CATCH BASIN
HYDRANT
EXISTING CONTOURS
PROPOSED CONTOURS
EXIST. ELEV. 100.0 / 100.0 PROP. ELEV.
WATER VALVE (GAS)
WATER METER (GAS)
AS BUILT ELEVATION 100.0
INDICATES DIRECTION OF SURFACE DRAINAGE

REMARKS

ALL BOUNDARY DATA SHOWN WAS OBTAINED FROM (DEEDS, RECORDED SUBDIVISION PLAT OR OTHER PUBLIC RECORDS)

LOCATIONS AS SHOWN OF ADJACENT WELLS AND SEPTIC TANKS OBTAINED FROM LAKE COUNTY HEALTH DEPARTMENT

DESIGN CERTIFICATION

THIS PLAT WAS PREPARED BY ME, AND IS CORRECT TO THE BEST OF MY KNOWLEDGE AND BELIEF.

[signature] — NAME — SURVEYOR — REGISTRATION NO. 4514

CHECK LIST

NO. OF BEDROOMS
DIMENSIONS
BEARINGS
TIE TO NEAREST STREET
SUBLOT NO. PARCEL NO.
SURROUNDING OWNERS
BLDG. DIMENSIONS FIN. GR.
BLDG. TIES FL'R. GRADES
APRON TYPE WIDTH THICKNESS
SIDEWALK TYPE WIDTH THICKNESS
CULVERT TYPE DIA., LENGTH
ROCK OUTCROPPINGS

WATER MAIN SIZE, LOCATION
SAN. SEWER SIZE % GR. LOC.
SAN. MH. CAST. ELEV. INV. ELEV.
SAN. CONN. SIZE, LOC. DEPTH
STORM SEWER SIZE % GR. LOC.
STORM MH. CAST ELEV. INV. ELEV.
PAV'T TYPE GRADE CURBS
GAS LINE LOC. SIZE PRESSURE
SEPTIC TANK LOCATION & DUPLICATION AREA
WELL LOCATION
ISOLATION RADIUS FROM WELL

REVISIONS		
NO.	DATE	BY
1		
2		
3		
4		
5		

PLAN PREPARED BY:
DEBEVEC • SALO & ASSOCIATES, INC
125 E. ERIE ST. PAINESVILLE, OHIO

DRAWN BY DEW	SCALE 1" = 30'	PHONE NO. 352-9250
CHK'D.	DATE 8/22/79	DRAWING NO. 4820-131
CREW CHIEF C.C.	APP'D.	

"AS BUILT" CERTIFICATION

I, HEREBY CERTIFY THAT THE CIRCLED GRADES ARE EXISTING FINISH GRADES CHECKED IN THE FIELD ON _____, 19__ AND ARE CORRECT TO THE BEST OF MY KNOWLEDGE AND BELIEF.

REGISTERED SURVEYOR — REG. NO.

AUG 23 1979

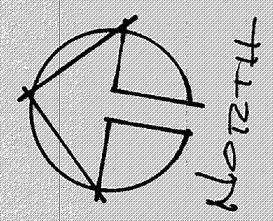

CURVE "A"
ARC = 10.95'
Δ = 1° 46' 04"
CHORD = 10.95'
H. 8° 07' 18" W.
RADIUS = 355.00'

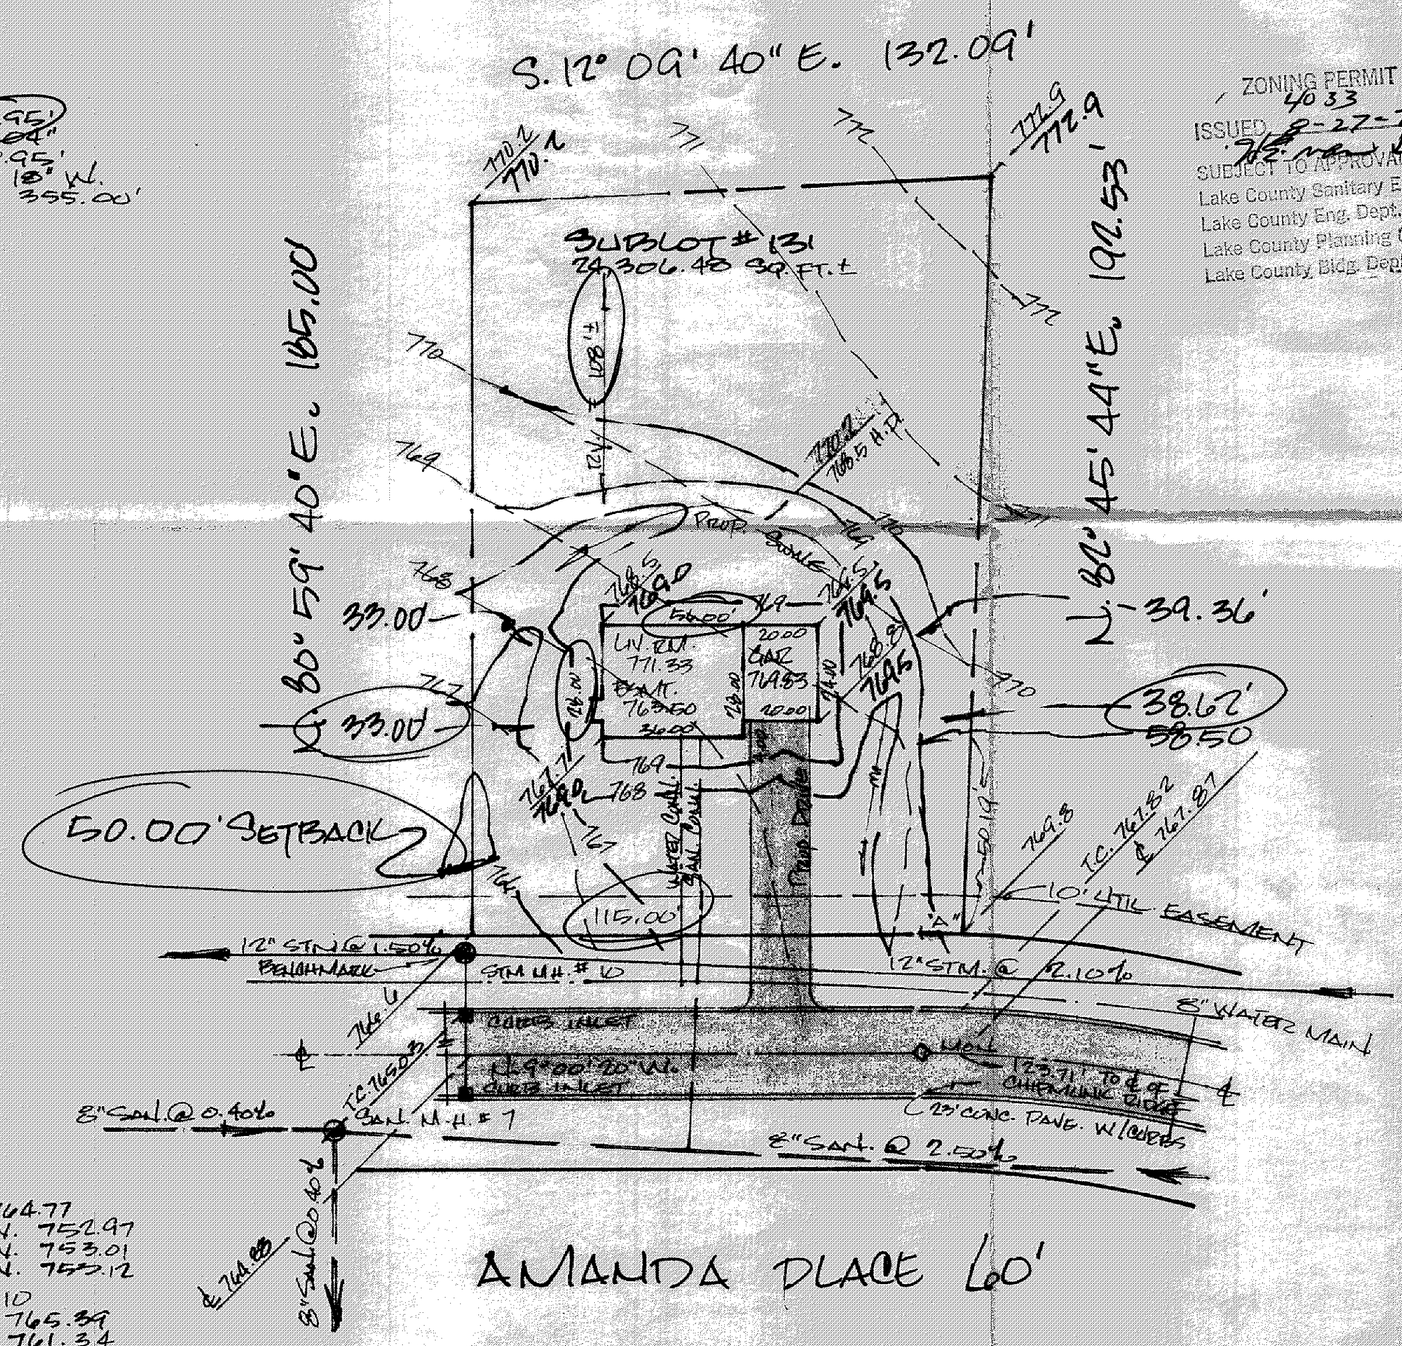

SAN. M.H. #7
EXIST. RIM 764.77
EXIST. W. INV. 752.97
EXIST. N. INV. 753.01
EXIST. S. INV. 752.12

STM. M.H. #10
EXIST. RIM 765.39
EXIST. INV 761.34

BENCHMARK — RIM OF STM. M.H. #10 IN FRONT OF S/L 131 & 132
ELEVATION — 765.39

4820-131