TOPOGRAPHIC SURVEY : PERMANENT PARCEL NO. 8-18-15 & 16

CONCORD TOWNSHIP - LAKE COUNTY, OHIO

Contour Interval 2'
Scale 1" = 50'

pared this plat
ances, and other
ct.

Civil

Grading Plan Approved
as shown and/or noted
THOMAS P. GILLES, P.E.
Lake County Engineer
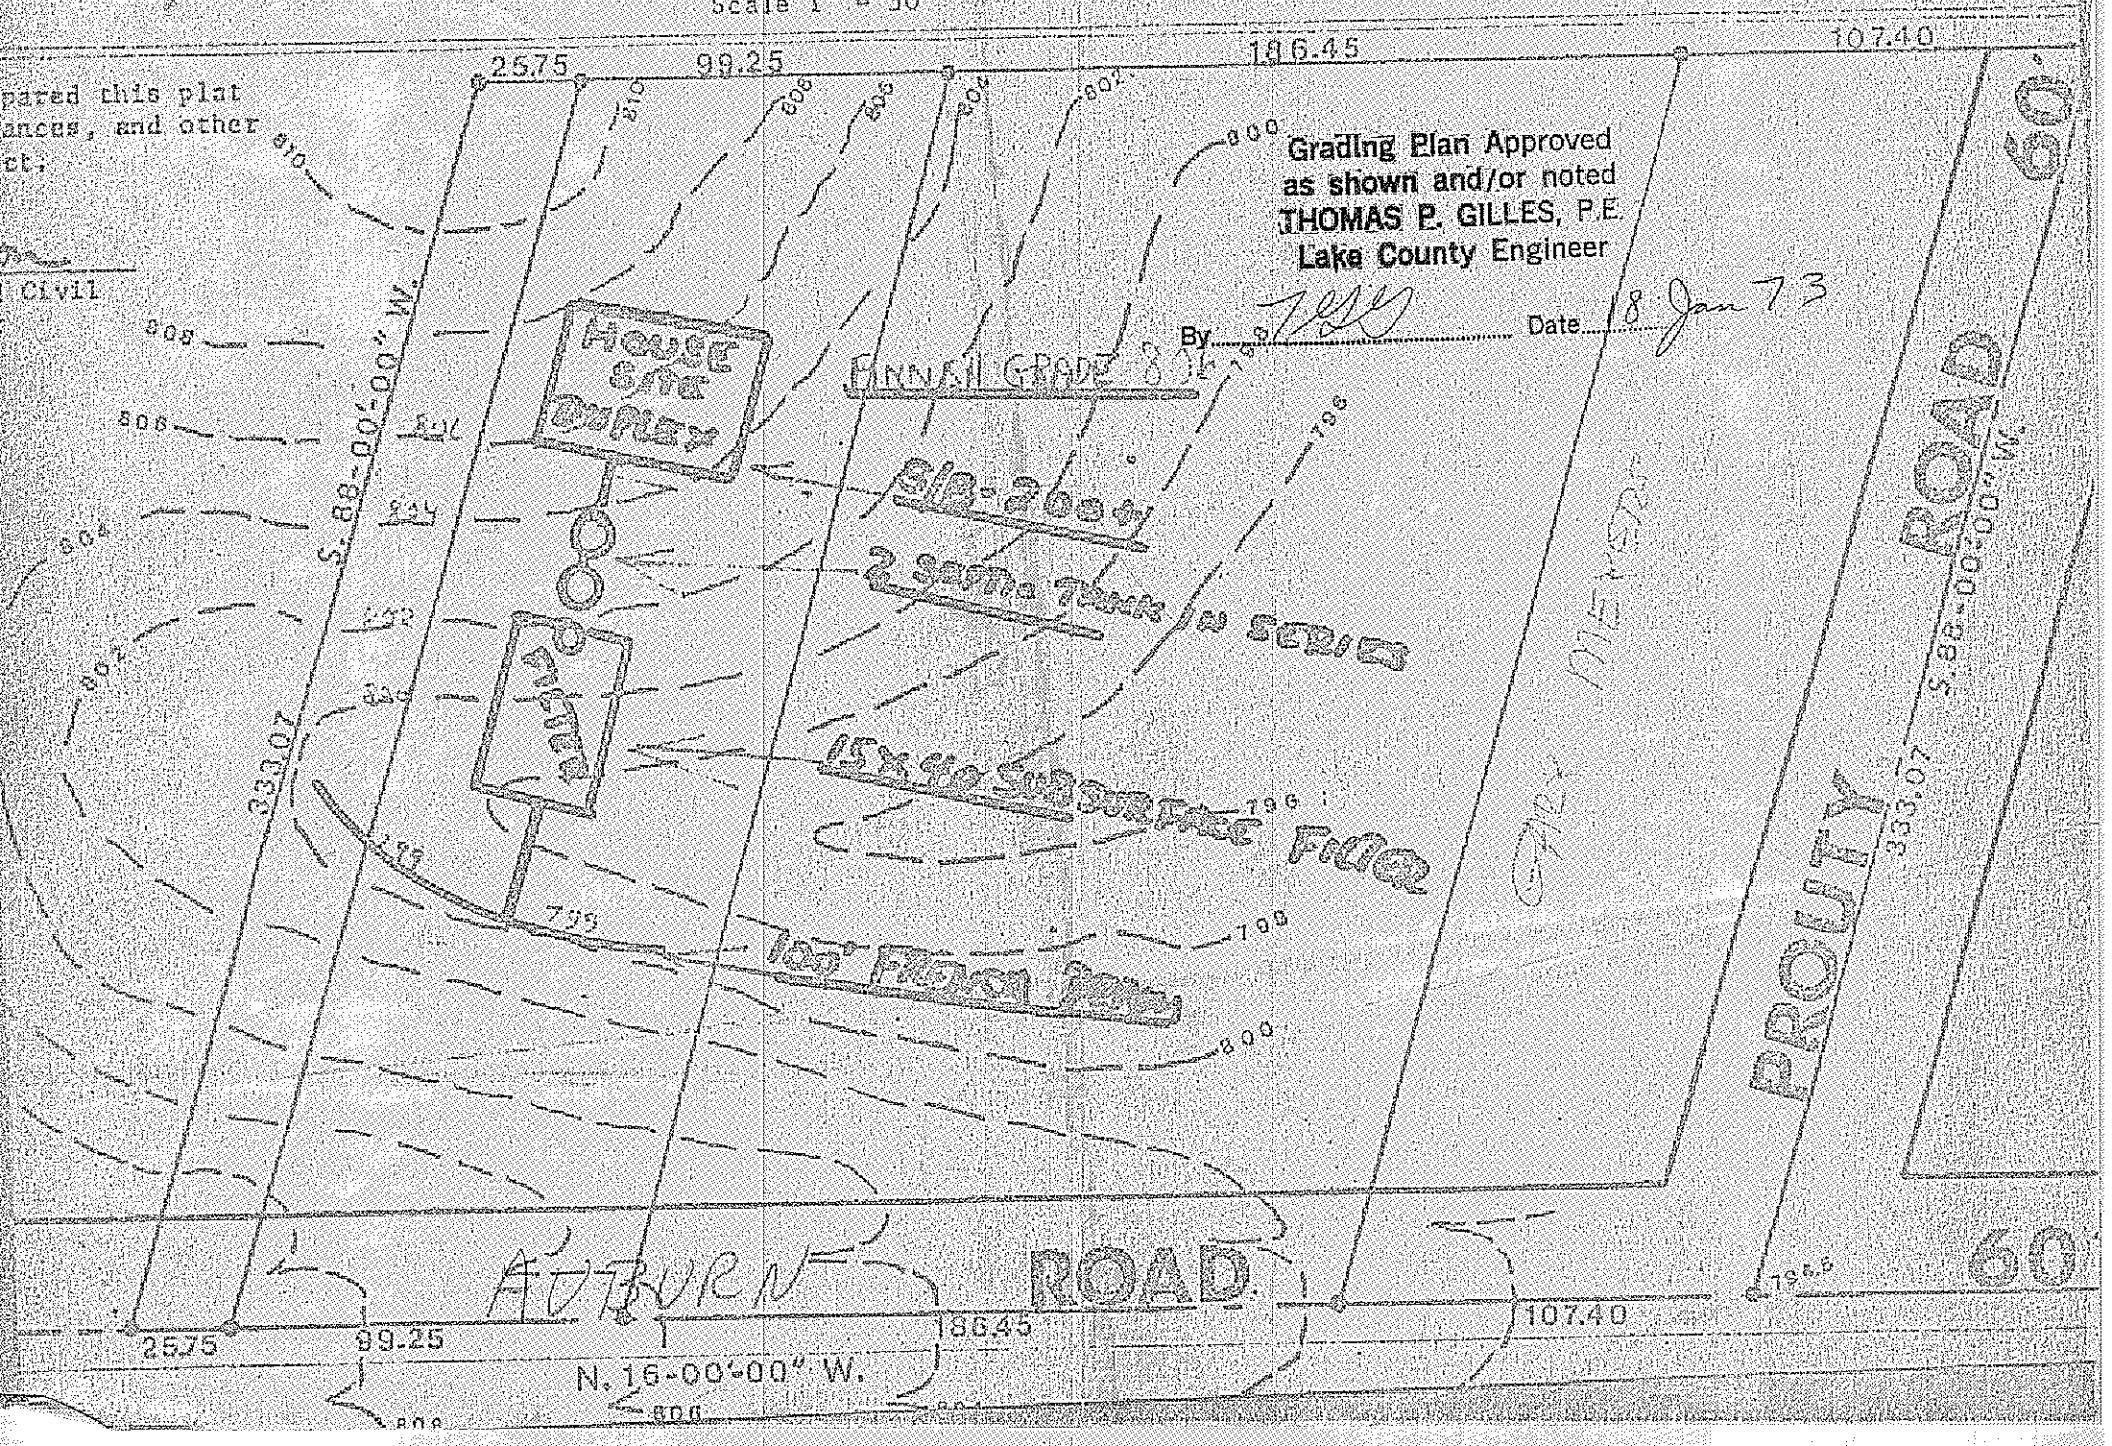
By ..... Date 18 Jan 73