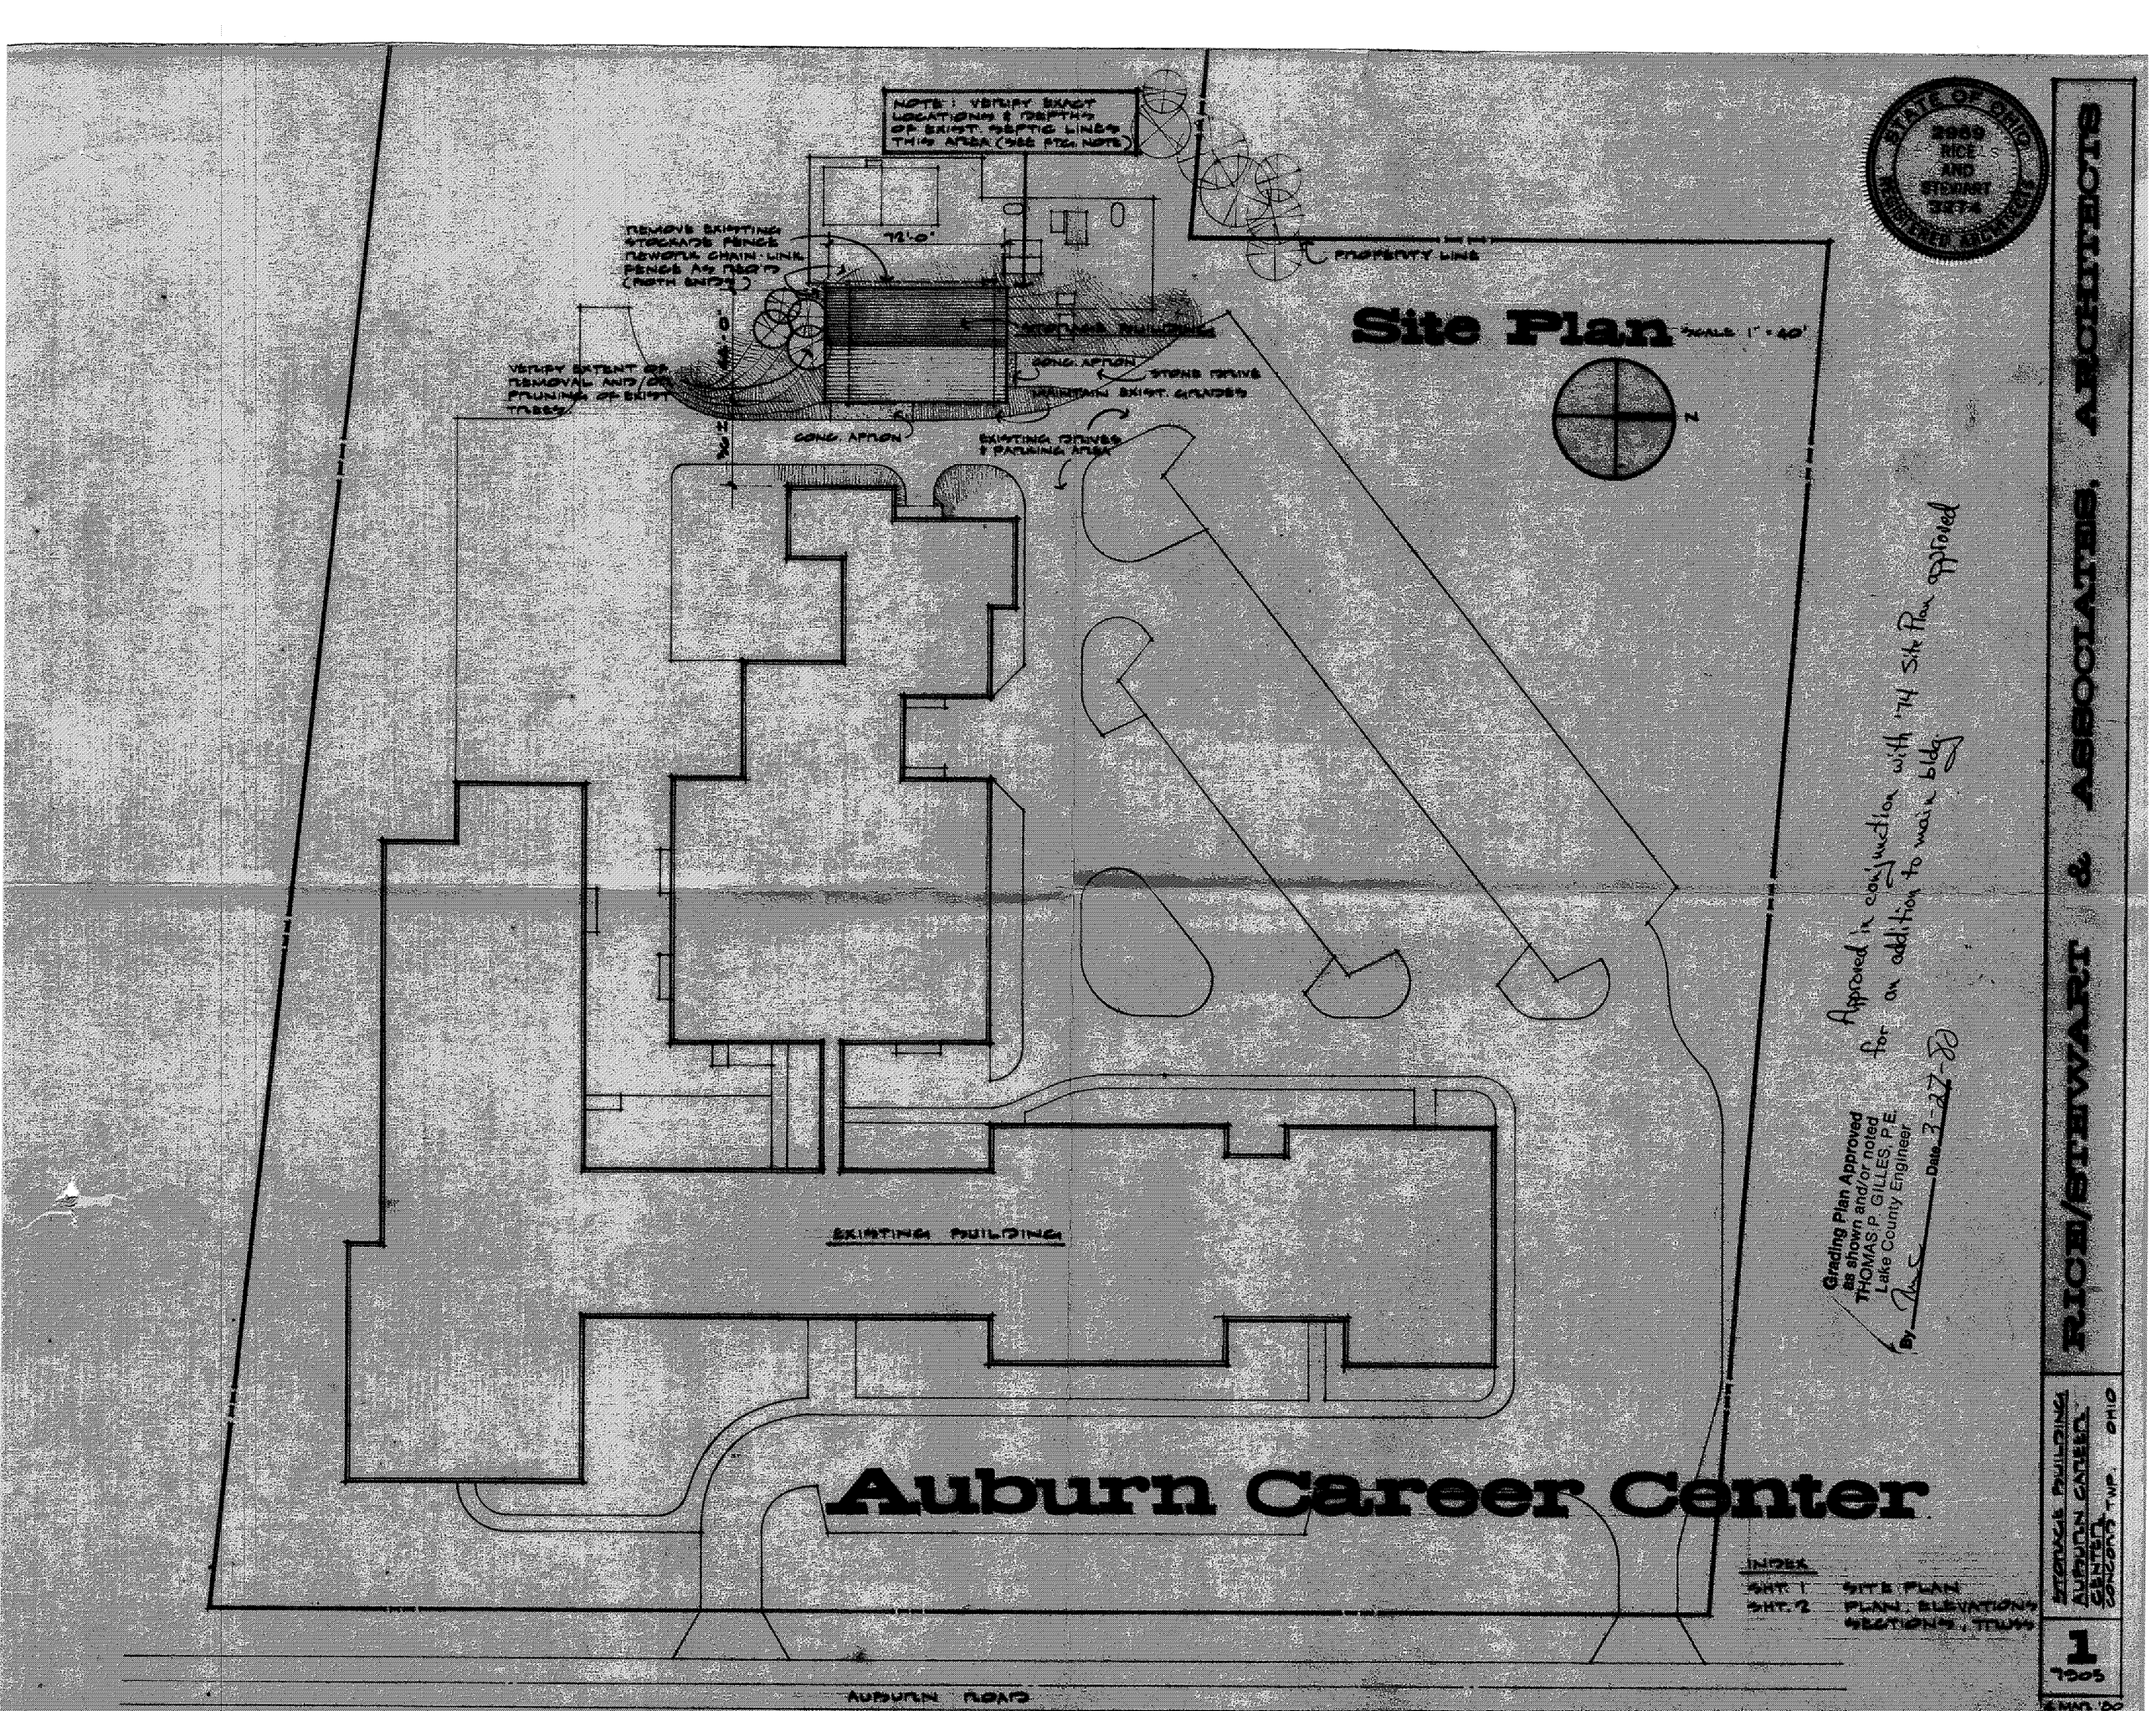

Grading Plan Approved as shown and/or noted
THOMAS P. GILLES, P.E.
Lake County Engineer
By [signature] Date 3-27-80

Approved in conjunction with '74 Site Plan approved for an addition to main bldg.

INDEX
SHT. 1 SITE PLAN
SHT. 2 PLAN, ELEVATIONS, SECTIONS, TRUSS

STATE OF OHIO 2969 RICE AND STEWART 3274 REGISTERED ARCHITECTS

RICE/STEWART & ASSOCIATES, ARCHITECTS

STORAGE BUILDING
AUBURN CAREER CENTER
CONCORD TWP. OHIO

1
7905