ZONING PERMIT #5976
ISSUED 9-19-88

SUBJECT TO APPROVAL BY:
Lake County Sanitary Eng. ☐
Lake County Eng. Dept. ☒
Lake County Planning Comm. ☐
Lake County Bldg. Dept. ☒

Terry S. Marano

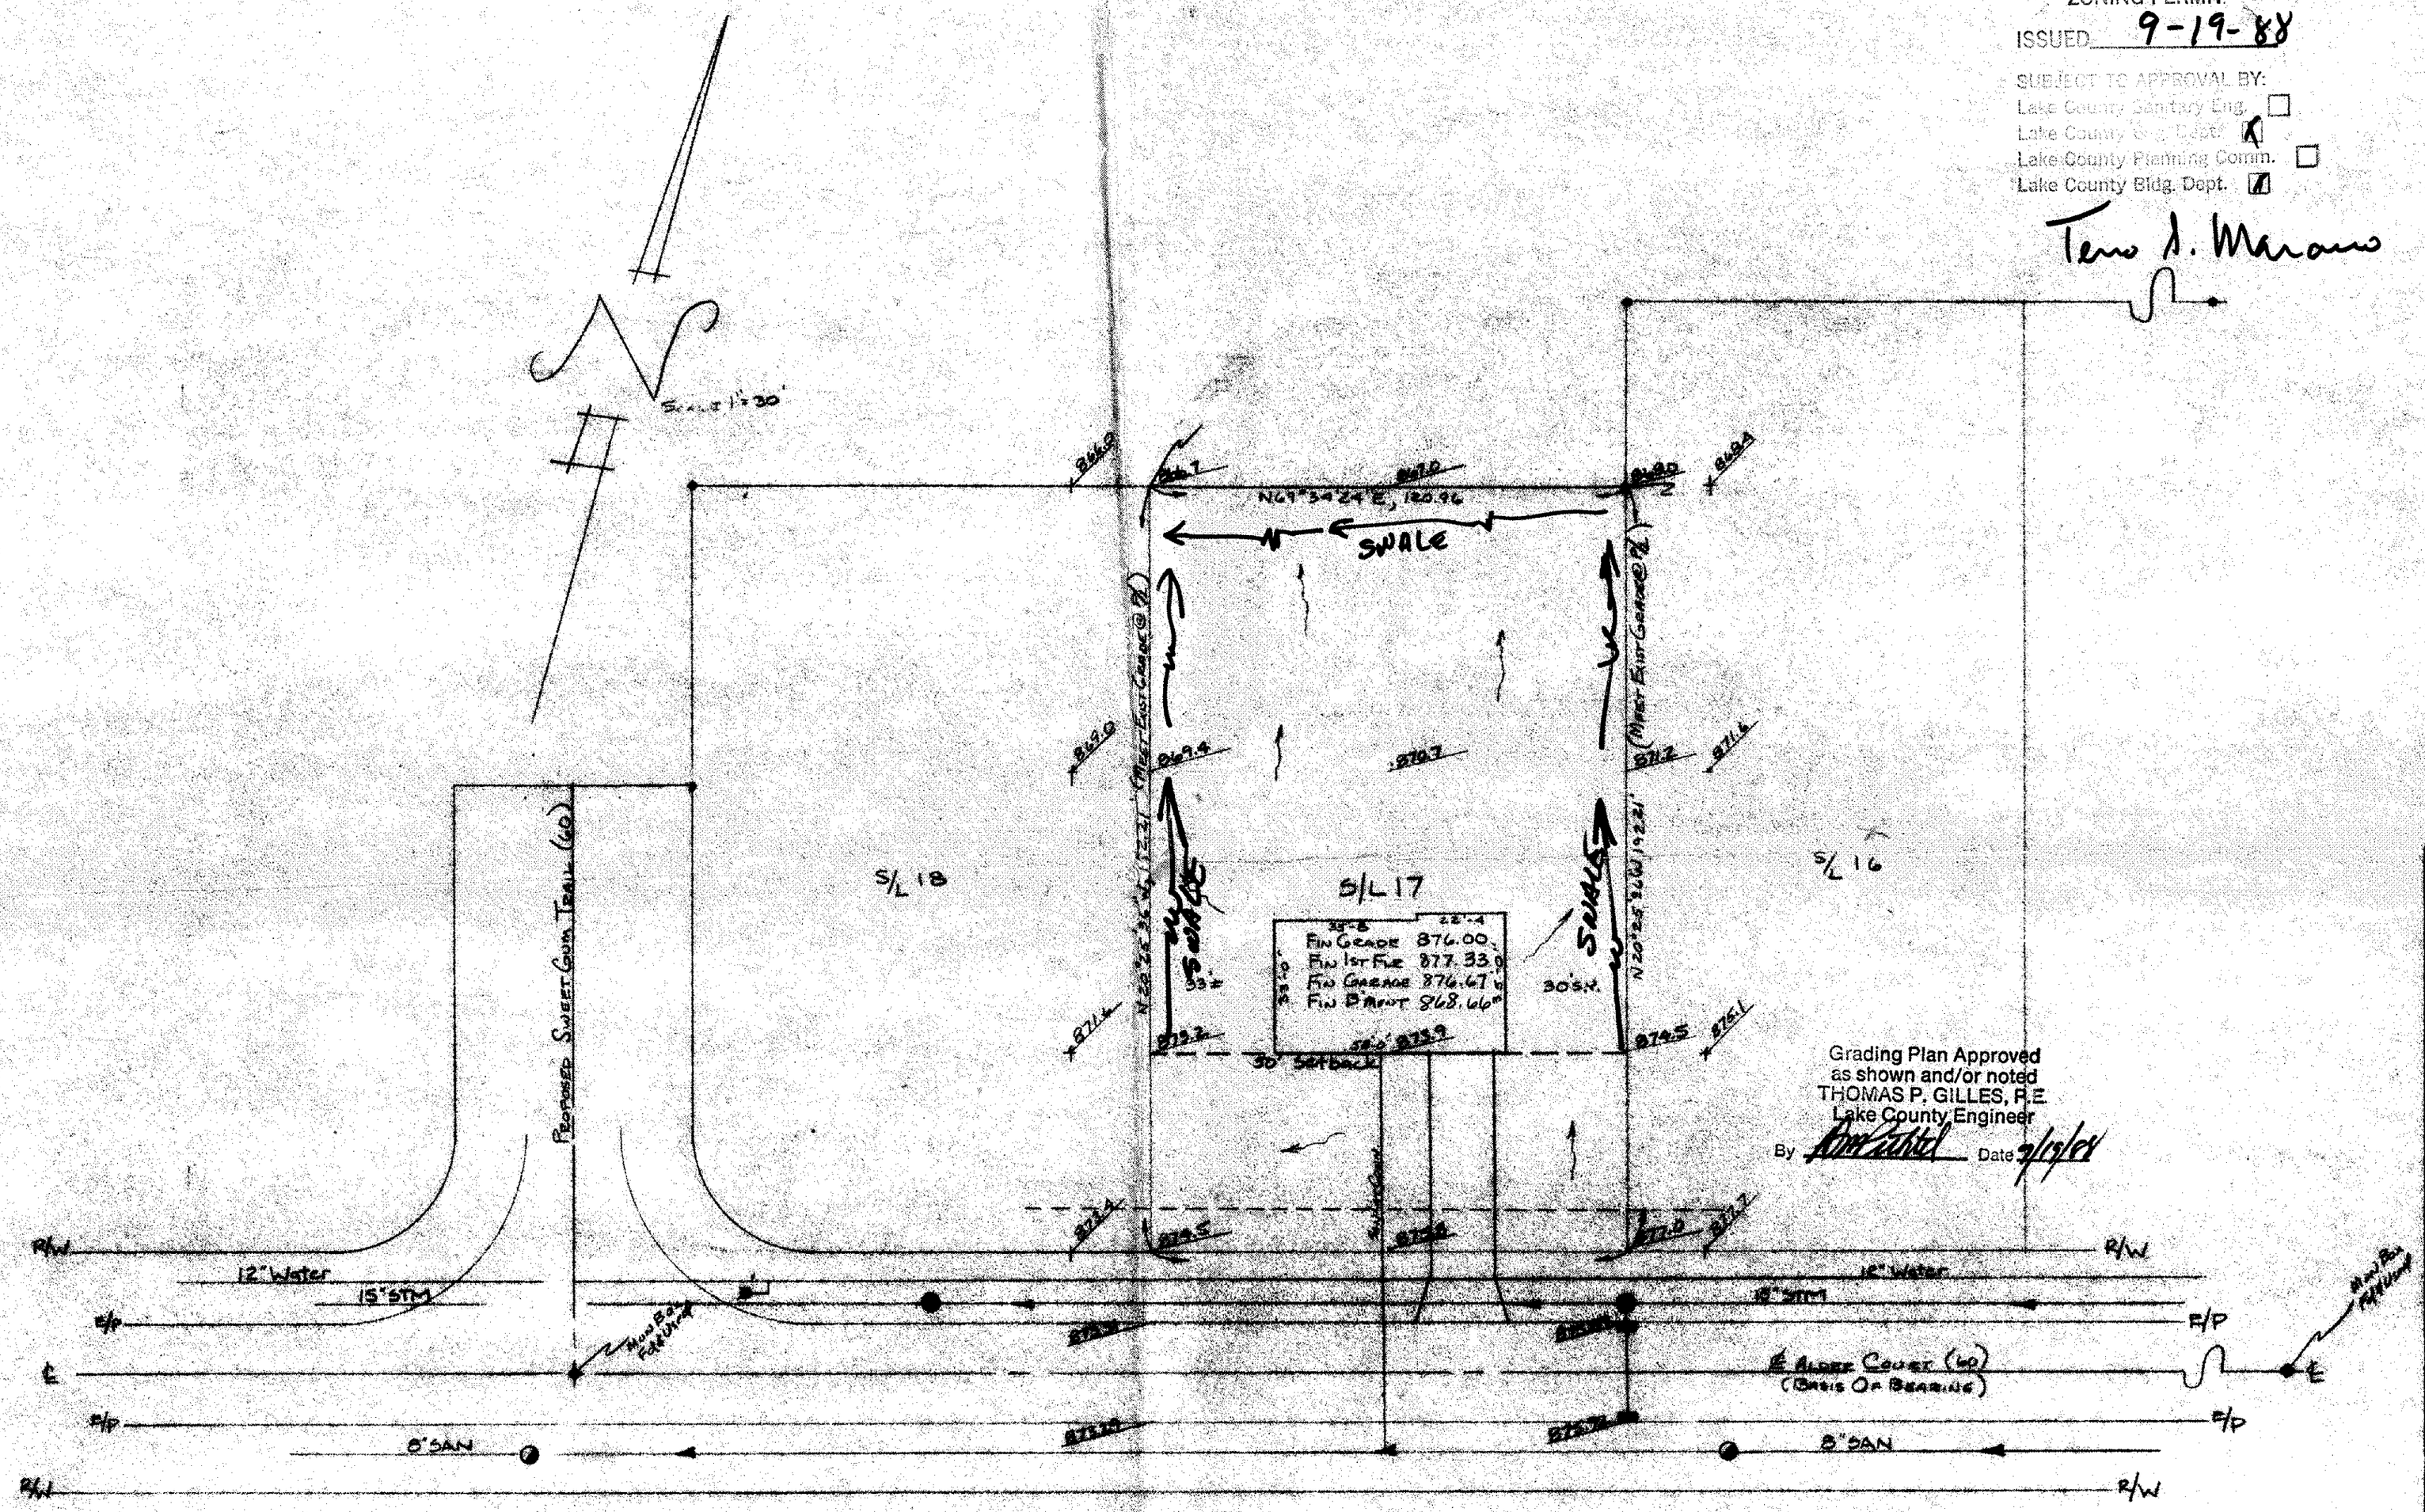

Grading Plan Approved
as shown and/or noted
THOMAS P. GILLES, P.E.
Lake County Engineer
By [signature] Date 9/19/88

PRINTED
SEP 15
WILLIAM R. GRAY
ASSOCIATES, INC.

STATE OF OHIO
TERRENCE
GERSON
6662
REGISTERED
SURVEYOR

WRG
WILLIAM R. GRAY ASSOCIATES, INC.
7519 MENTOR AVENUE MENTOR, OHIO 44060 946-1616

TITLE Site Plan
S/L 17 Morley Hills Estates #4A
DATE 9 Sept 88 DRAWN BY GG REV.

Cliff Shandle - Shandle Const. Co.
8353 Mentor Ave
Mentor Ohio
44024