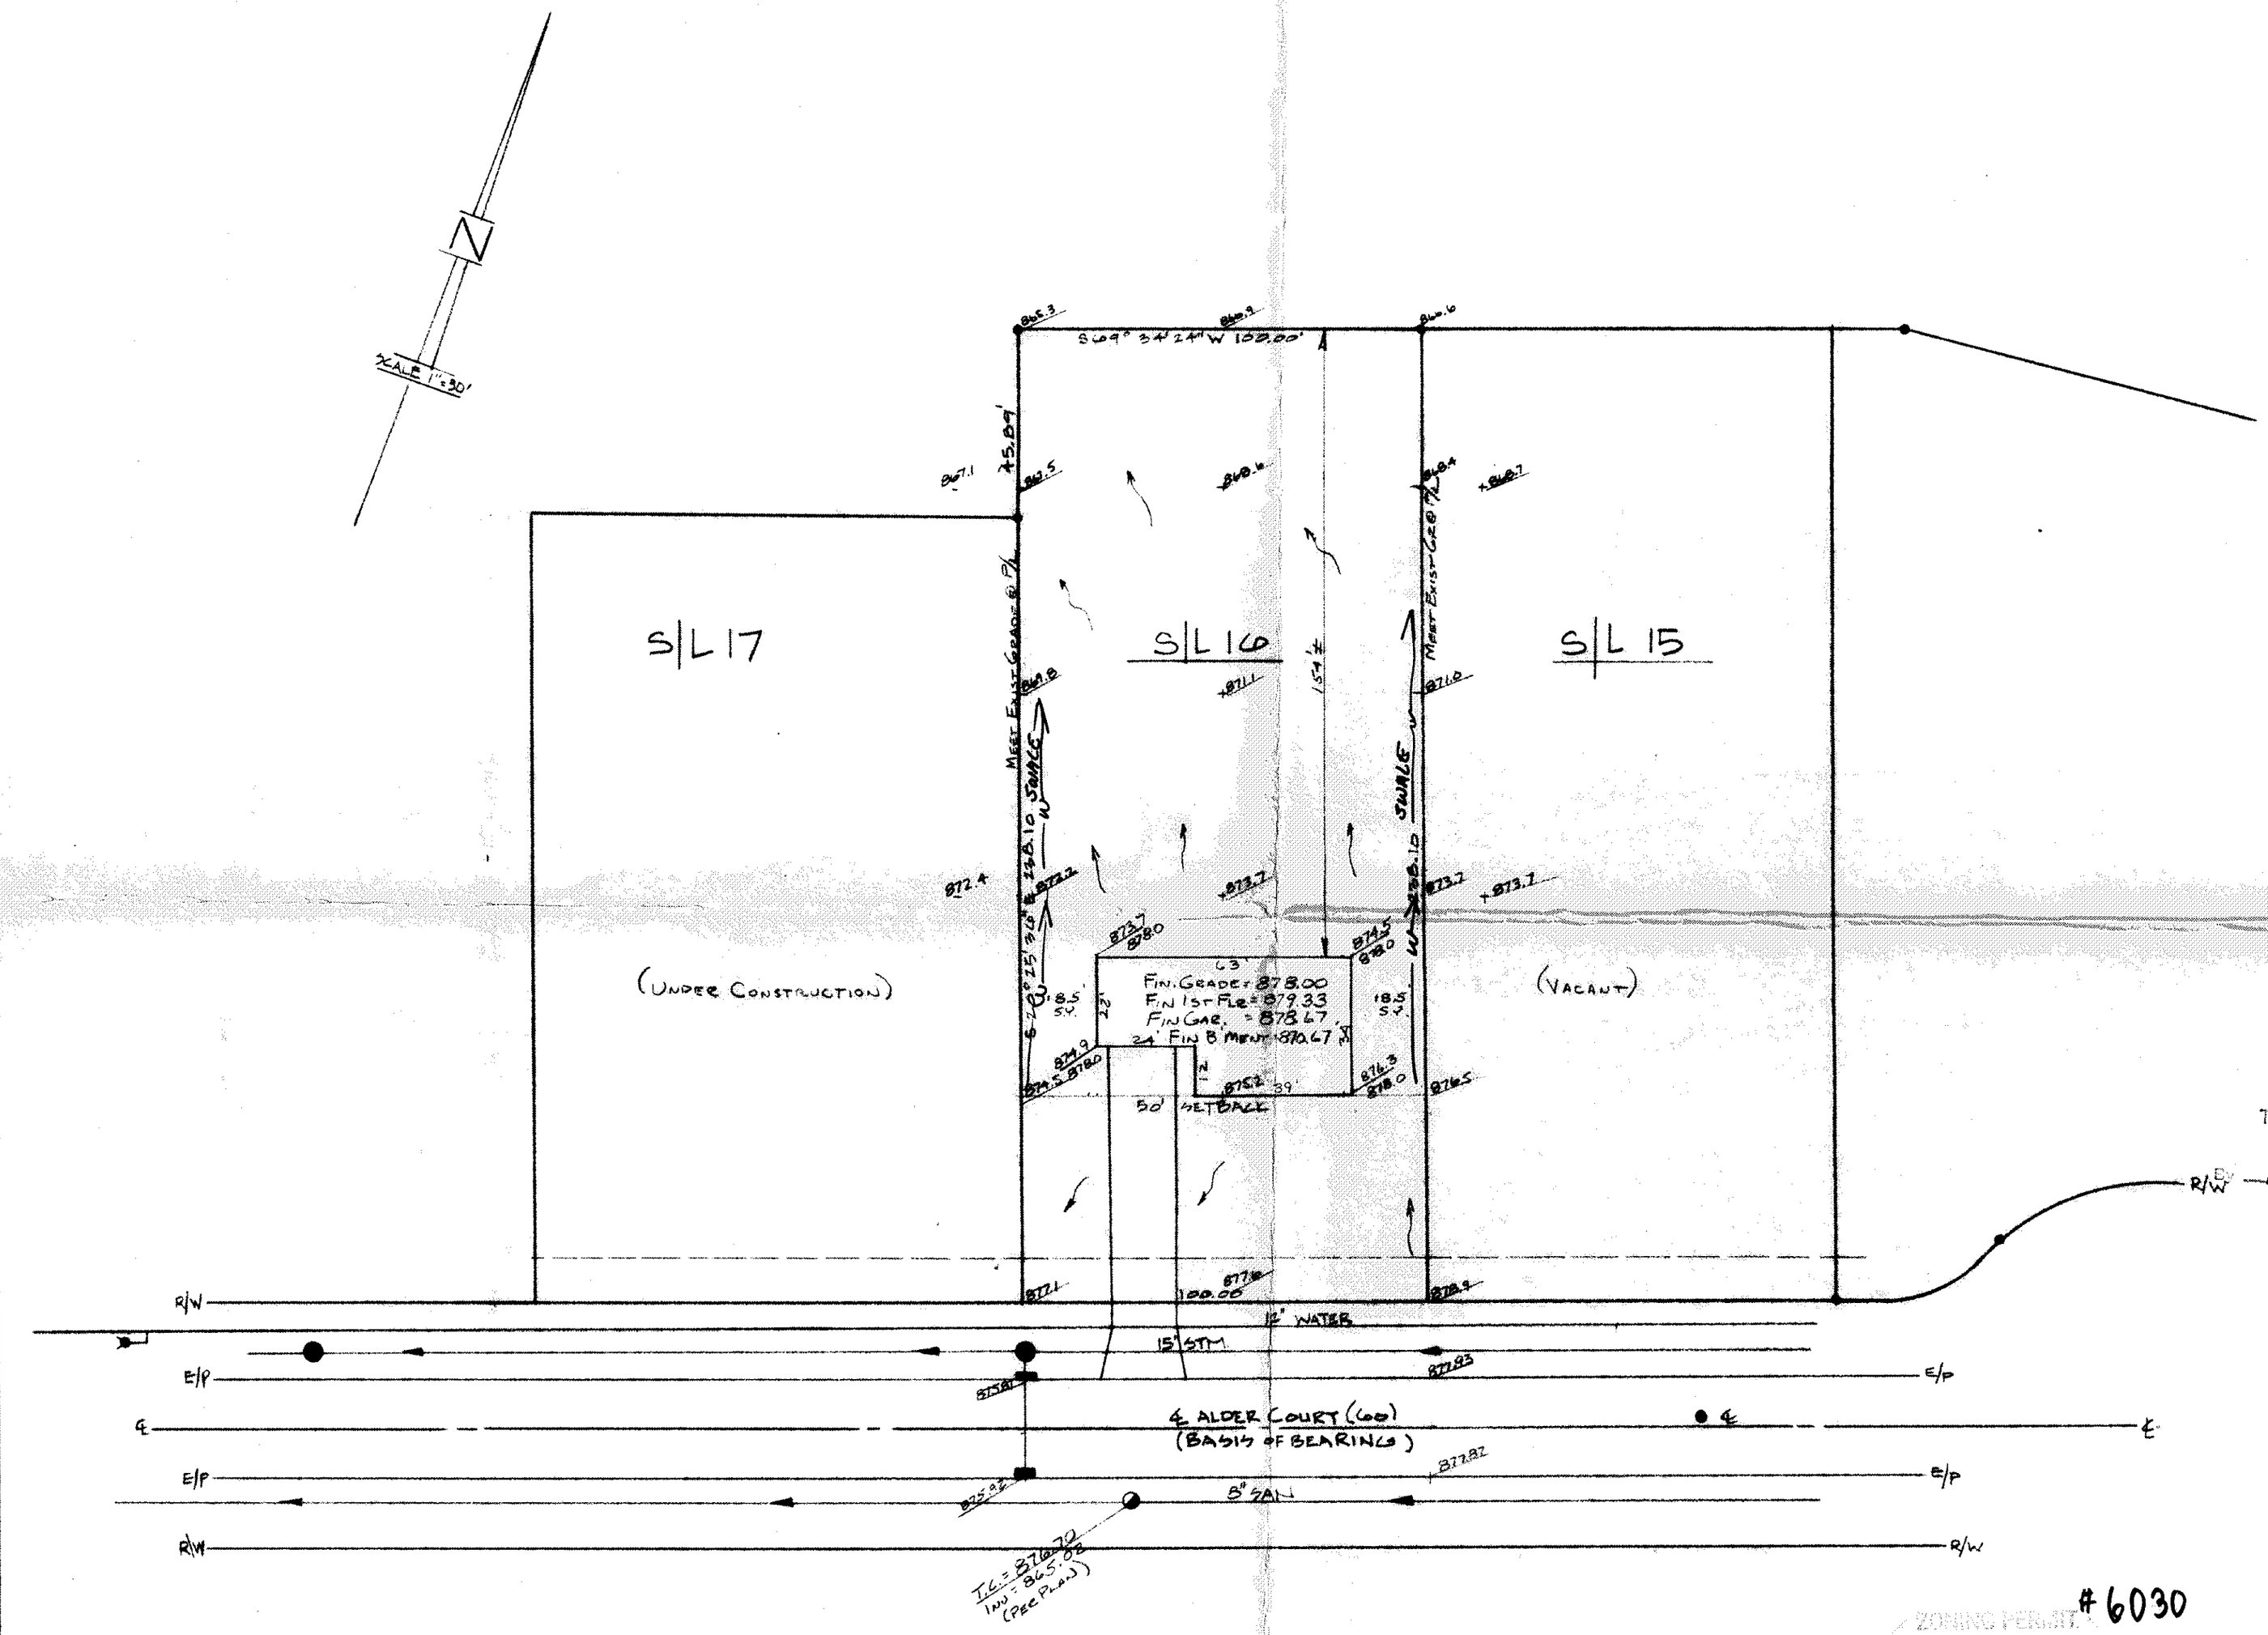


Grading Plan Approved
as shown and/or noted
THOMAS P. GILLES, P.E
Lake County Engineer
By [signature] Date 11/18/88

ZONING PERMIT #6030
ISSUED 11-18-88

Lake County Bldg. Dept. X

Terro J. Marano

STATE OF OHIO
TERRENCE G. GERSON
6662
REGISTERED SURVEYOR

+0.00 EXIST ELEV.
+0.00 PROP. ELEV.

WILLIAM R. GRAY ASSOCIATES, INC.
7519 MENTOR AVENUE MENTOR, OHIO 44060 946-1616

WRG

TITLE: SITE PLAN
S/L 16 MORLEY HILLS ESTATES #4A

DATE: 16 Nov 88
DRAWN BY: G.G./TGG
REV.

CLIFF SHANDLE - SHANDLE CONST. CO.
8353 MENTOR AVE
MENTOR, OHIO
44060