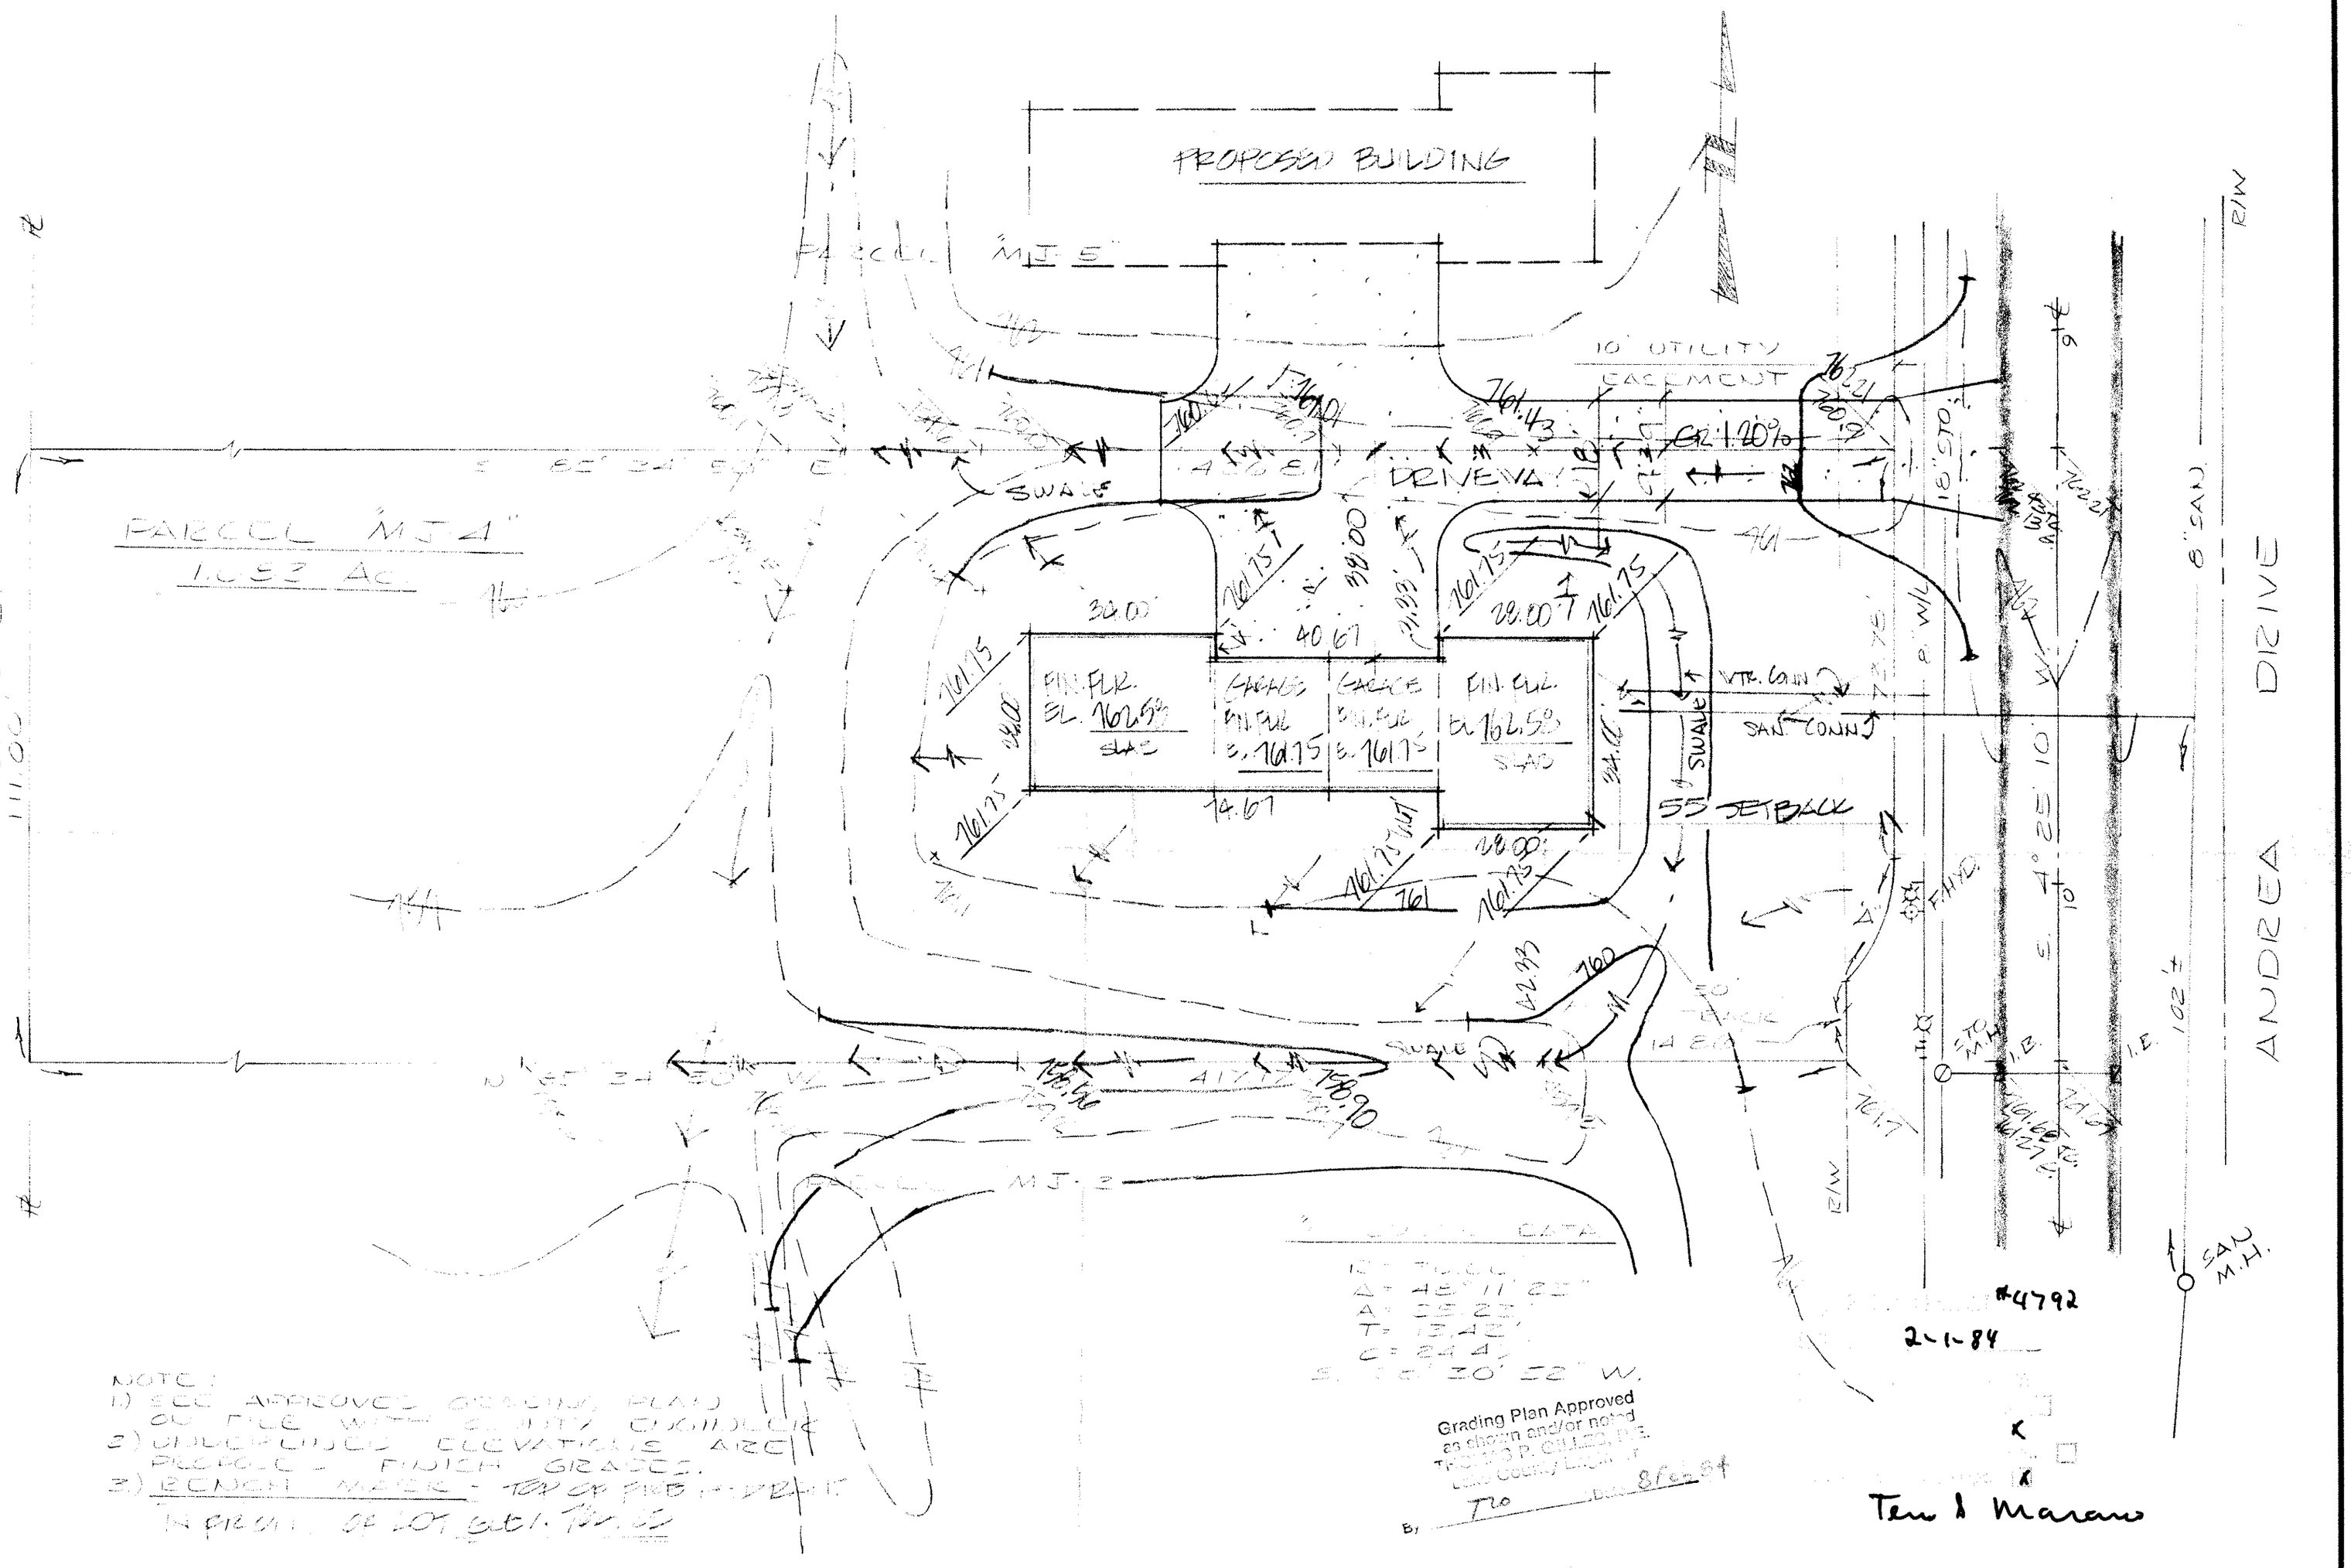

NOTE:
1) SEE APPROVED GRADING PLAN ON FILE WITH COUNTY ENGINEER
2) UNLESS NOTED ELEVATIONS ARE PROPOSED FINISH GRADES.
3) BENCH MARK - TOP OF FIRE HYDRANT IN FRONT OF LOT 5 [illegible]

DESIGN CERTIFICATION	AS BUILT CERTIFICATION
THIS PLAT WAS PREPARED BY ME AND IS CORRECT TO THE BEST OF MY KNOWLEDGE AND BELIEF REG. SURVEYOR NO. [illegible]	I HEREBY CERTIFY THAT THE CIRCLED GRADES ARE EXISTING FINISH GRADES CHECKED IN THE FIELD ON _____ AND THAT SURVEY IS CORRECT TO THE BEST OF MY KNOWLEDGE AND BELIEF. REG. SURVEYOR NO. _____

SITE PLAN FOR:
SNAVELY COMPANY
PARCEL "MJ-4" SHADY KNOLL SUBDIVISION No. 2
CONCORD TOWNSHIP, LAKE COUNTY, OHIO

#4792

DATE Jan. 27, 1984
SCALE 1"=20'
DRAWN BY GS
CH'K'D BY
F.B.# 481 PG. 17

COLPETZER · WOODS
CONSULTANTS, INC.
MENTOR, OHIO 44060

SHEET 1 OF 1
CONTRACT NO. 83-520