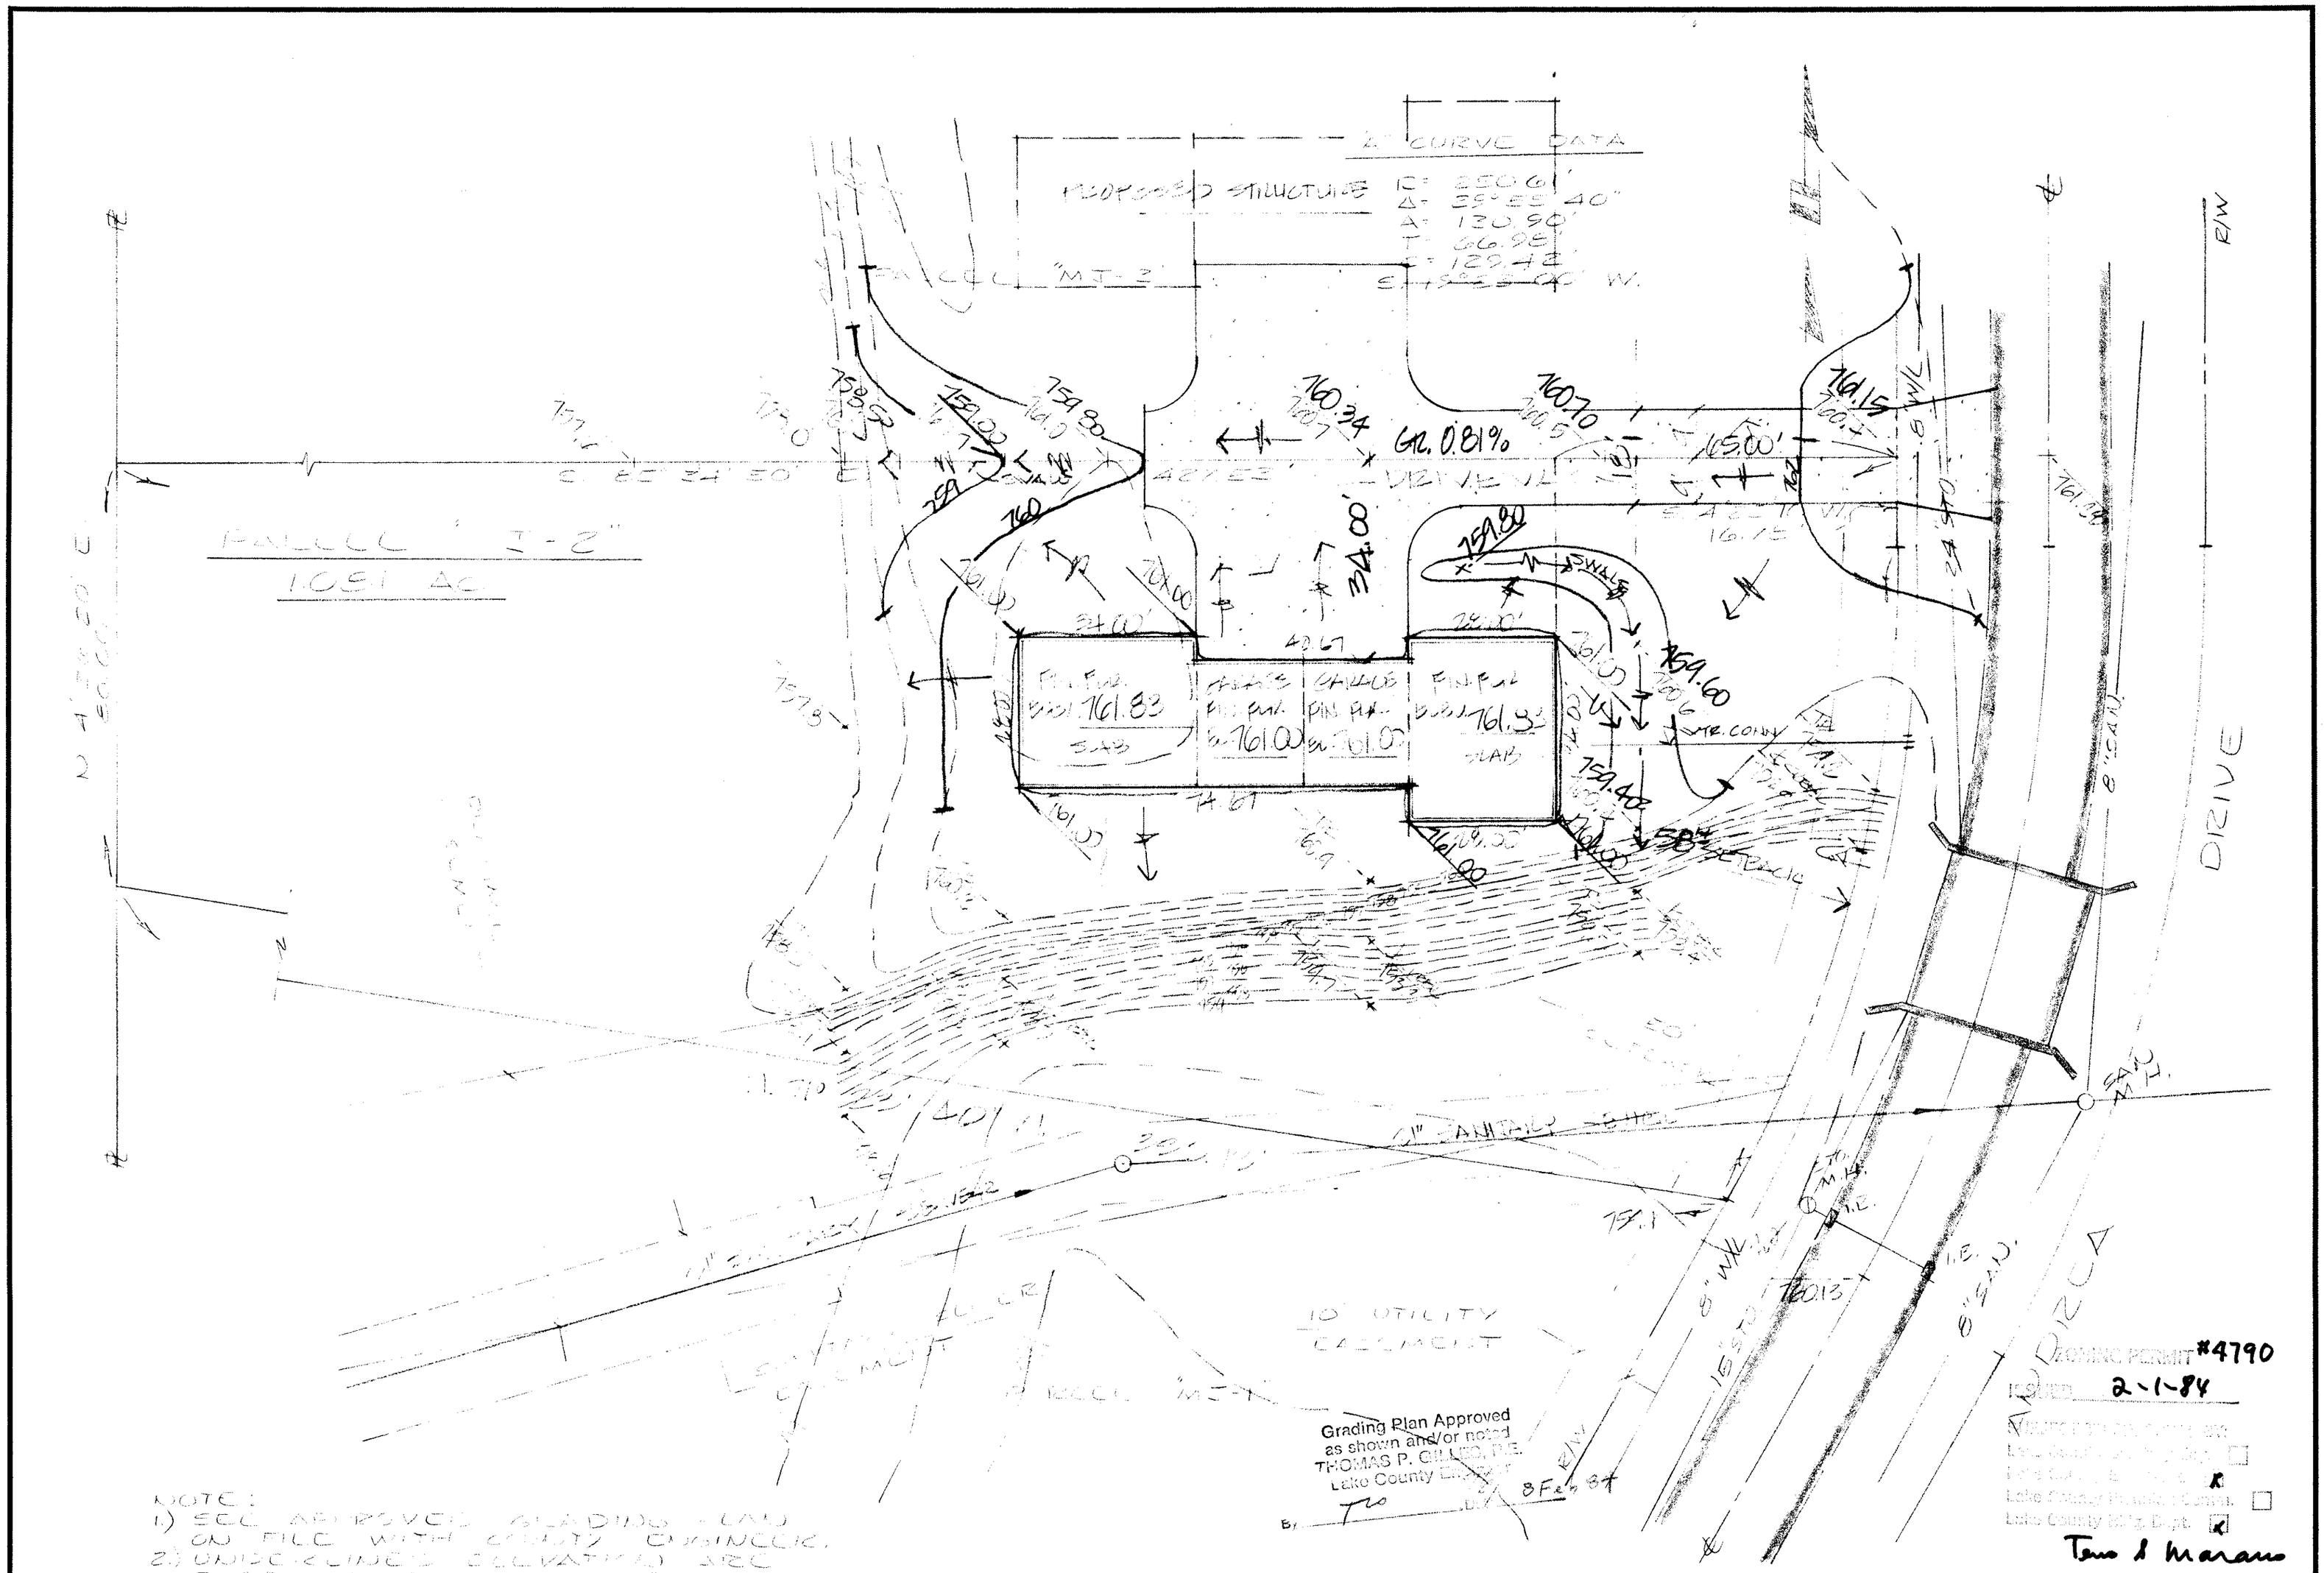

Grading Plan Approved as shown and/or noted
THOMAS P. GILLES, P.E.
Lake County Engineer
By [signature] Date 8 Feb 84

ZONING PERMIT #4790
ISSUED 2-1-84
Lake County Planning Comm. ☐
Lake County Bldg. Dept. ☒
Tens S Marano

NOTE:
1.) SEE APPROVED GRADING PLAN ON FILE WITH COUNTY ENGINEER.
2.) UNDERLINED ELEVATIONS ARE PROPOSED FINISH GRADES.
3.) BENCH MARK - TOP OF FIRE HYDRANT IN FRONT OF SU MJ-4 ELEV. 764.25

DESIGN CERTIFICATION	AS BUILT CERTIFICATION
THIS PLAT WAS PREPARED BY ME, AND IS CORRECT TO THE BEST OF MY KNOWLEDGE AND BELIEF. [signature] REG. SURVEYOR NO 4642	I HEREBY CERTIFY THAT THE CIRCLED GRADES ARE EXISTING FINISH GRADES CHECKED IN THE FIELD ON _____ AND THAT SURVEY IS CORRECT TO THE BEST OF MY KNOWLEDGE AND BELIEF. REG. SURVEYOR NO _____

SITE PLAN FOR:
SNAVELY COMPANY #4790
PARCEL "MJ-2" SHADY KNOLL SUBDIVISION No. 2
CONCORD TOWNSHIP, LAKE COUNTY, OHIO

DATE JAN 27, 1984
SCALE 1"=20'
DRAWN BY CB
CH'K'D BY
F.B. #481 PG. 127

COLPETZER · WOODS
CONSULTANTS, INC.
MENTOR, OHIO 44060

SHEET 1 OF 1
CONTRACT NO. 83-520