NOTES:
1.) SEE APPROVED GRADING PLAN ON FILE WITH THE COUNTY ENGINEER.
2.) UNDERLINED ELEVATIONS ARE PROPOSED FINISH GRADES.
3.) BENCH MARK:
TOP OF F. HYD. SUBLOT "C"
ELEV. 765.68

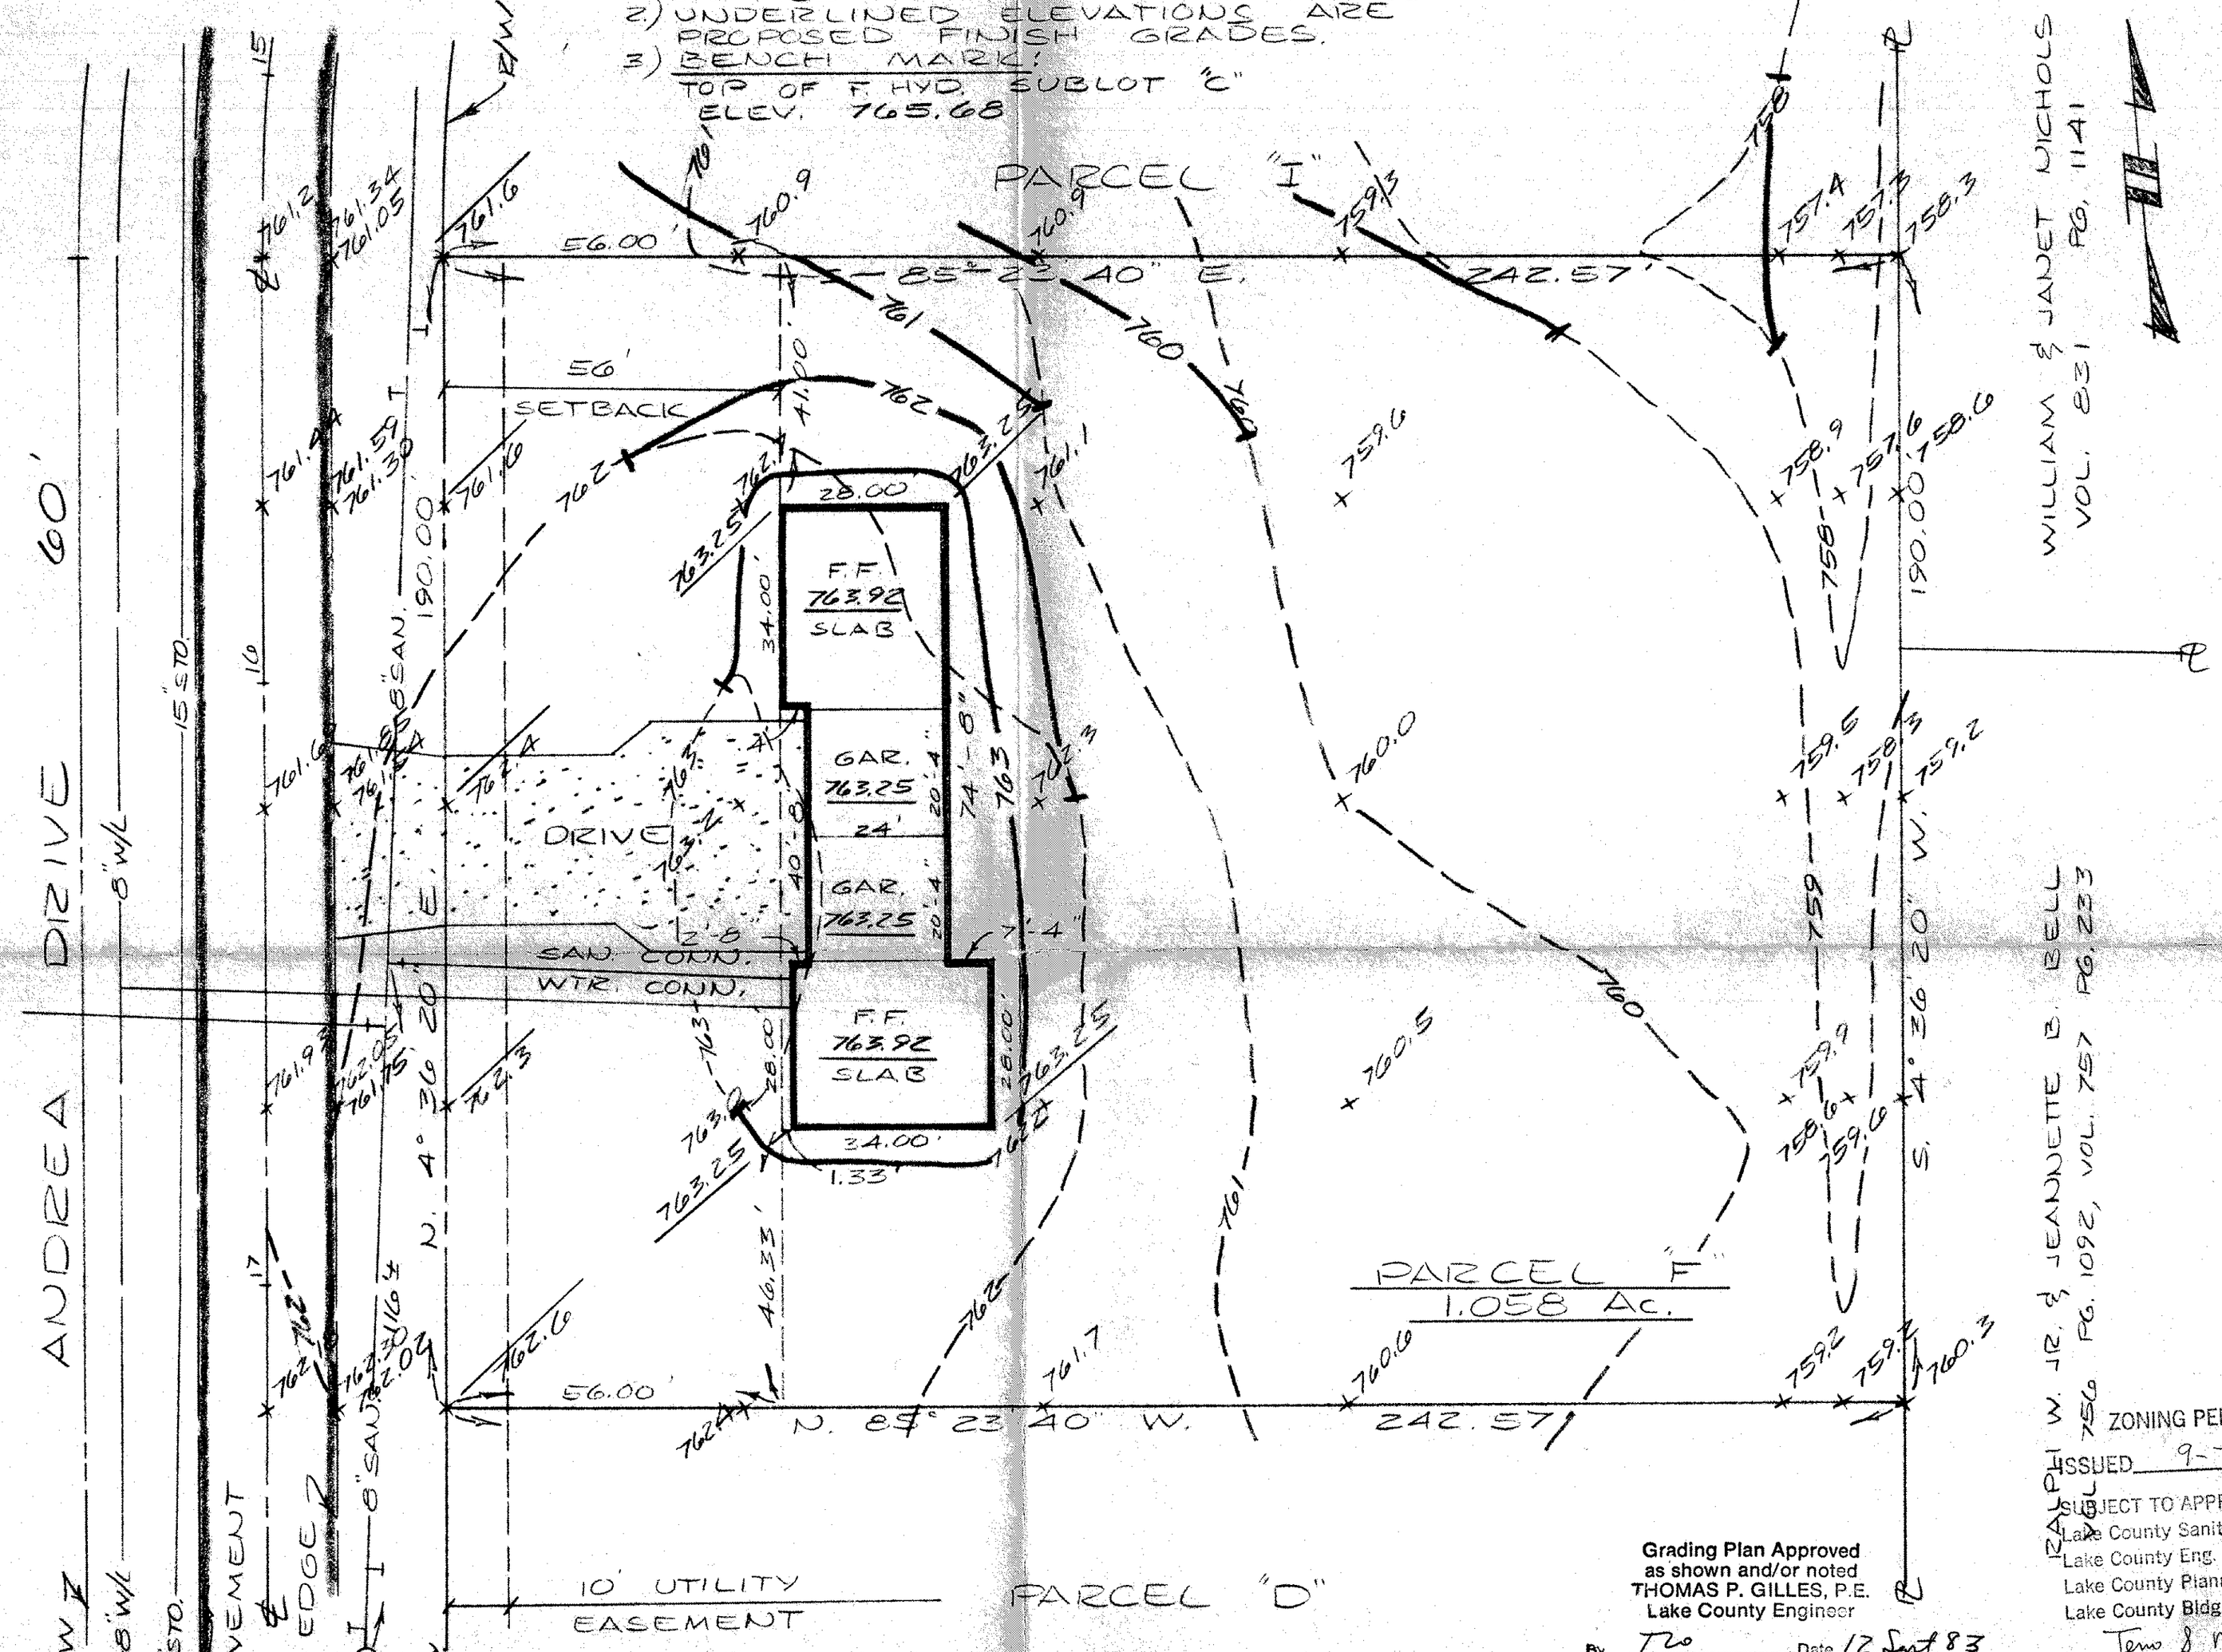

Grading Plan Approved
as shown and/or noted
THOMAS P. GILLES, P.E.
Lake County Engineer
By TLO Date 12 Sept 83

ZONING PERMIT #4702
ISSUED 9-7-83
SUBJECT TO APPROVAL BY:
Lake County Sanitary Eng. ☐
Lake County Eng. Dept. ☒
Lake County Planning Comm. ☐
Lake County Bldg. Dept. ☒
Terry S. Marano

DESIGN CERTIFICATION	AS BUILT CERTIFICATION
THIS PLAT WAS PREPARED BY ME AND IS CORRECT TO THE BEST OF MY KNOWLEDGE AND BELIEF.	I HEREBY CERTIFY THAT THE CIRCLED GRADES ARE EXISTING FINISH GRADES CHECKED IN THE FIELD ON _____ AND THAT SURVEY IS CORRECT TO THE BEST OF MY KNOWLEDGE AND BELIEF.
REG. SURVEYOR NO. 4167	REG. SURVEYOR NO. _____

SITE PLAN FOR:
SNAVELY COMPANY
PARCEL "F" SHADY KNOLL SUBDIVISION
CONCORD TOWNSHIP, LAKE COUNTY, OHIO

DATE 9-1-83
SCALE 1"=20'
DRAWN BY
CH'K'D BY
F.B.# PG.

COLPETZER · WOODS
CONSULTANTS, INC.
MENTOR, OHIO 44060

SHEET 1 OF 1
CONTRACT NO. 83-520