NOTES:
1.) SEE APPROVED GRADING PLAN ON FILE WITH THE COUNTY ENGINEER
2.) UNDERLINED ELEVATIONS ARE PROPOSED FINISH GRADES.
3.) BENCH MARK: RIM OF SAN. M.H. #5 ELEV. 765.85

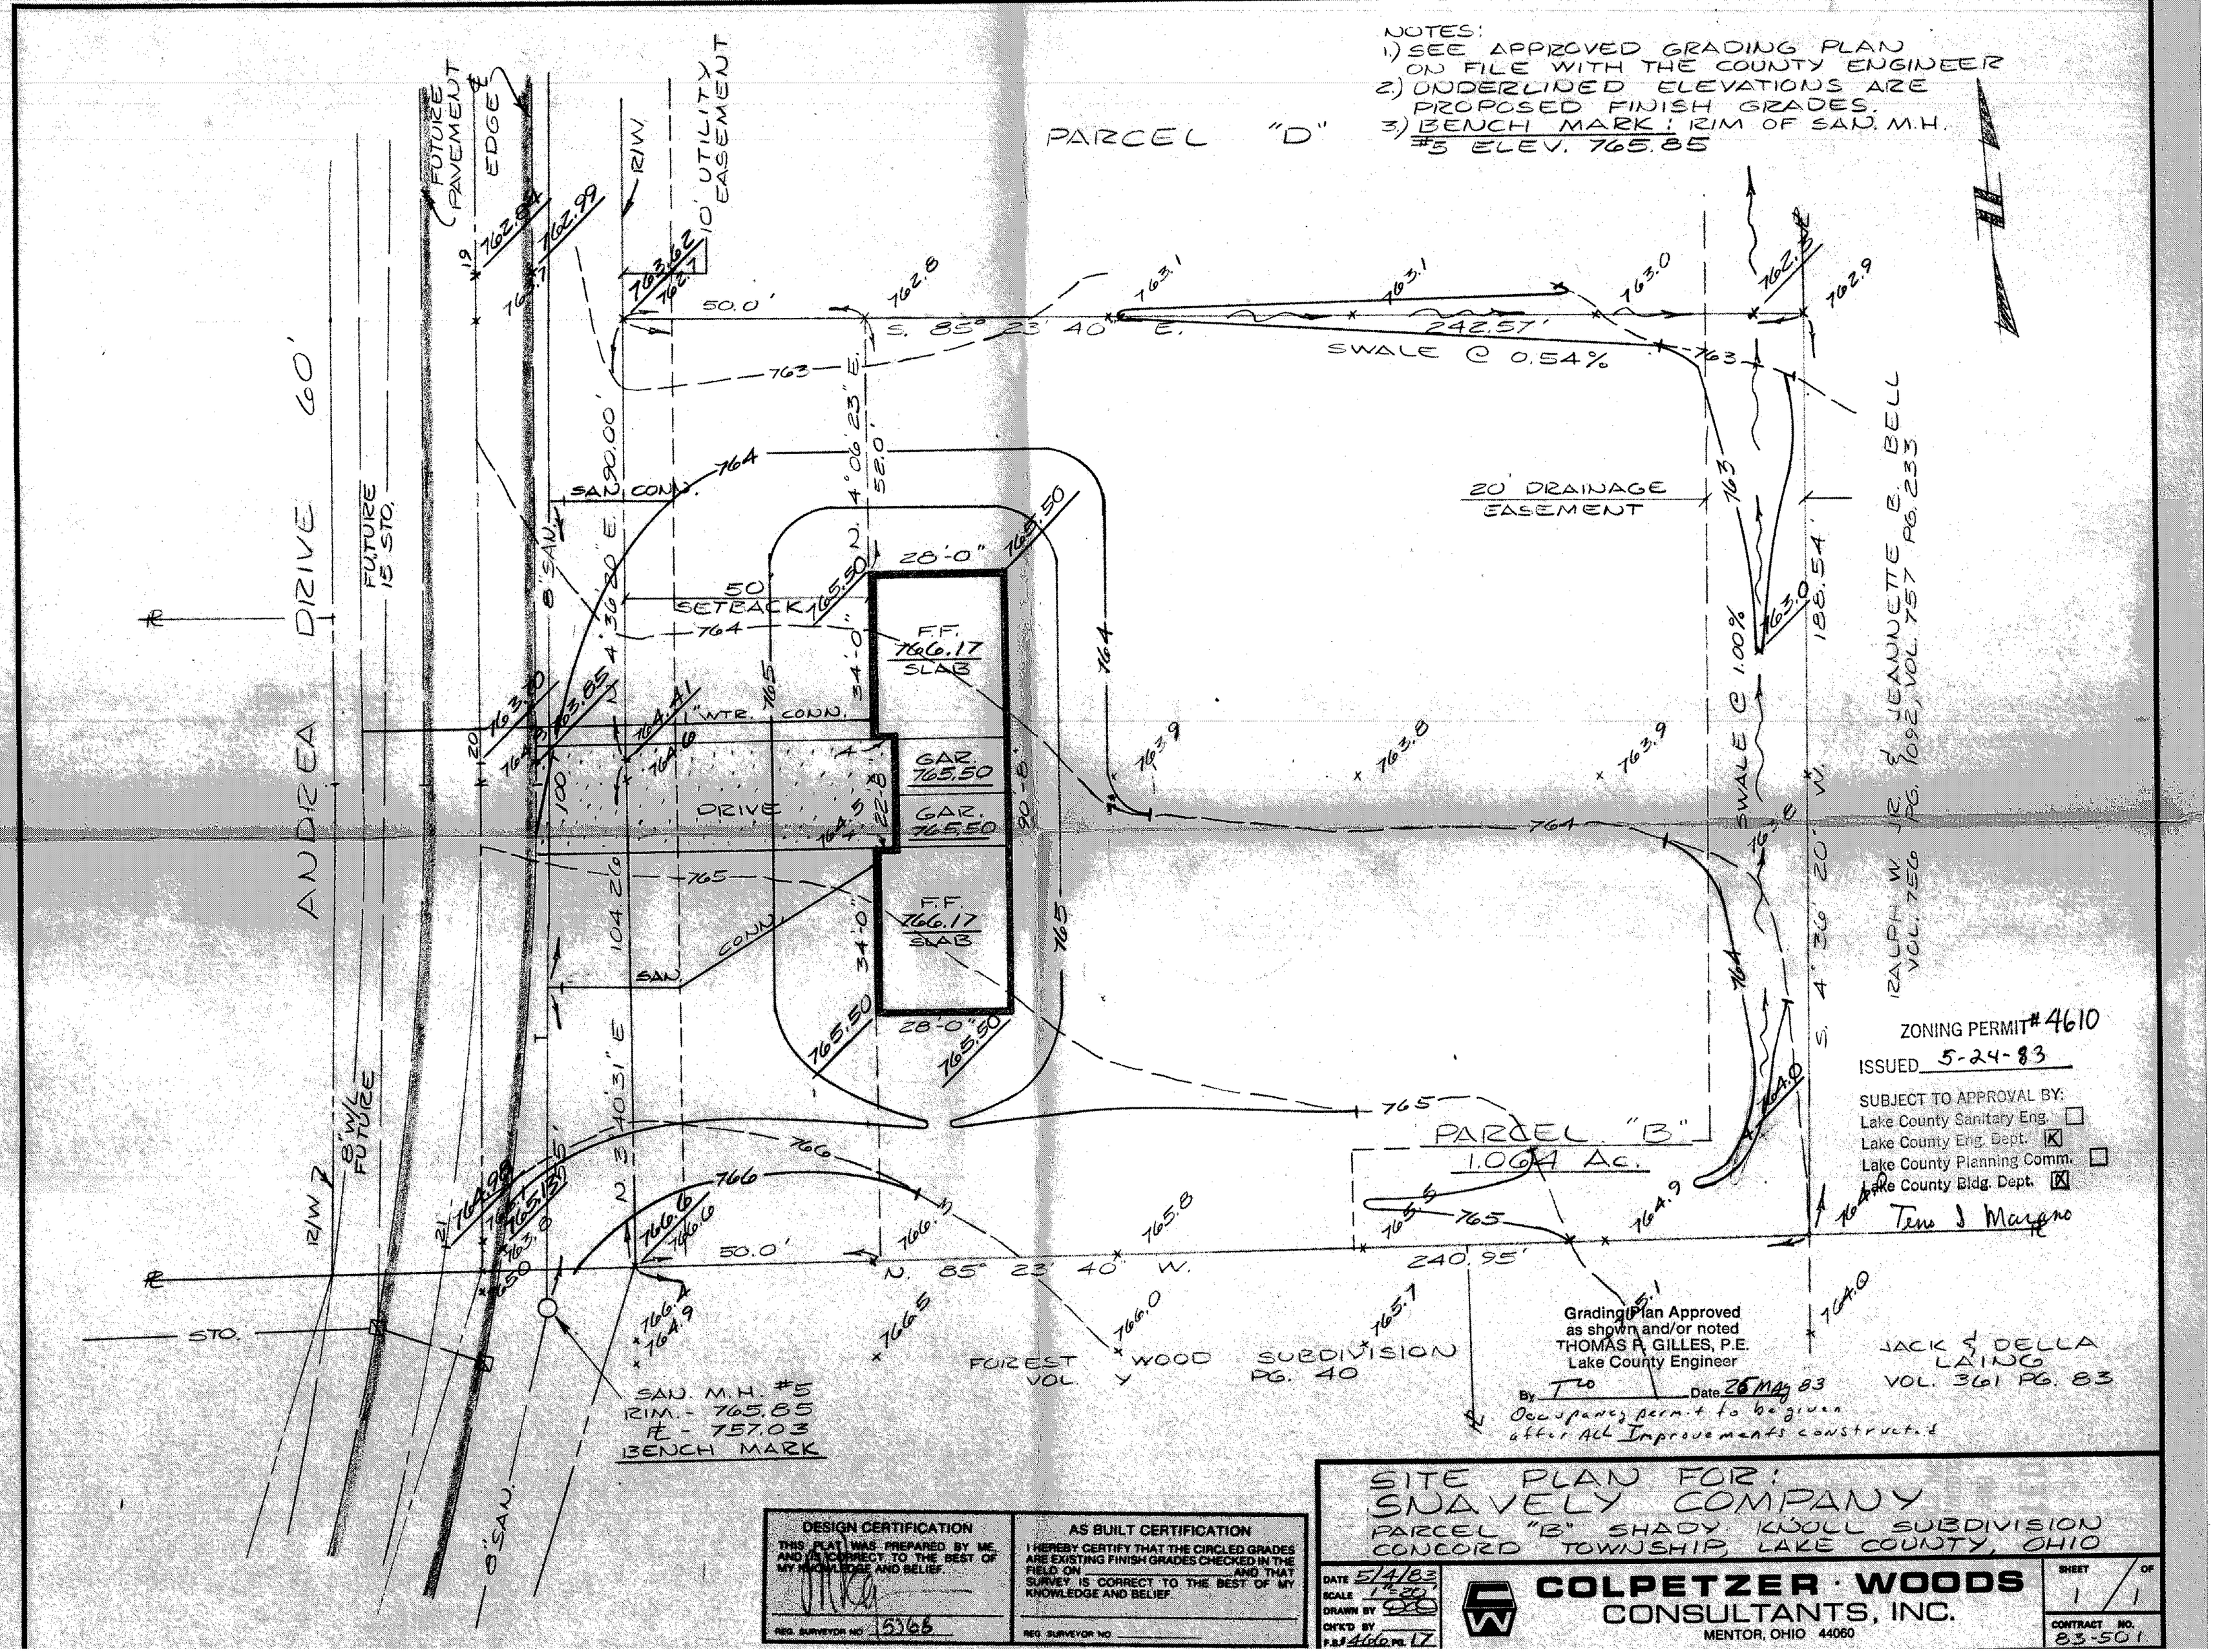

DESIGN CERTIFICATION

THIS PLAT WAS PREPARED BY ME, AND IS CORRECT TO THE BEST OF MY KNOWLEDGE AND BELIEF.

REG. SURVEYOR NO 5368

AS BUILT CERTIFICATION

I HEREBY CERTIFY THAT THE CIRCLED GRADES ARE EXISTING FINISH GRADES CHECKED IN THE FIELD ON _____ AND THAT SURVEY IS CORRECT TO THE BEST OF MY KNOWLEDGE AND BELIEF.

REG. SURVEYOR NO _____

SITE PLAN FOR: SNAVELY COMPANY

PARCEL "B" SHADY KNOLL SUBDIVISION
CONCORD TOWNSHIP, LAKE COUNTY, OHIO

DATE 5/4/83
SCALE 1"=20'
DRAWN BY
CH'K'D BY
P.B. 4 PG. 17

COLPETZER · WOODS
CONSULTANTS, INC.
MENTOR, OHIO 44060

SHEET 1 OF 1
CONTRACT NO. 83-501