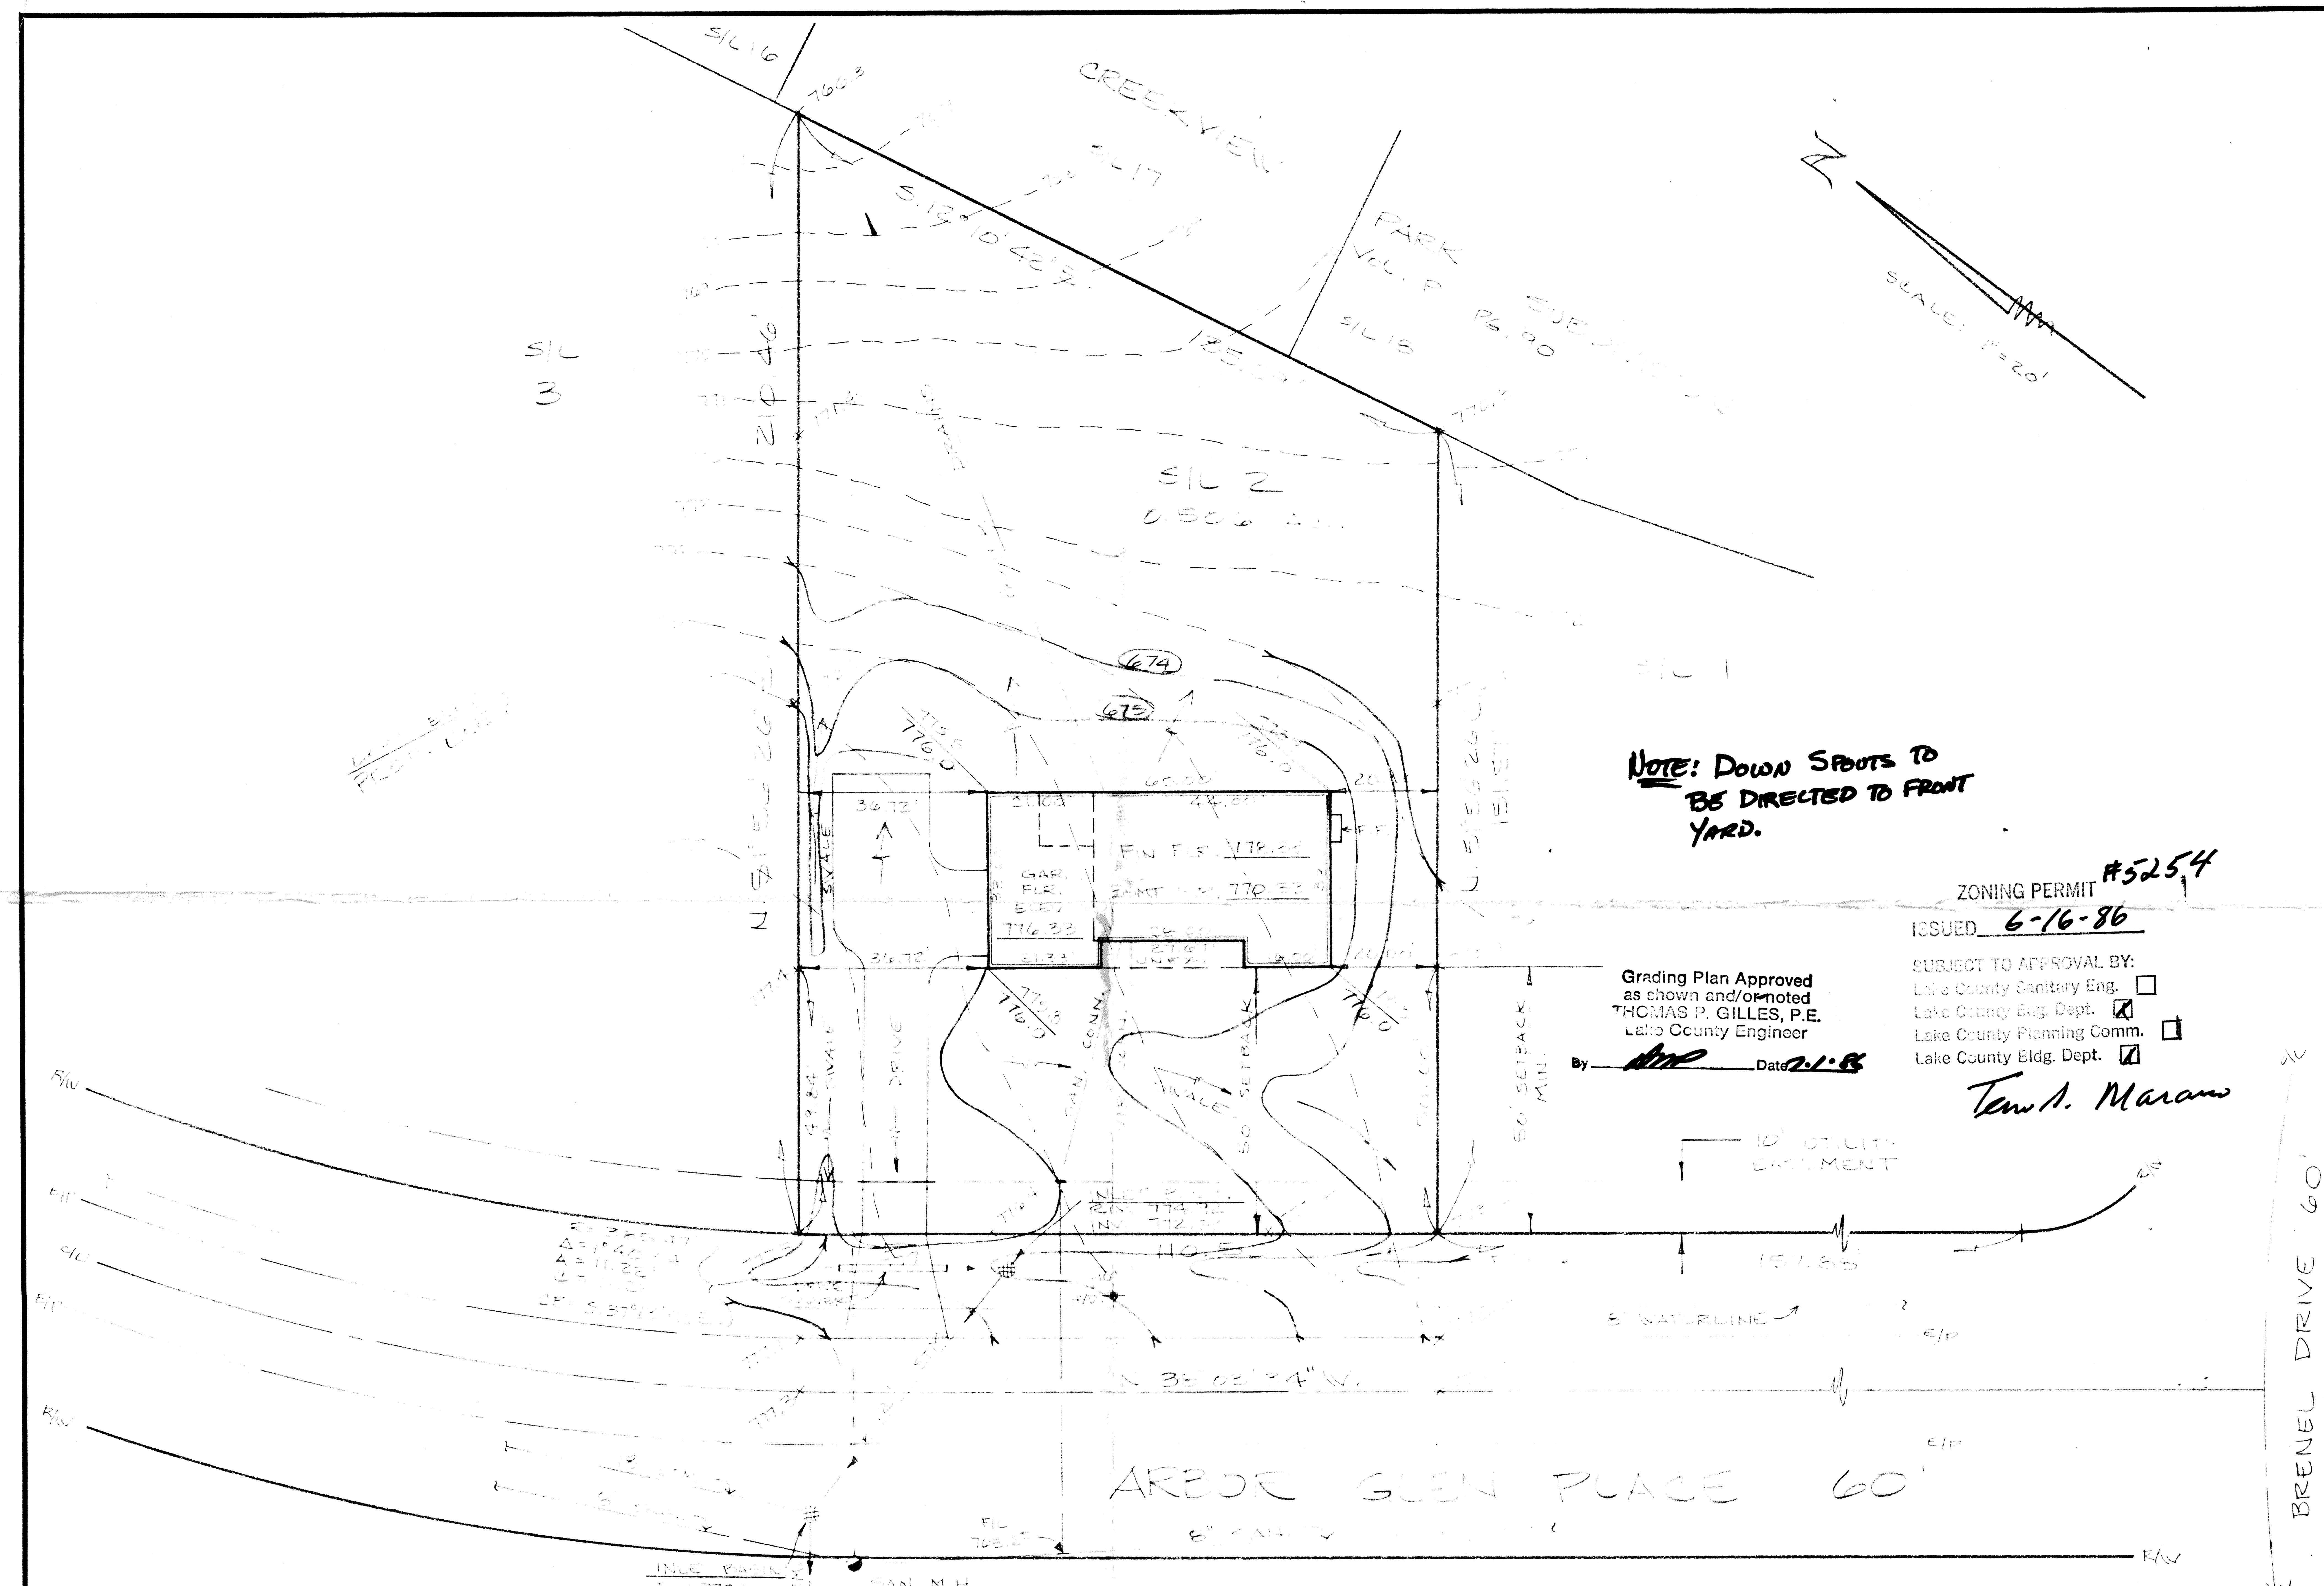

NOTE: DOWN SPOUTS TO BE DIRECTED TO FRONT YARD.

ZONING PERMIT #5254
ISSUED 6-16-86
SUBJECT TO APPROVAL BY:
Lake County Sanitary Eng. ☐
Lake County Eng. Dept. ☑
Lake County Planning Comm. ☐
Lake County Bldg. Dept. ☑
Tom A. Marano

Grading Plan Approved as shown and/or noted
THOMAS P. GILLES, P.E.
Lake County Engineer
By [signature] Date 2-1-8[illegible]

BENCHMARK
RIM SAN. M.H.
[illegible] 761.64

RICHARD BILSKI 5244
STATE OF OHIO
REGISTERED SURVEYOR

CERTIFICATION
THIS PLAT WAS PREPARED BY ME AND IS CORRECT TO THE BEST OF MY KNOWLEDGE AND BELIEF
[signature]
REG. SURVEYOR NO. 5244

SITE PLAN FOR SCOTT ANDREWS
BEING S/L 2 OF ARBOR GLEN SUBDIVISION PHASE I,
VOL. 5 PG. 40,
CONCORD TOWNSHIP, LAKE COUNTY, OHIO

DATE	6-5-86
SCALE	1"=20'
DRAWN BY	RLS
CH'K'D BY	
F.B.#	514 PG. 39

COLPETZER · WOODS
CONSULTANTS, INC.
MENTOR, OHIO 44060

SHEET 1 OF 1
CONTRACT NO. 85-820-002