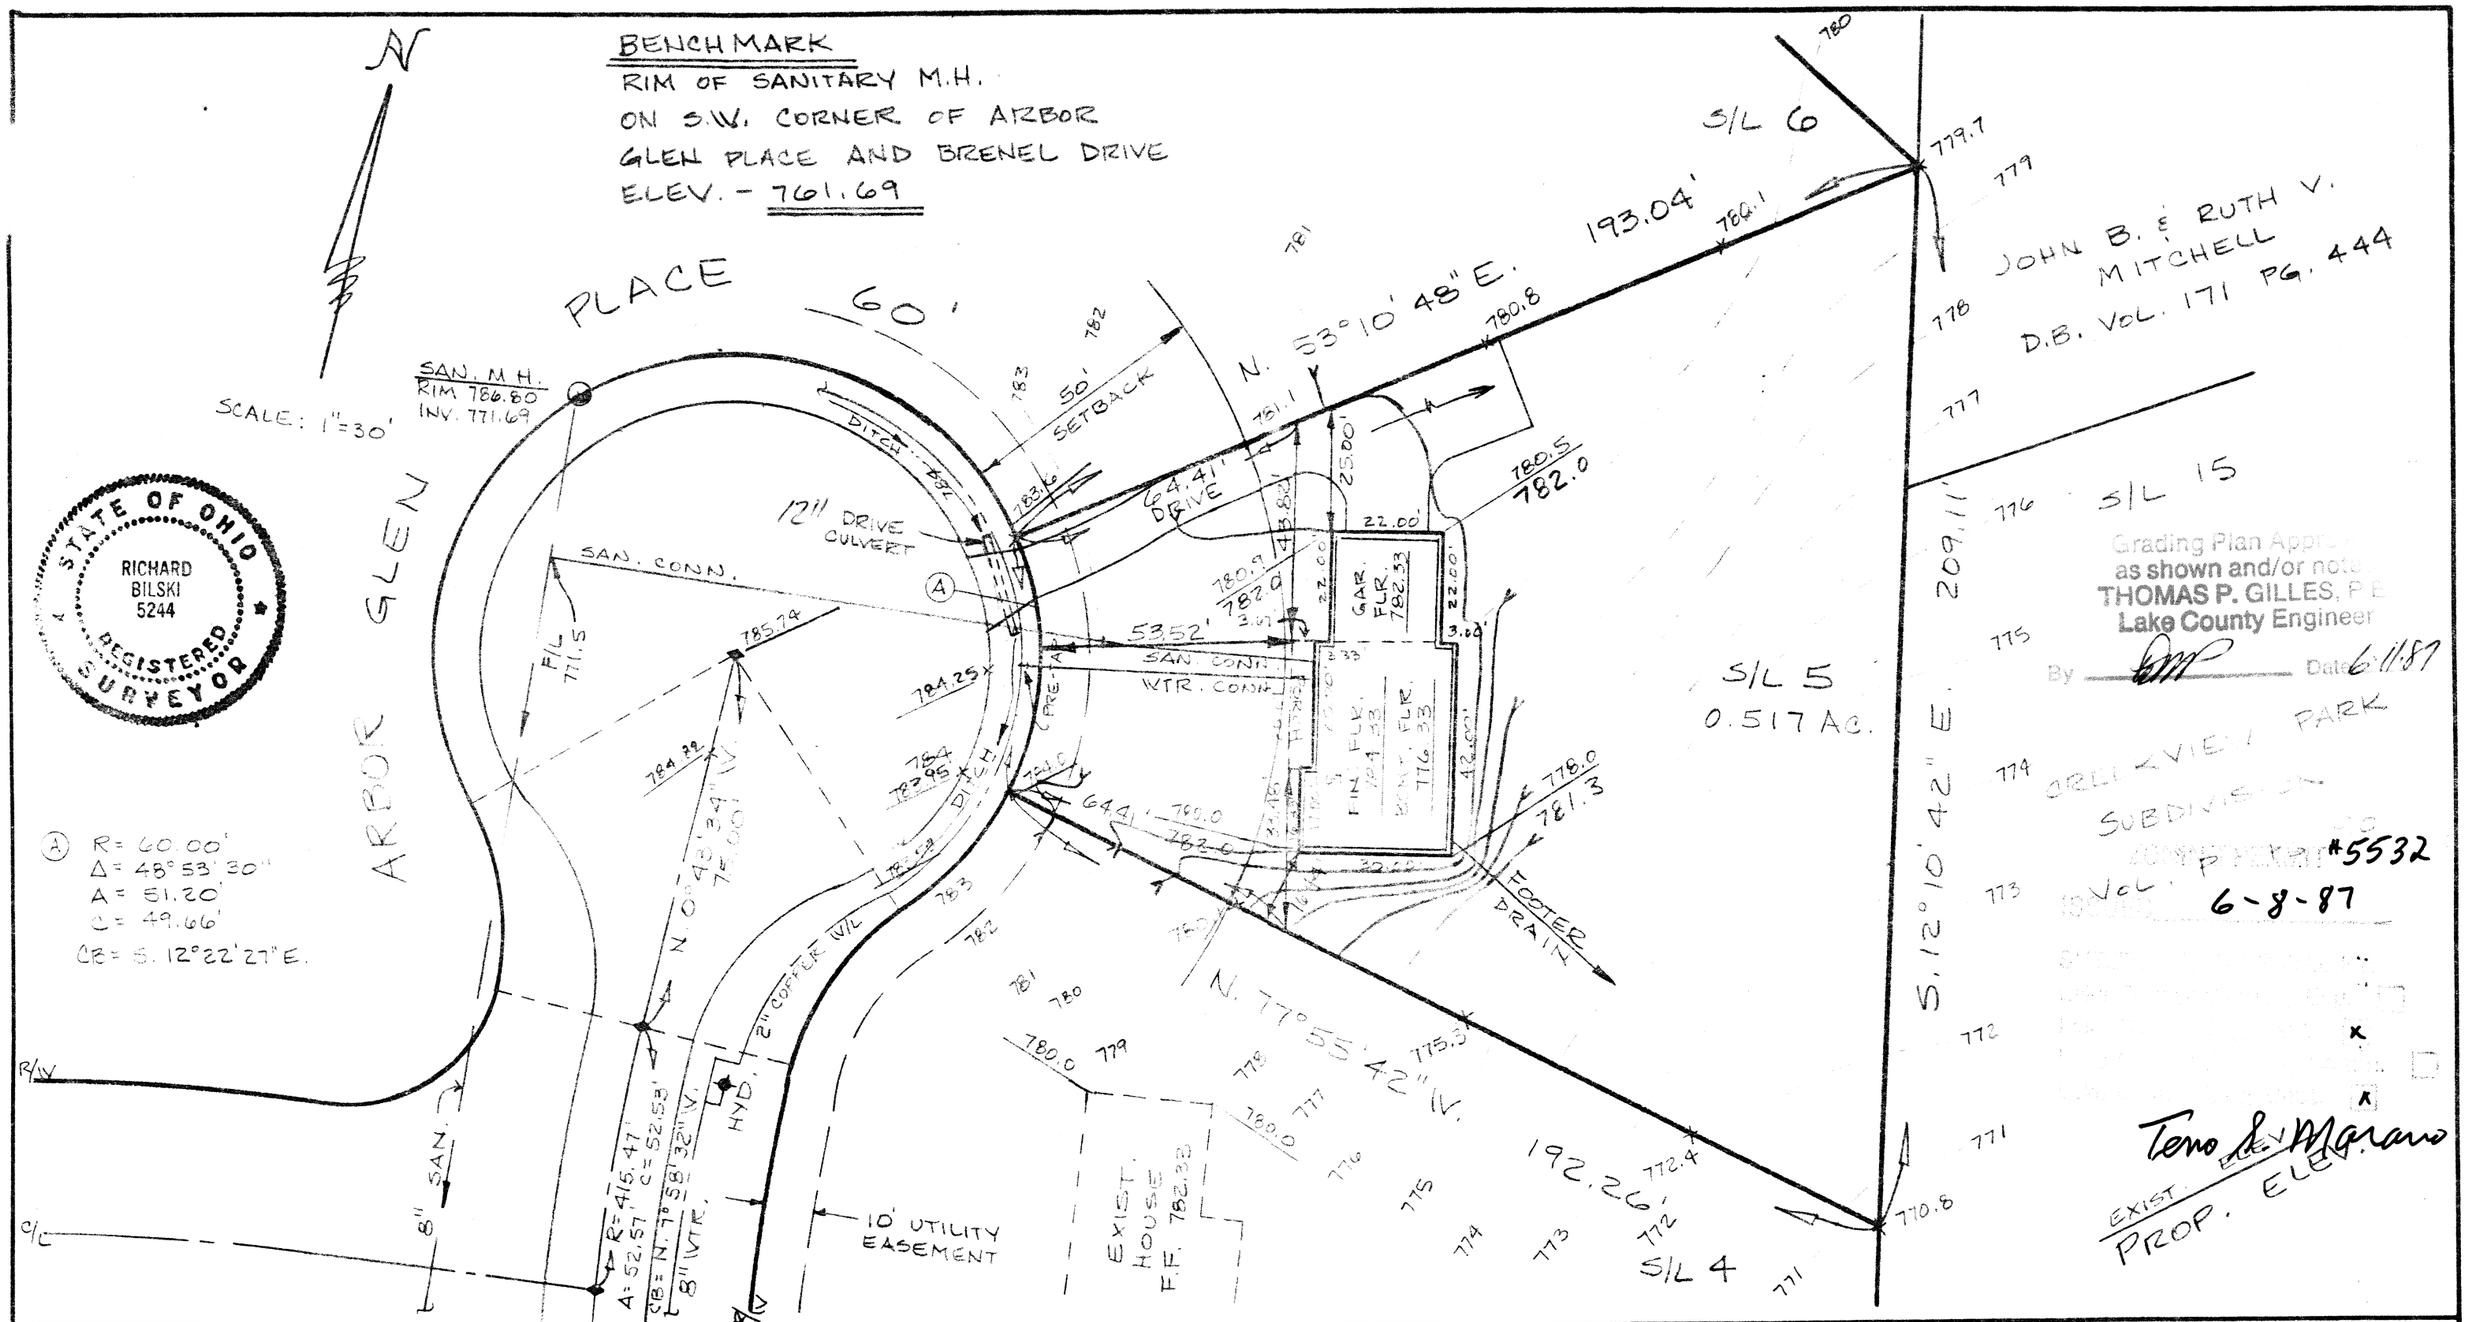

DESIGN CERTIFICATION	AS BUILT CERTIFICATION			
THIS PLAT WAS PREPARED BY ME, AND IS CORRECT TO THE BEST OF MY KNOWLEDGE AND BELIEF.	I HEREBY CERTIFY THAT THE CIRCLED GRADES ARE EXISTING FINISH GRADES CHECKED IN THE FIELD ON _____ AND THAT SURVEY IS CORRECT TO THE BEST OF MY KNOWLEDGE AND BELIEF.	**COLPETZER · WOODS** CONSULTANTS, INC. 9470 MENTOR AVENUE • MENTOR, OHIO 44060 • (216) 357-7569	DATE 6-3-87 SCALE 1" = 30' DRWN BY RLS CHKD BY JOB NO. 87-415 FB 514 PG 45	SITE PLAN FOR SCOTT ANDREWS BEING S/L 5 OF ARBOR GLEN SUBD., PHASE I, VOL. 5 PAGE 40, CONCORD TOWNSHIP, LAKE COUNTY, OHIO
REG. SURVEYOR NO. 5244	REG. SURVEYOR NO. _____			