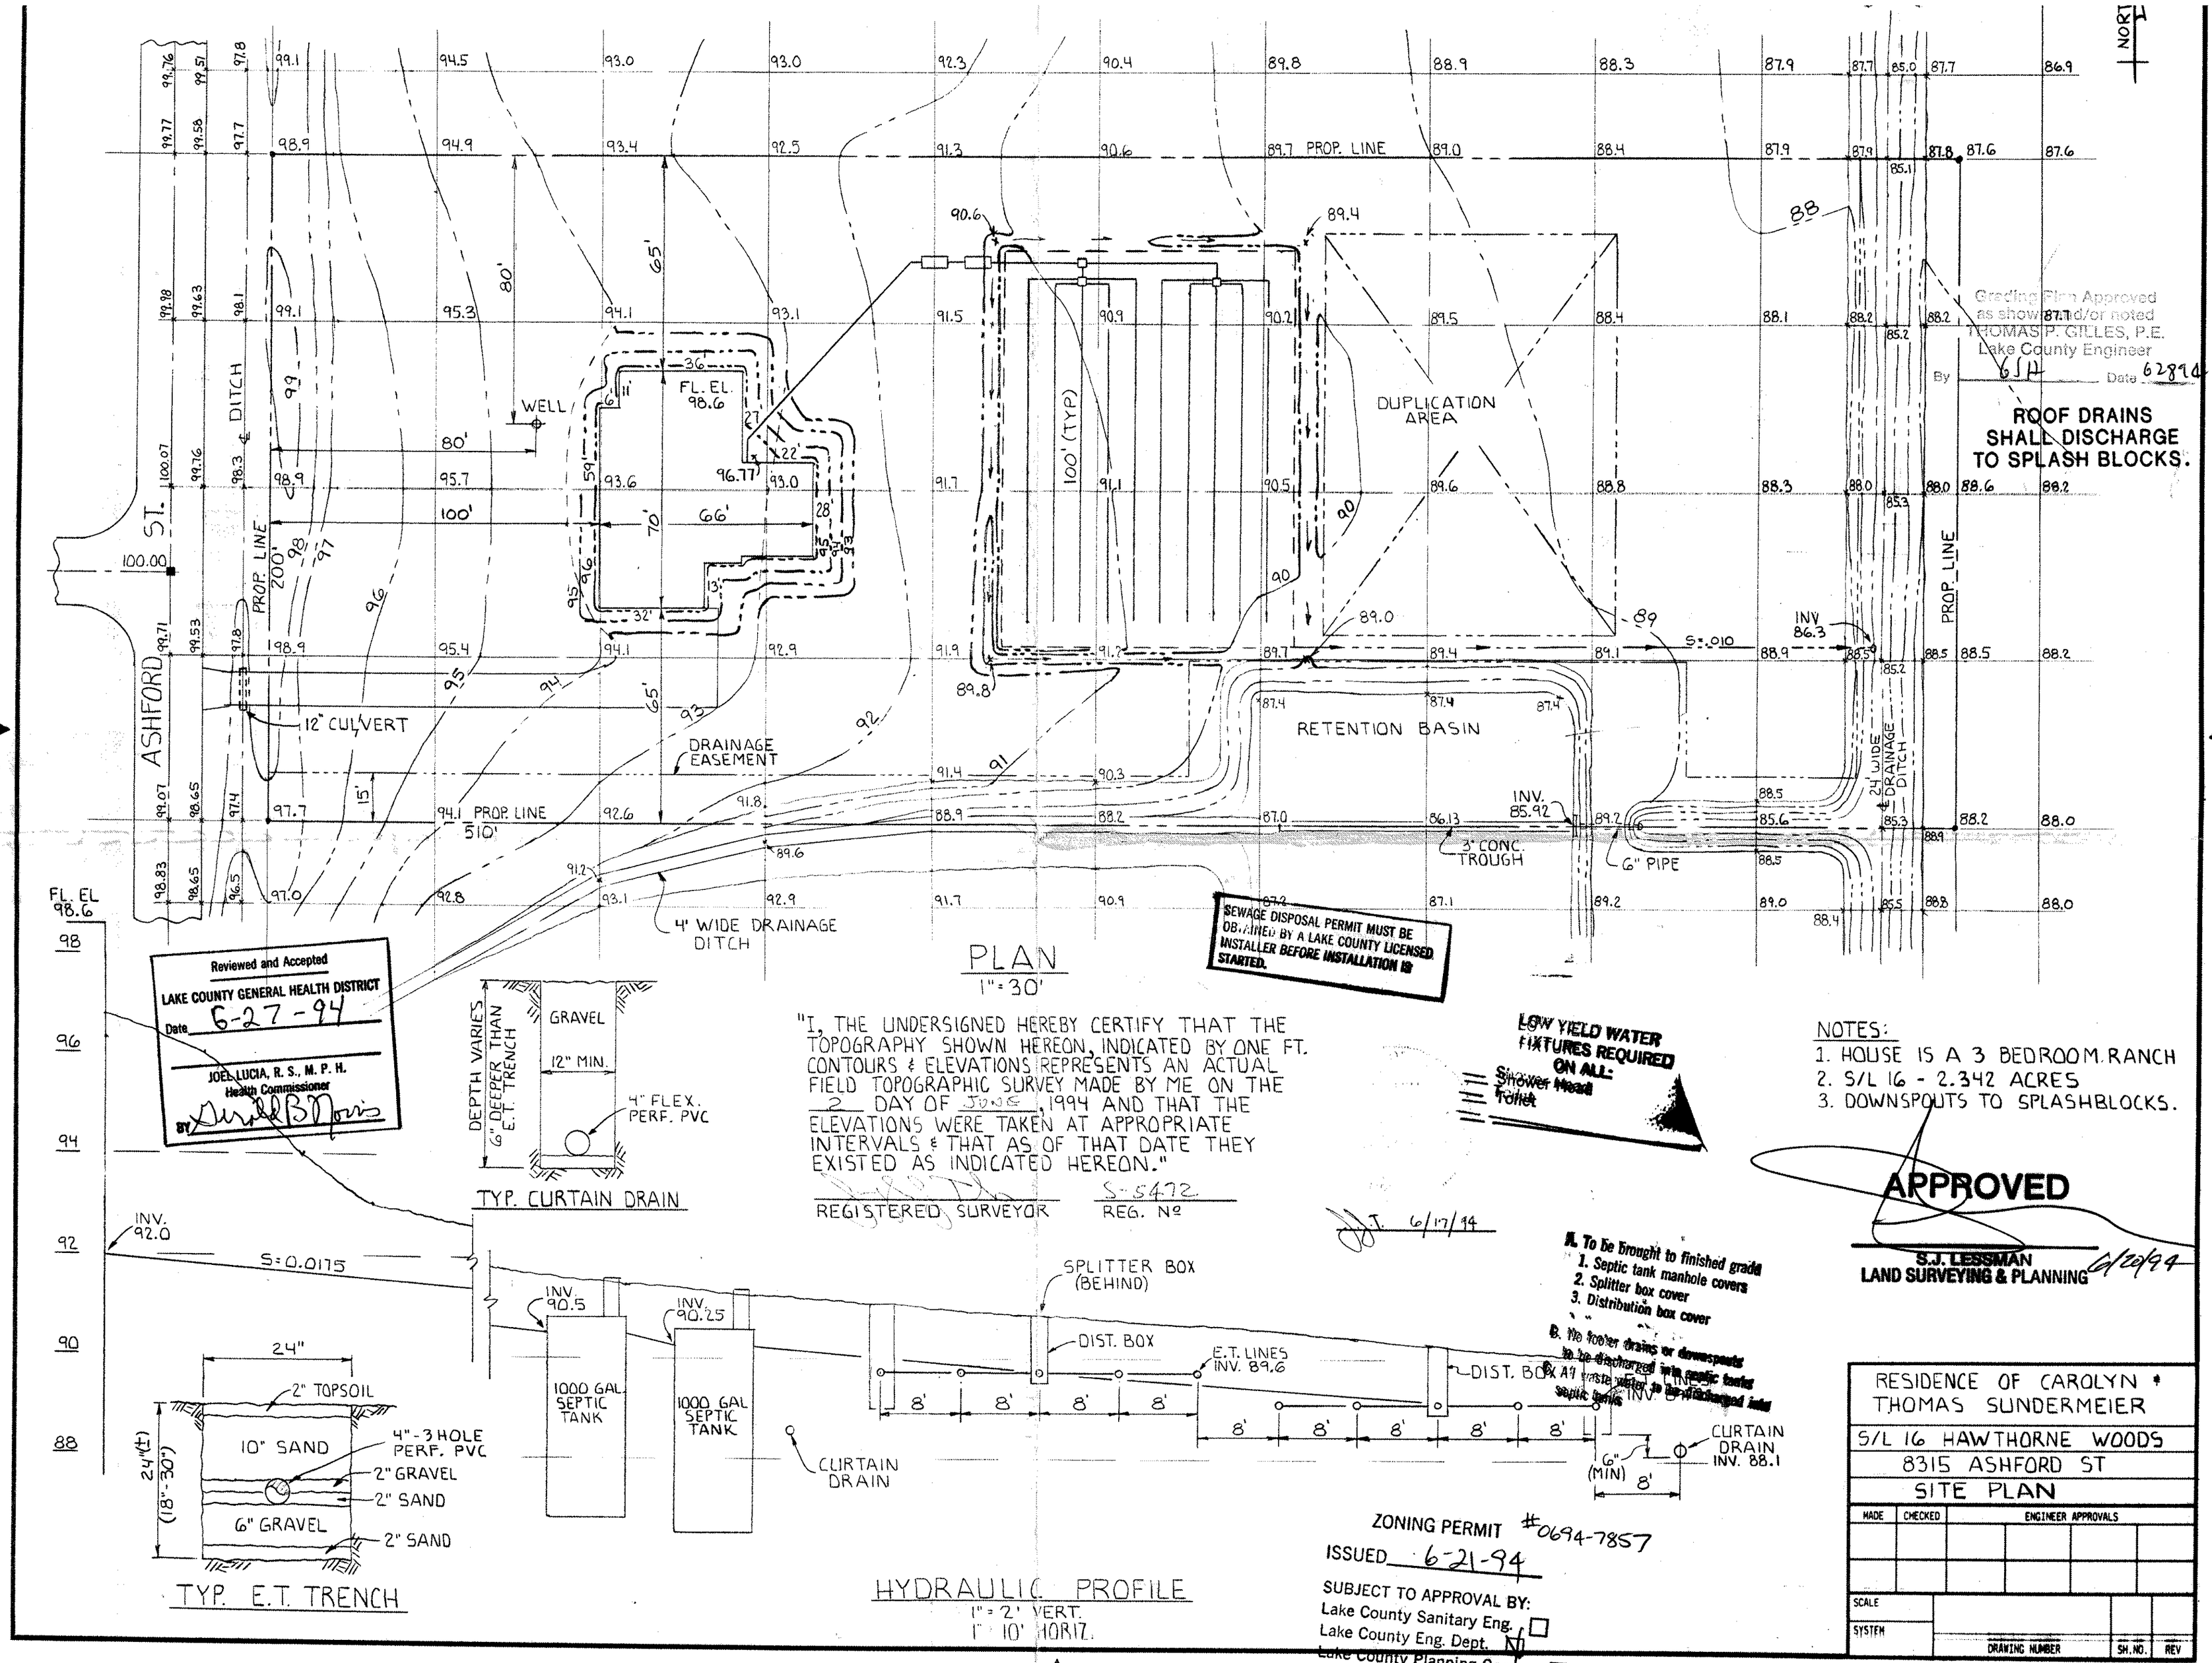

Reviewed and Accepted
LAKE COUNTY GENERAL HEALTH DISTRICT
Date 6-27-94
JOEL LUCIA, R. S., M. P. H.
Health Commissioner
BY Gerald B. Norris

SEWAGE DISPOSAL PERMIT MUST BE OBTAINED BY A LAKE COUNTY LICENSED INSTALLER BEFORE INSTALLATION IS STARTED.

"I, THE UNDERSIGNED HEREBY CERTIFY THAT THE TOPOGRAPHY SHOWN HEREON, INDICATED BY ONE FT. CONTOURS & ELEVATIONS REPRESENTS AN ACTUAL FIELD TOPOGRAPHIC SURVEY MADE BY ME ON THE 2 DAY OF JUNE, 1994 AND THAT THE ELEVATIONS WERE TAKEN AT APPROPRIATE INTERVALS & THAT AS OF THAT DATE THEY EXISTED AS INDICATED HEREON."

REGISTERED SURVEYOR S-5472 REG. Nº

J.T. 6/17/94

LOW YIELD WATER FIXTURES REQUIRED ON ALL:
Shower Head
Toilet

Grading Plan Approved as shown and/or noted
THOMAS P. GILLES, P.E.
Lake County Engineer
By GJH Date 62894

ROOF DRAINS SHALL DISCHARGE TO SPLASH BLOCKS.

NOTES:
1. HOUSE IS A 3 BEDROOM RANCH
2. S/L 16 - 2.342 ACRES
3. DOWNSPOUTS TO SPLASHBLOCKS.

APPROVED
S.J. LESSMAN
LAND SURVEYING & PLANNING 6/20/94

A. To be brought to finished grade
1. Septic tank manhole covers
2. Splitter box cover
3. Distribution box cover

B. No footer drains or downspouts to be discharged into septic tanks
A1 waste water to be discharged into septic tanks

ZONING PERMIT #0694-7857
ISSUED 6-21-94

SUBJECT TO APPROVAL BY:
Lake County Sanitary Eng. ☐
Lake County Eng. Dept. ☑
Lake County Planning Comm. ☐
Lake County Bldg. Dept. ☑

RESIDENCE OF CAROLYN & THOMAS SUNDERMEIER
S/L 16 HAWTHORNE WOODS
8315 ASHFORD ST
SITE PLAN

MADE	CHECKED	ENGINEER APPROVALS			
SCALE					
SYSTEM		DRAWING NUMBER		SH. NO.	REV