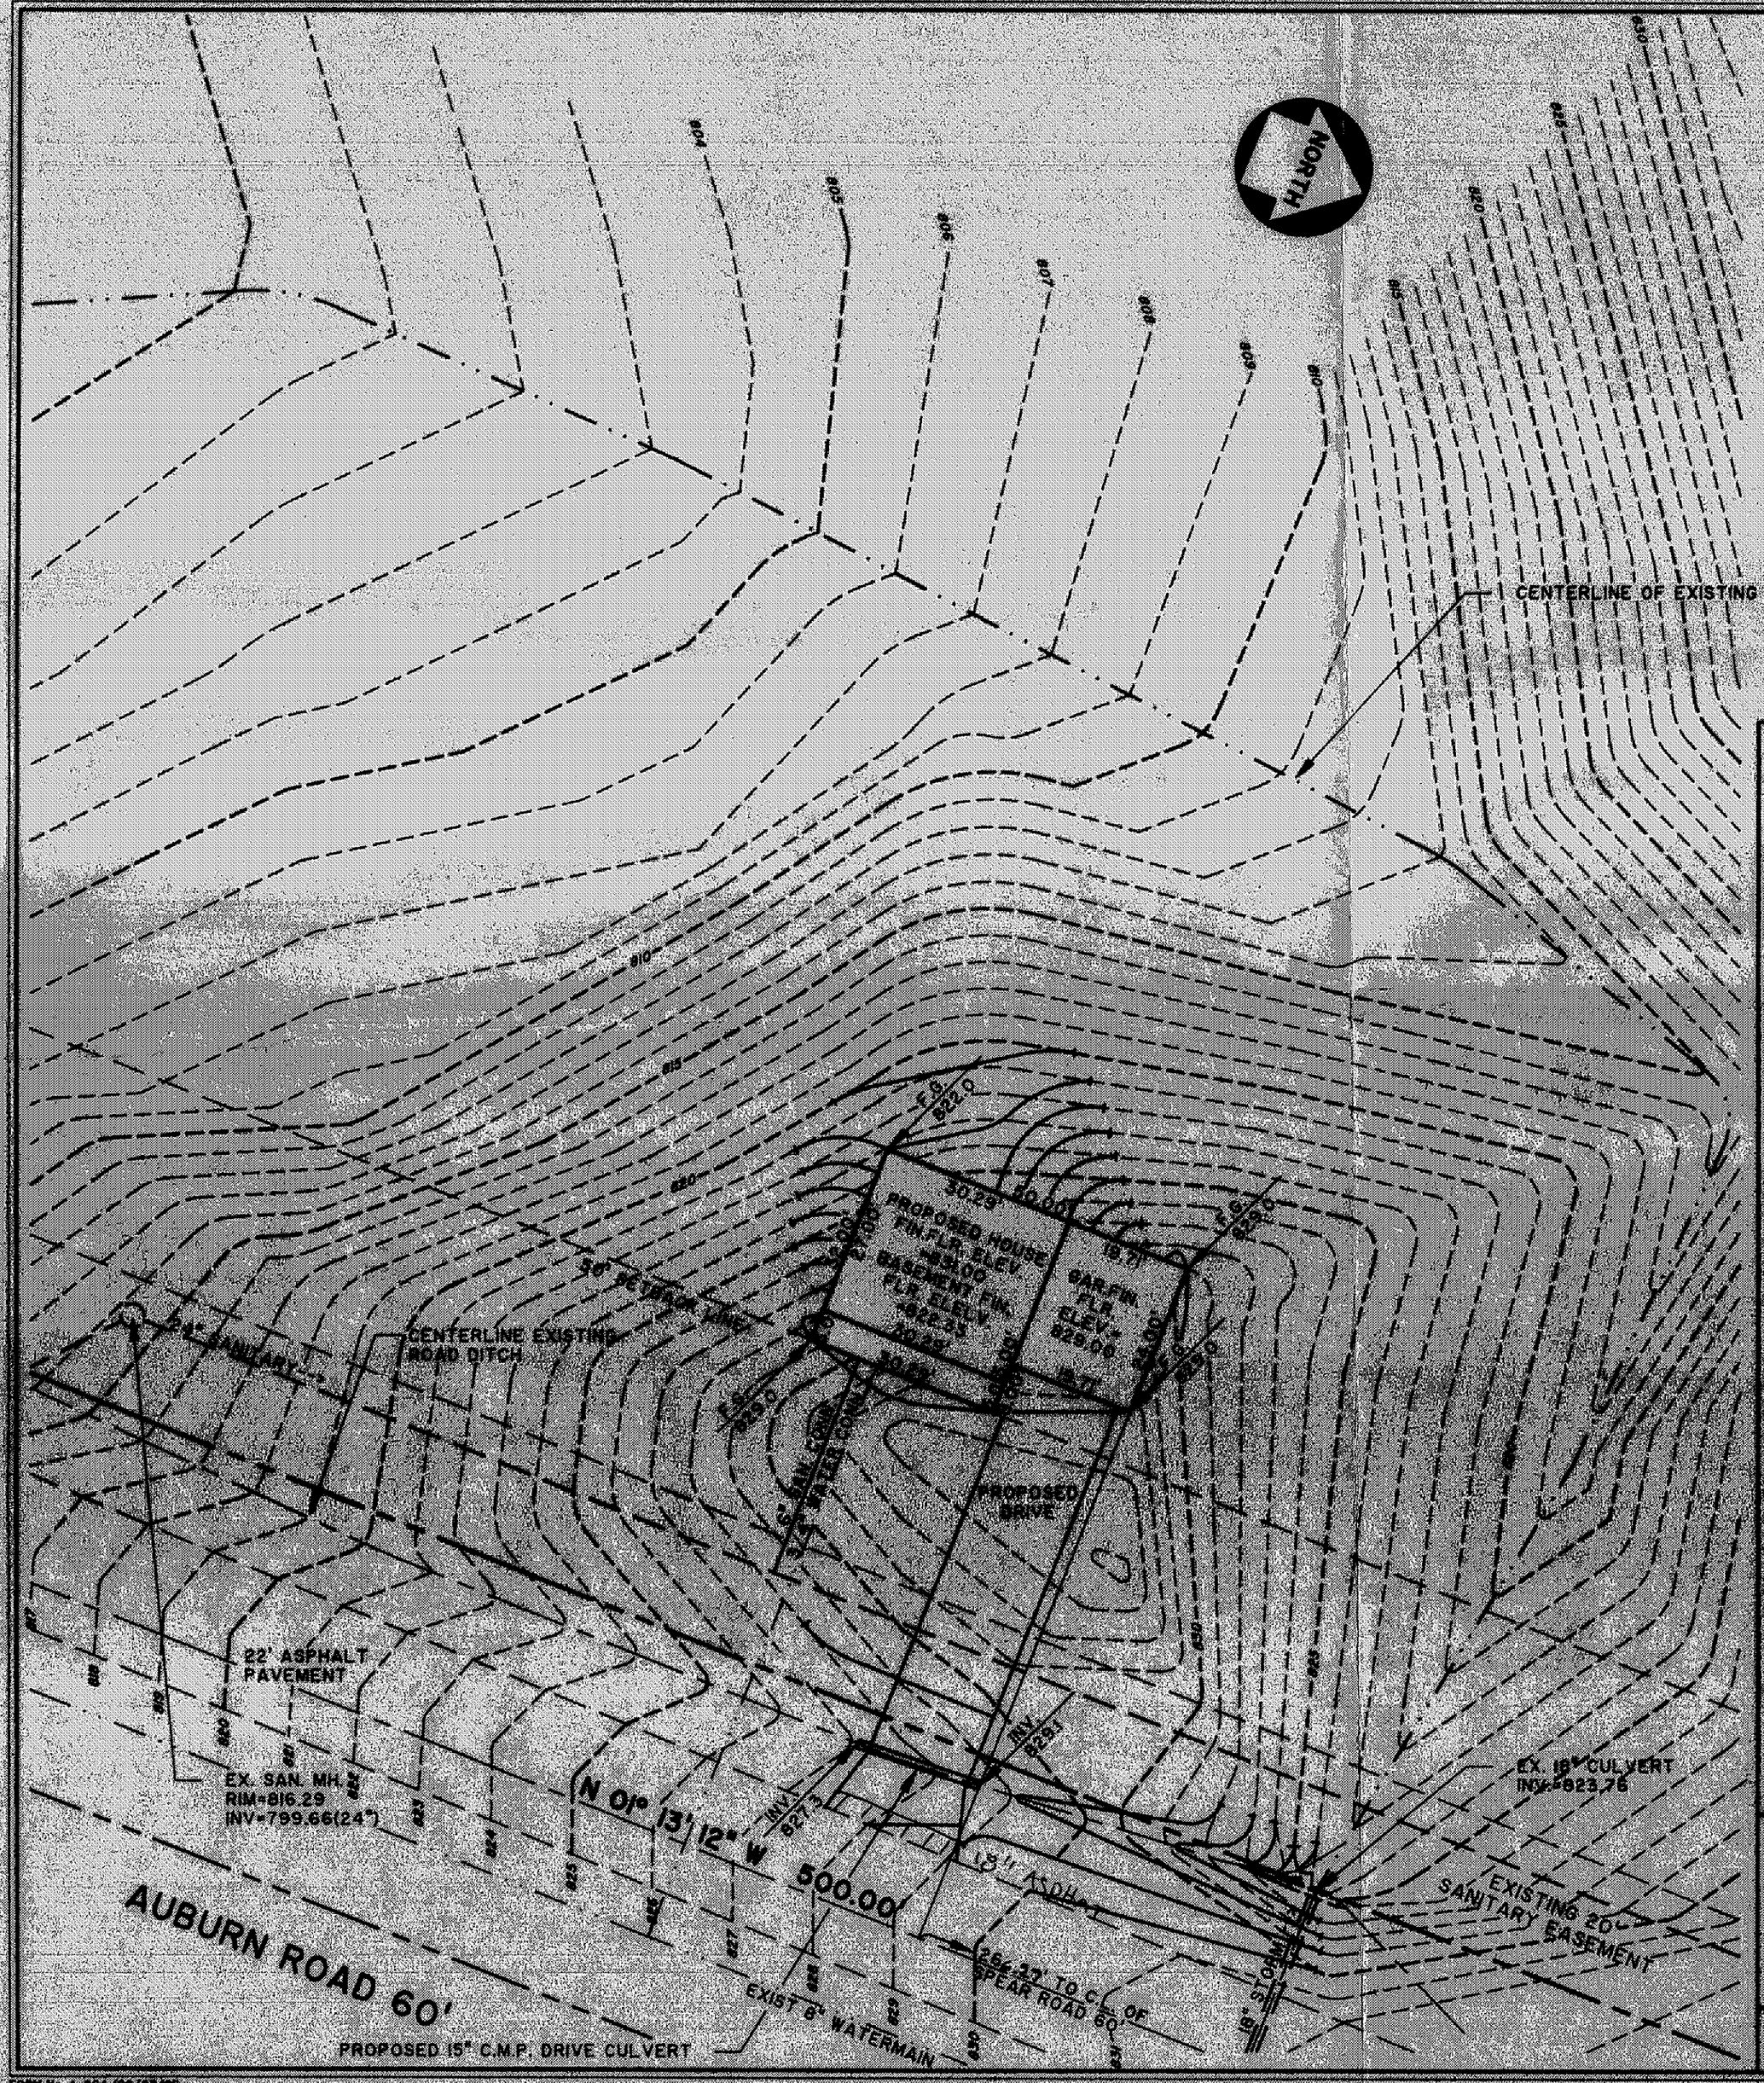

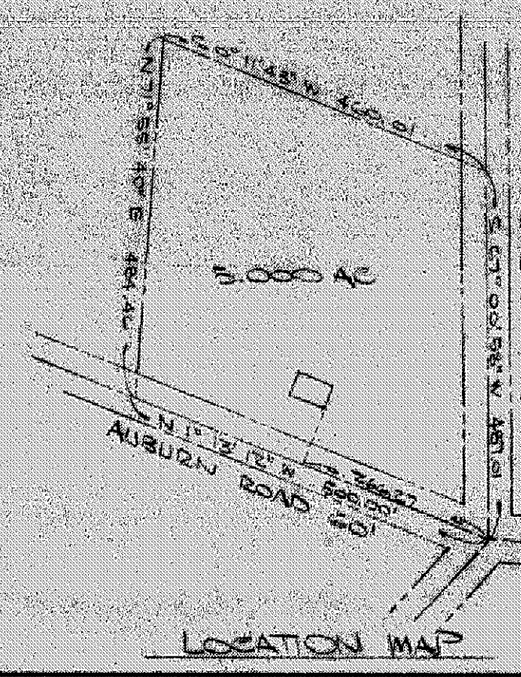

STAKE SCHED
5.00'
8.00'
32.00'
86.16' @ 15° O.S.

STATE OF OHIO
QUENTIN S. HIMEBAUGH 6820
REGISTERED SURVEYOR

Grading Plan Approved as shown and/or noted
THOMAS P. GILLES, P.E.
Lake County Engineer
By _____ Date 11/25/92

MIN. 6" ASPHALT DRIVEWAY APRON

ZONING PERMIT #7021
ISSUED 12-26-91

SUBJECT TO APPROVAL BY:
Lake County Sanitary Eng. ☐
Lake County Eng. Dept. ☒
Lake County Planning Comm. ☐
Lake County Bldg. Dept. ☒

GENERAL NOTES:

1. DRIVEWAY APRON TO BE 6" THICK
2. BENCHMARK - RIM OF EXISTING SANITARY MANHOLE 60' SOUTH OF SITE. ELEV.=816.29

LEGEND

EXISTING CONTOUR
PROPOSED CONTOUR

100.00 EXISTING ELEVATION
100.00 PROPOSED ELEVATION

CERTIFICATION

"I THE UNDERSIGNED HEREBY CERTIFY THAT THIS TOPOGRAPHY INDICATED BY 1' CONTOURS AND ELEVATIONS SHOWN HEREON REPRESENTS AN ACTUAL SURVEY MADE BY ME ON THE 13th DAY OF NOV. , 1991 AND THE ELEVATIONS WERE TAKEN AT APPROPRIATE INTERVALS AND AS OF THAT DAY THEY EXISTED AS INDICATED HEREON.

"I HEREBY CERTIFY THAT THIS PLAN WAS PREPARED BY ME AND IS CORRECT TO THE BEST OF MY KNOWLEDGE"

QUENTIN S. HIMEBAUGH, P.S. No. 6820

PREPARED BY:
Himebaugh and Associates
Surveyors and Site Consultants
38083 West Spaulding St.
Willoughby, Ohio 44094
(216) 946-1761

SITE PLAN: 5.0000 AC. PARCEL LOCATED SOUTHWEST CORNER SPEAR ROAD AND AUBURN ROAD CONCORD TOWNSHIP
PREPARED FOR: LITTLE MOUNTAIN HOMES, INC.
SCALE: 1" = 20'
DATE: NOVEMBER 21, 1991
DRAWN BY: DAVID W. NOVAK

REV. A - MOVED LOCATION MAP, DEC. 20, 1991

91-082-B

FORM No. A-904 (06/03/88)