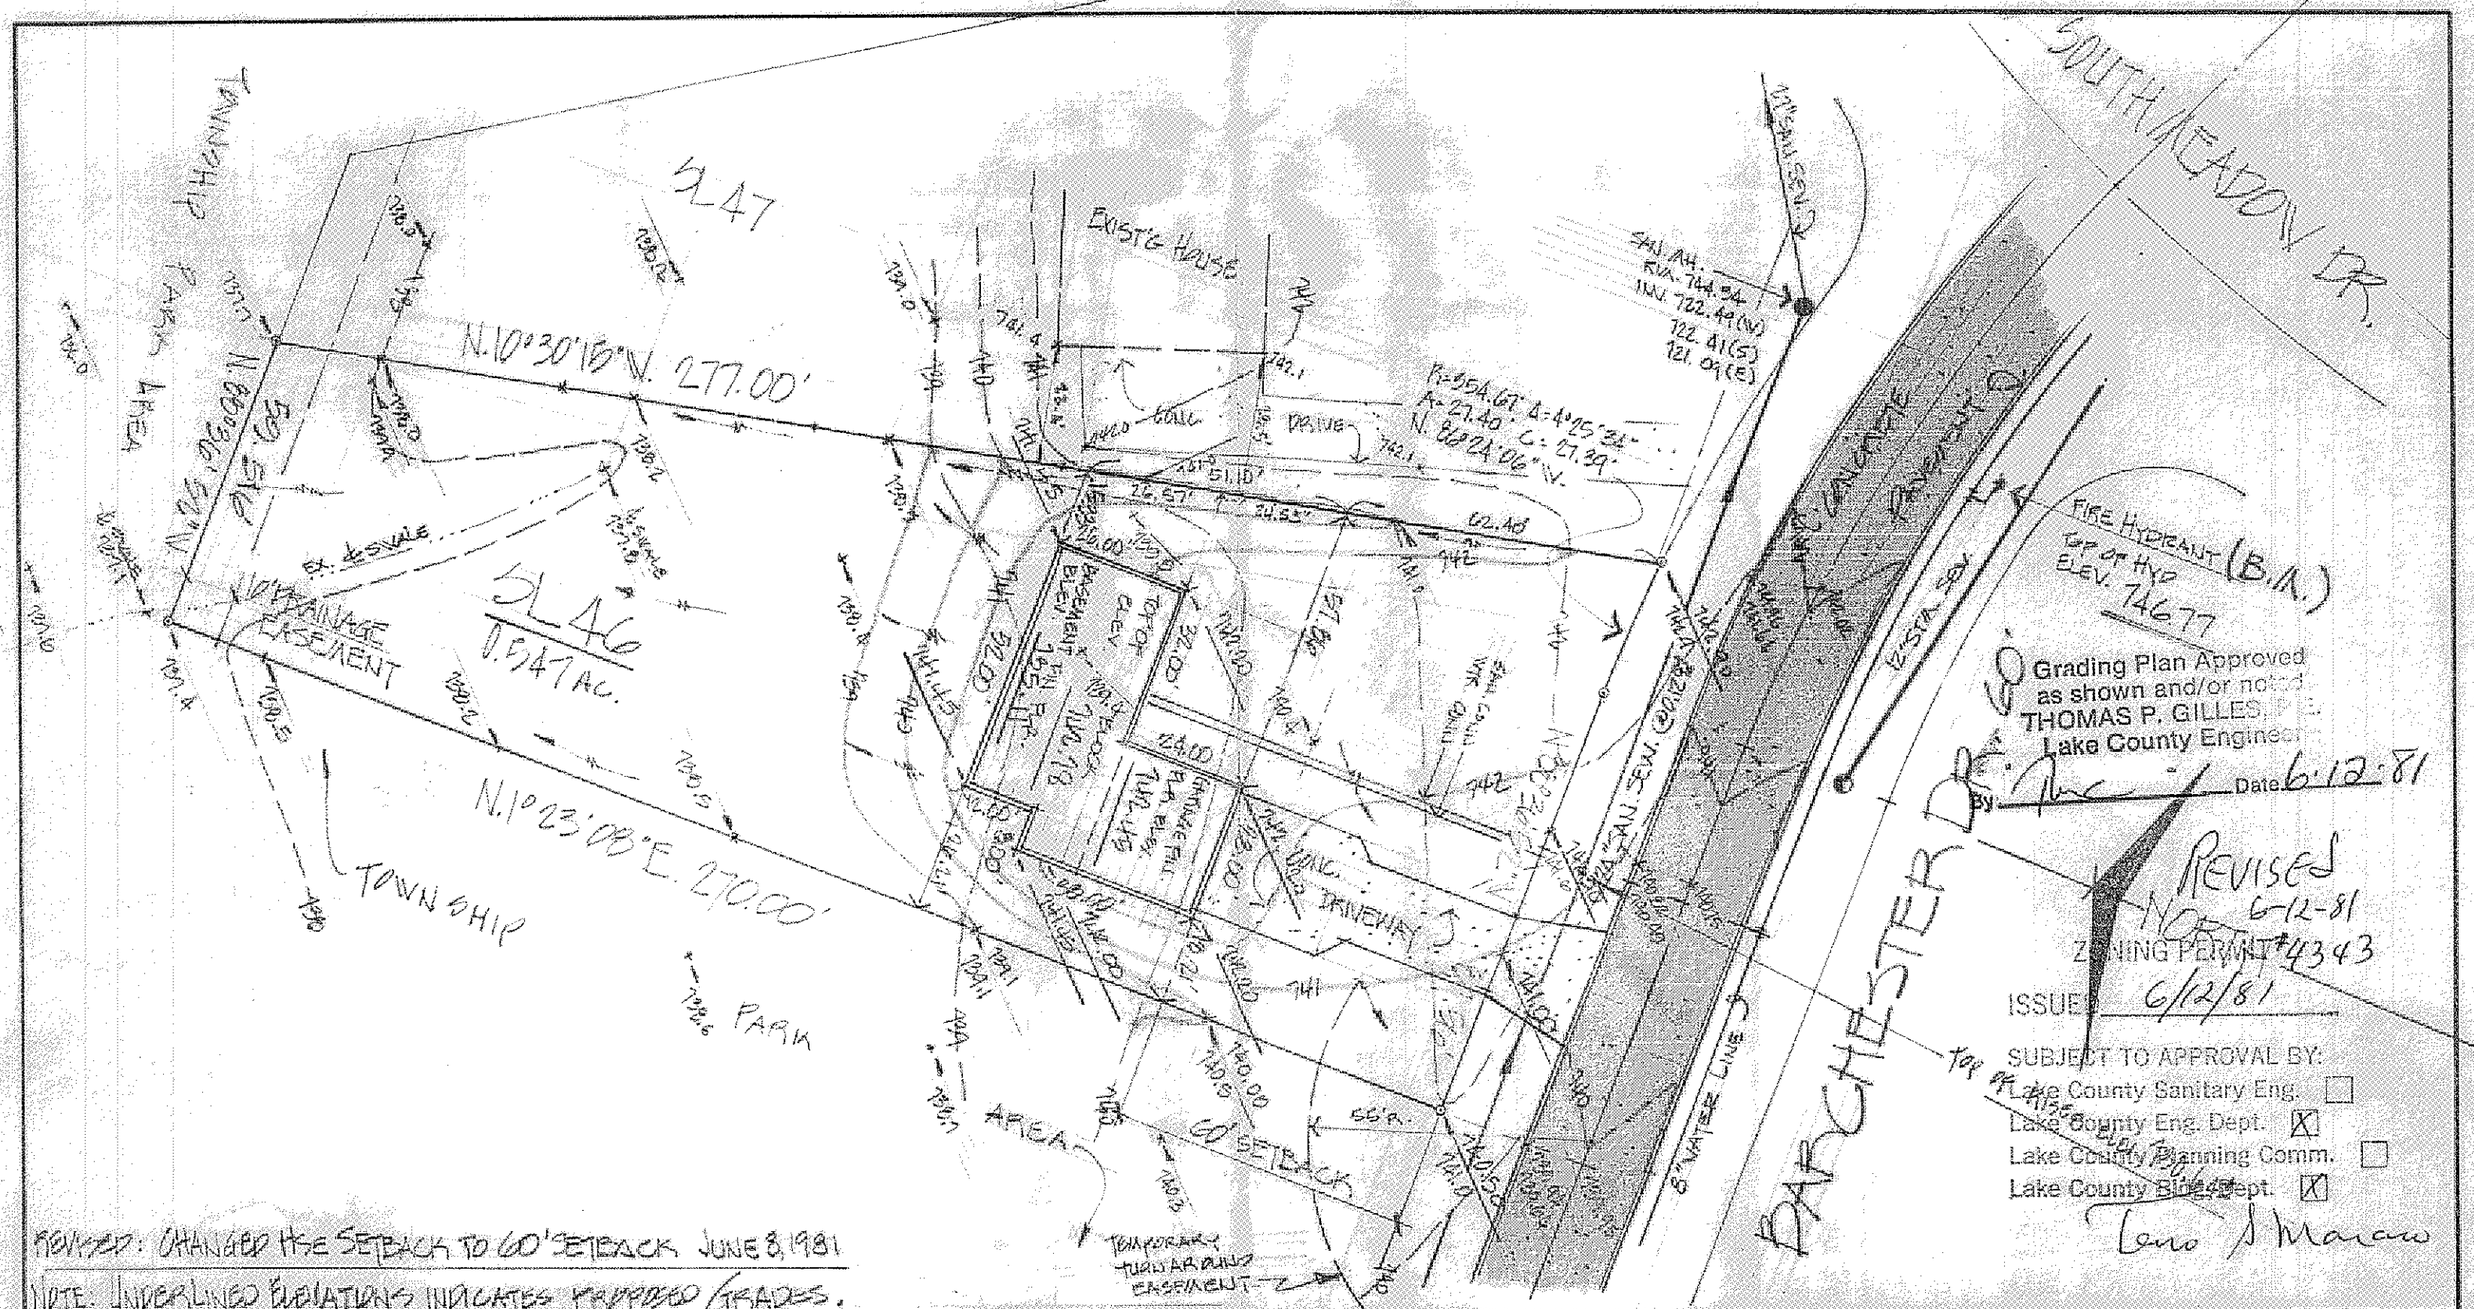

DESIGN CERTIFICATION

THIS PLAT WAS PREPARED BY ME, AND IS CORRECT TO THE BEST OF MY KNOWLEDGE AND BELIEF.

Elio Jafelice

REG. SURVEYOR NO. 4785

AS BUILT CERTIFICATION

I HEREBY CERTIFY THAT THE CIRCLED GRADES ARE EXISTING FINISH GRADES CHECKED IN THE FIELD ON _____ AND THAT SURVEY IS CORRECT TO THE BEST OF MY KNOWLEDGE AND BELIEF.

REG. SURVEYOR NO. _____

COLPETZER · WOODS
CONSULTANTS, INC.
9470 MENTOR AVENUE • MENTOR, OHIO 44066 • (216) 357-7569

DATE 5/15/81
SCALE 1"=30'
DRWN BY C.D. Bertone
CHKD BY E
JOB NO. 81.096
FB _____ PG _____

SITE PLAN FOR:
CASEMENT HOMES
1251 MADISON AVE. PAINESVILLE, OHIO.
BEING SUBLOT NO. 46 IN CONCORD HILLS SUBDIVISION NO. 1, CONCORD TOWNSHIP, OHIO.