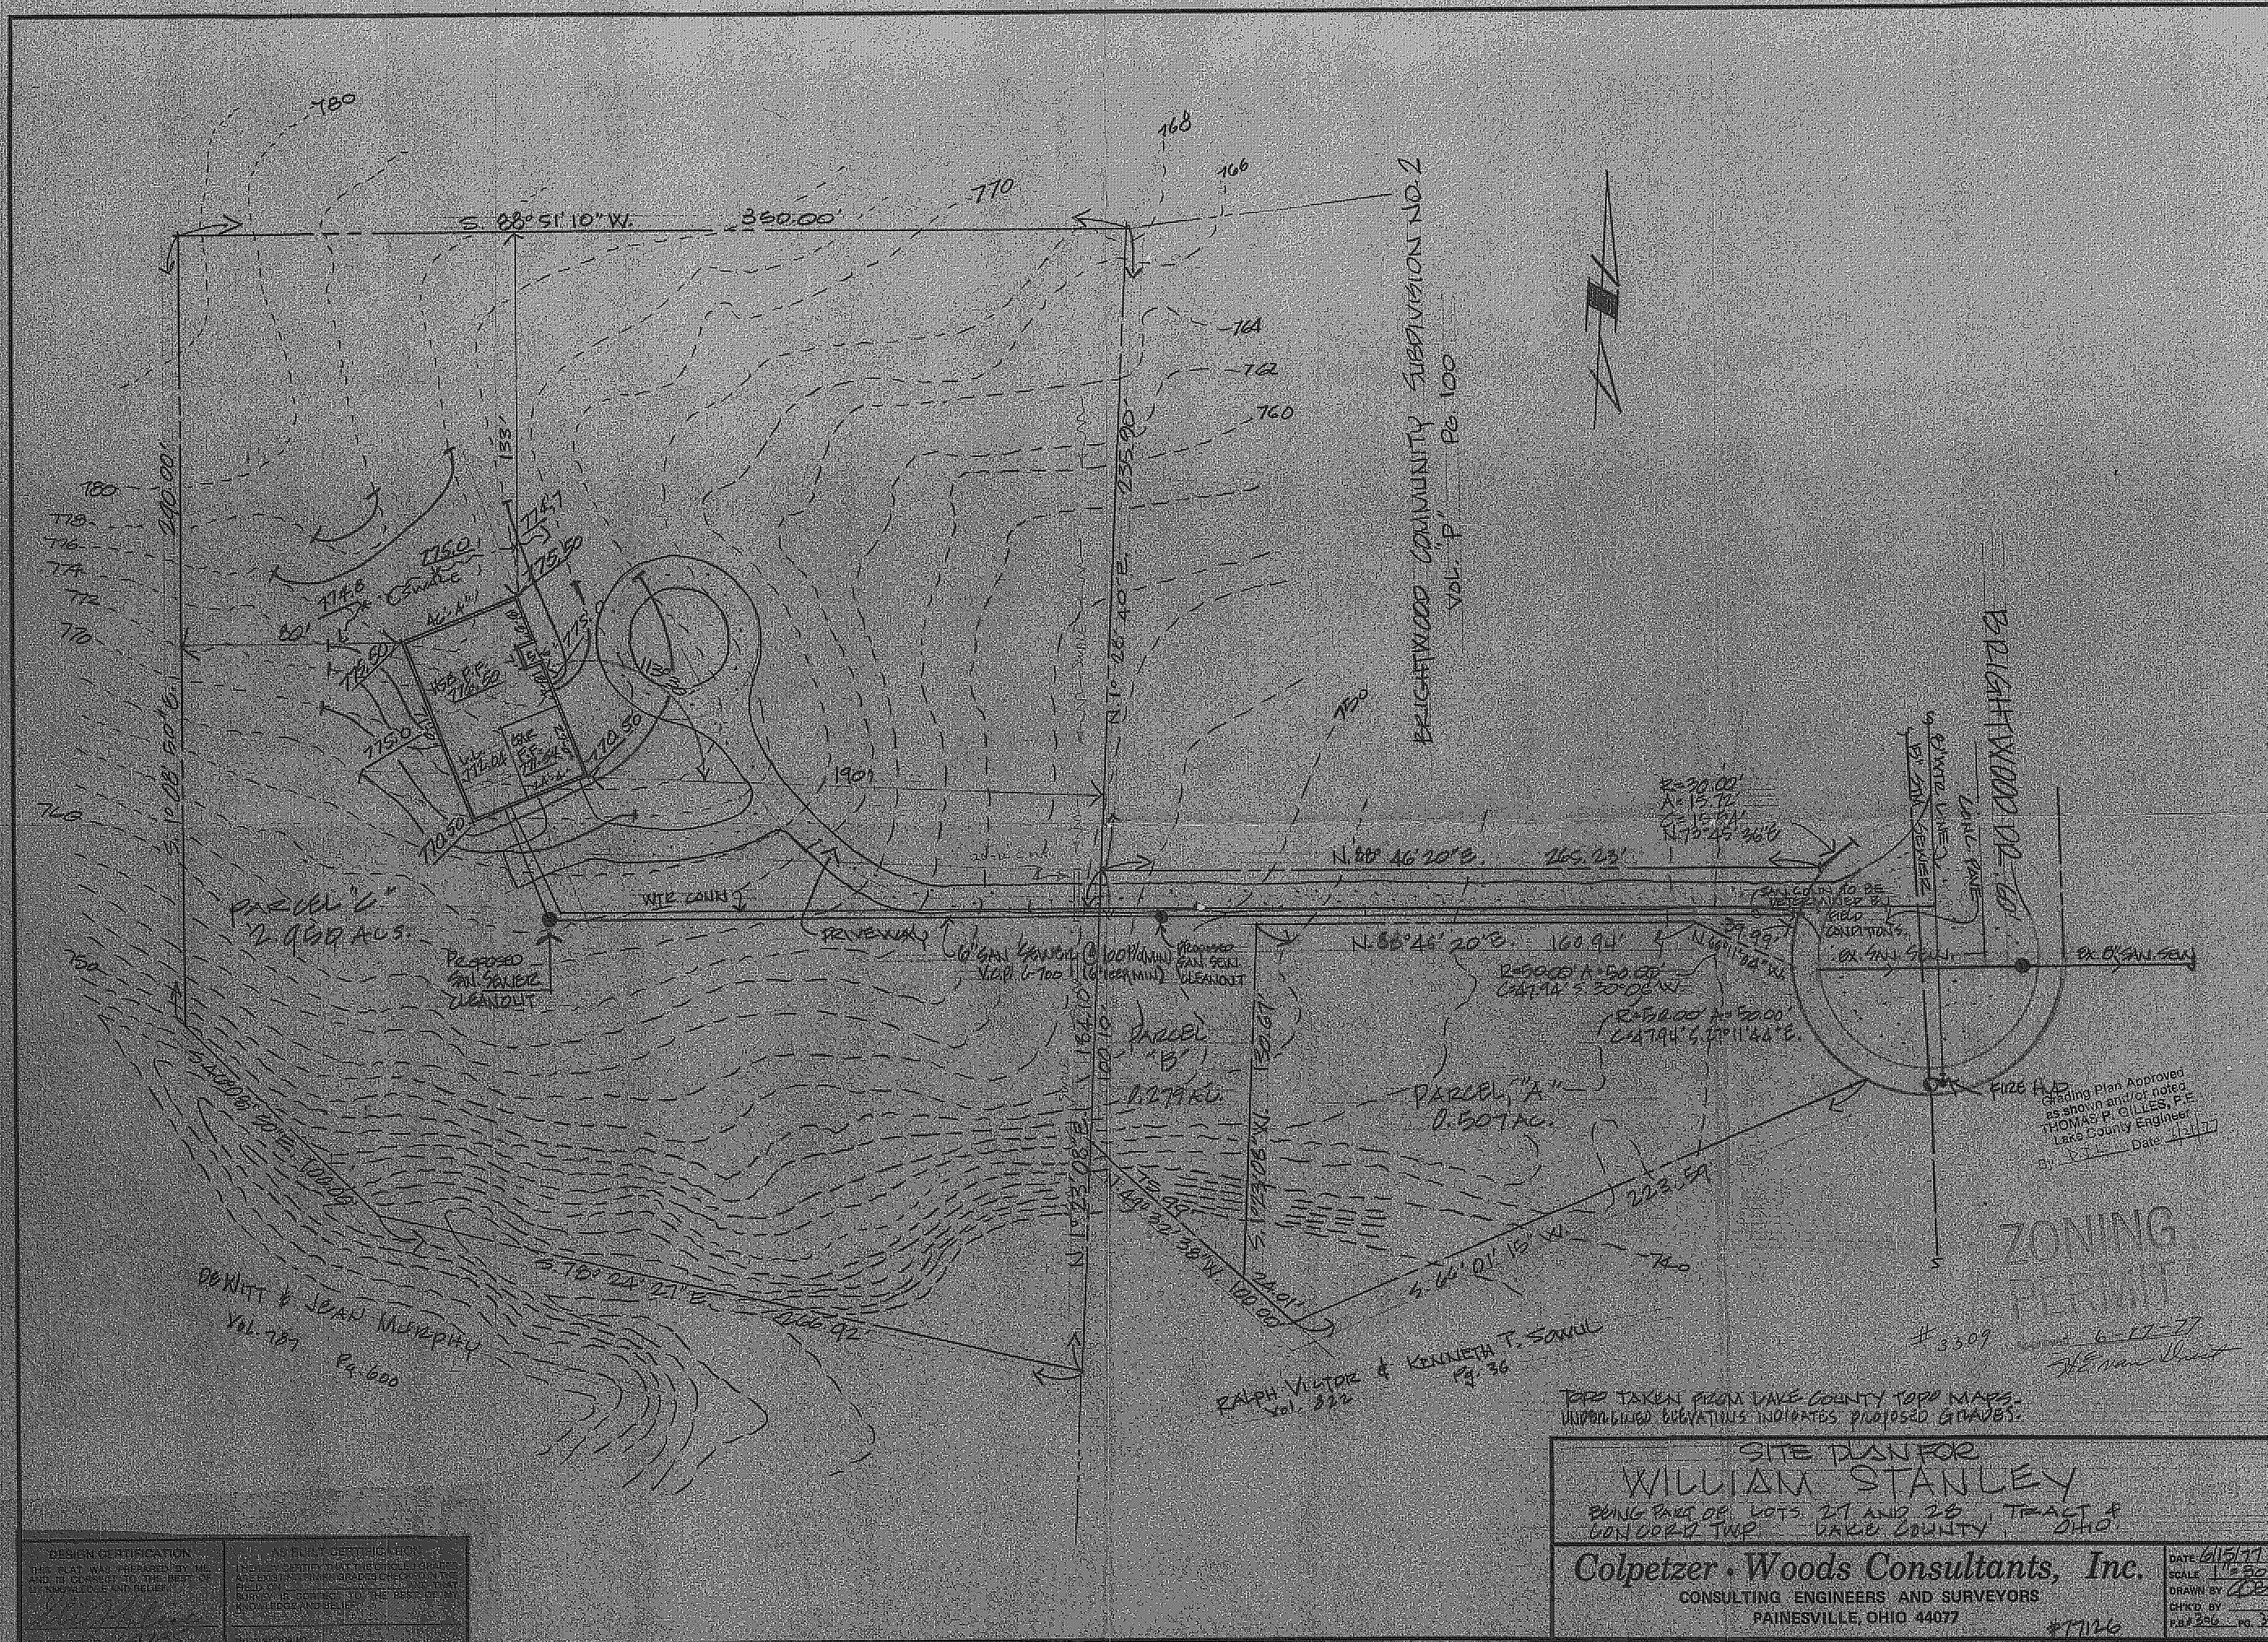
S. 88°51'10" W.
350.00'
240.00'
S. 1°08'50" E.
N. 1°28'40" E.
235.90'
BRIGHTWOOD COMMUNITY SUBDIVISION NO. 2
VOL. "P" PG. 100
BRIGHTWOOD DR. 60'
N. 88°46'20" E. 265.23'
N. 88°46'20" E. 160.94'
R=30.00'
A=15.72
PARCEL "C"
2.959 AC.S.
PARCEL "B"
0.279 AC.
PARCEL "A"
0.507 AC.
PROPOSED SAN. SEWER CLEANOUT
DRIVEWAY
WTR. CONN.
8" WTR. LINE
CURB LINE
FIRE HYD.
EX. SAN. SEW.
EX. 8" SAN. SEW.
223.59
S. 66°01'15" W.
S. 78°24'27" E.
100.00
DEWITT & JEAN MURPHY
VOL. 787 PG. 600
RALPH VICTOR & KENNETH T. SOWUL
VOL. 822 PG. 36
TOPO TAKEN FROM LAKE COUNTY TOPO MAPS.
UNDERLINED ELEVATIONS INDICATES PROPOSED GRADES.
Grading Plan Approved
as shown and/or noted
THOMAS P. GILLES, P.E.
Lake County Engineer
Date: 6/21/77
ZONING PERMIT
#3309
6-17-77
SITE PLAN FOR
WILLIAM STANLEY
BEING PART OF LOTS 27 AND 28, TRACT 4
CONCORD TWP. LAKE COUNTY, OHIO
Colpetzer · Woods Consultants, Inc.
CONSULTING ENGINEERS AND SURVEYORS
PAINESVILLE, OHIO 44077
#77126
DATE 6/15/77
SCALE 1"=50'
DRAWN BY
CHK'D. BY
F.B.# 396 PG. 31
DESIGN CERTIFICATION
AS BUILT CERTIFICATION