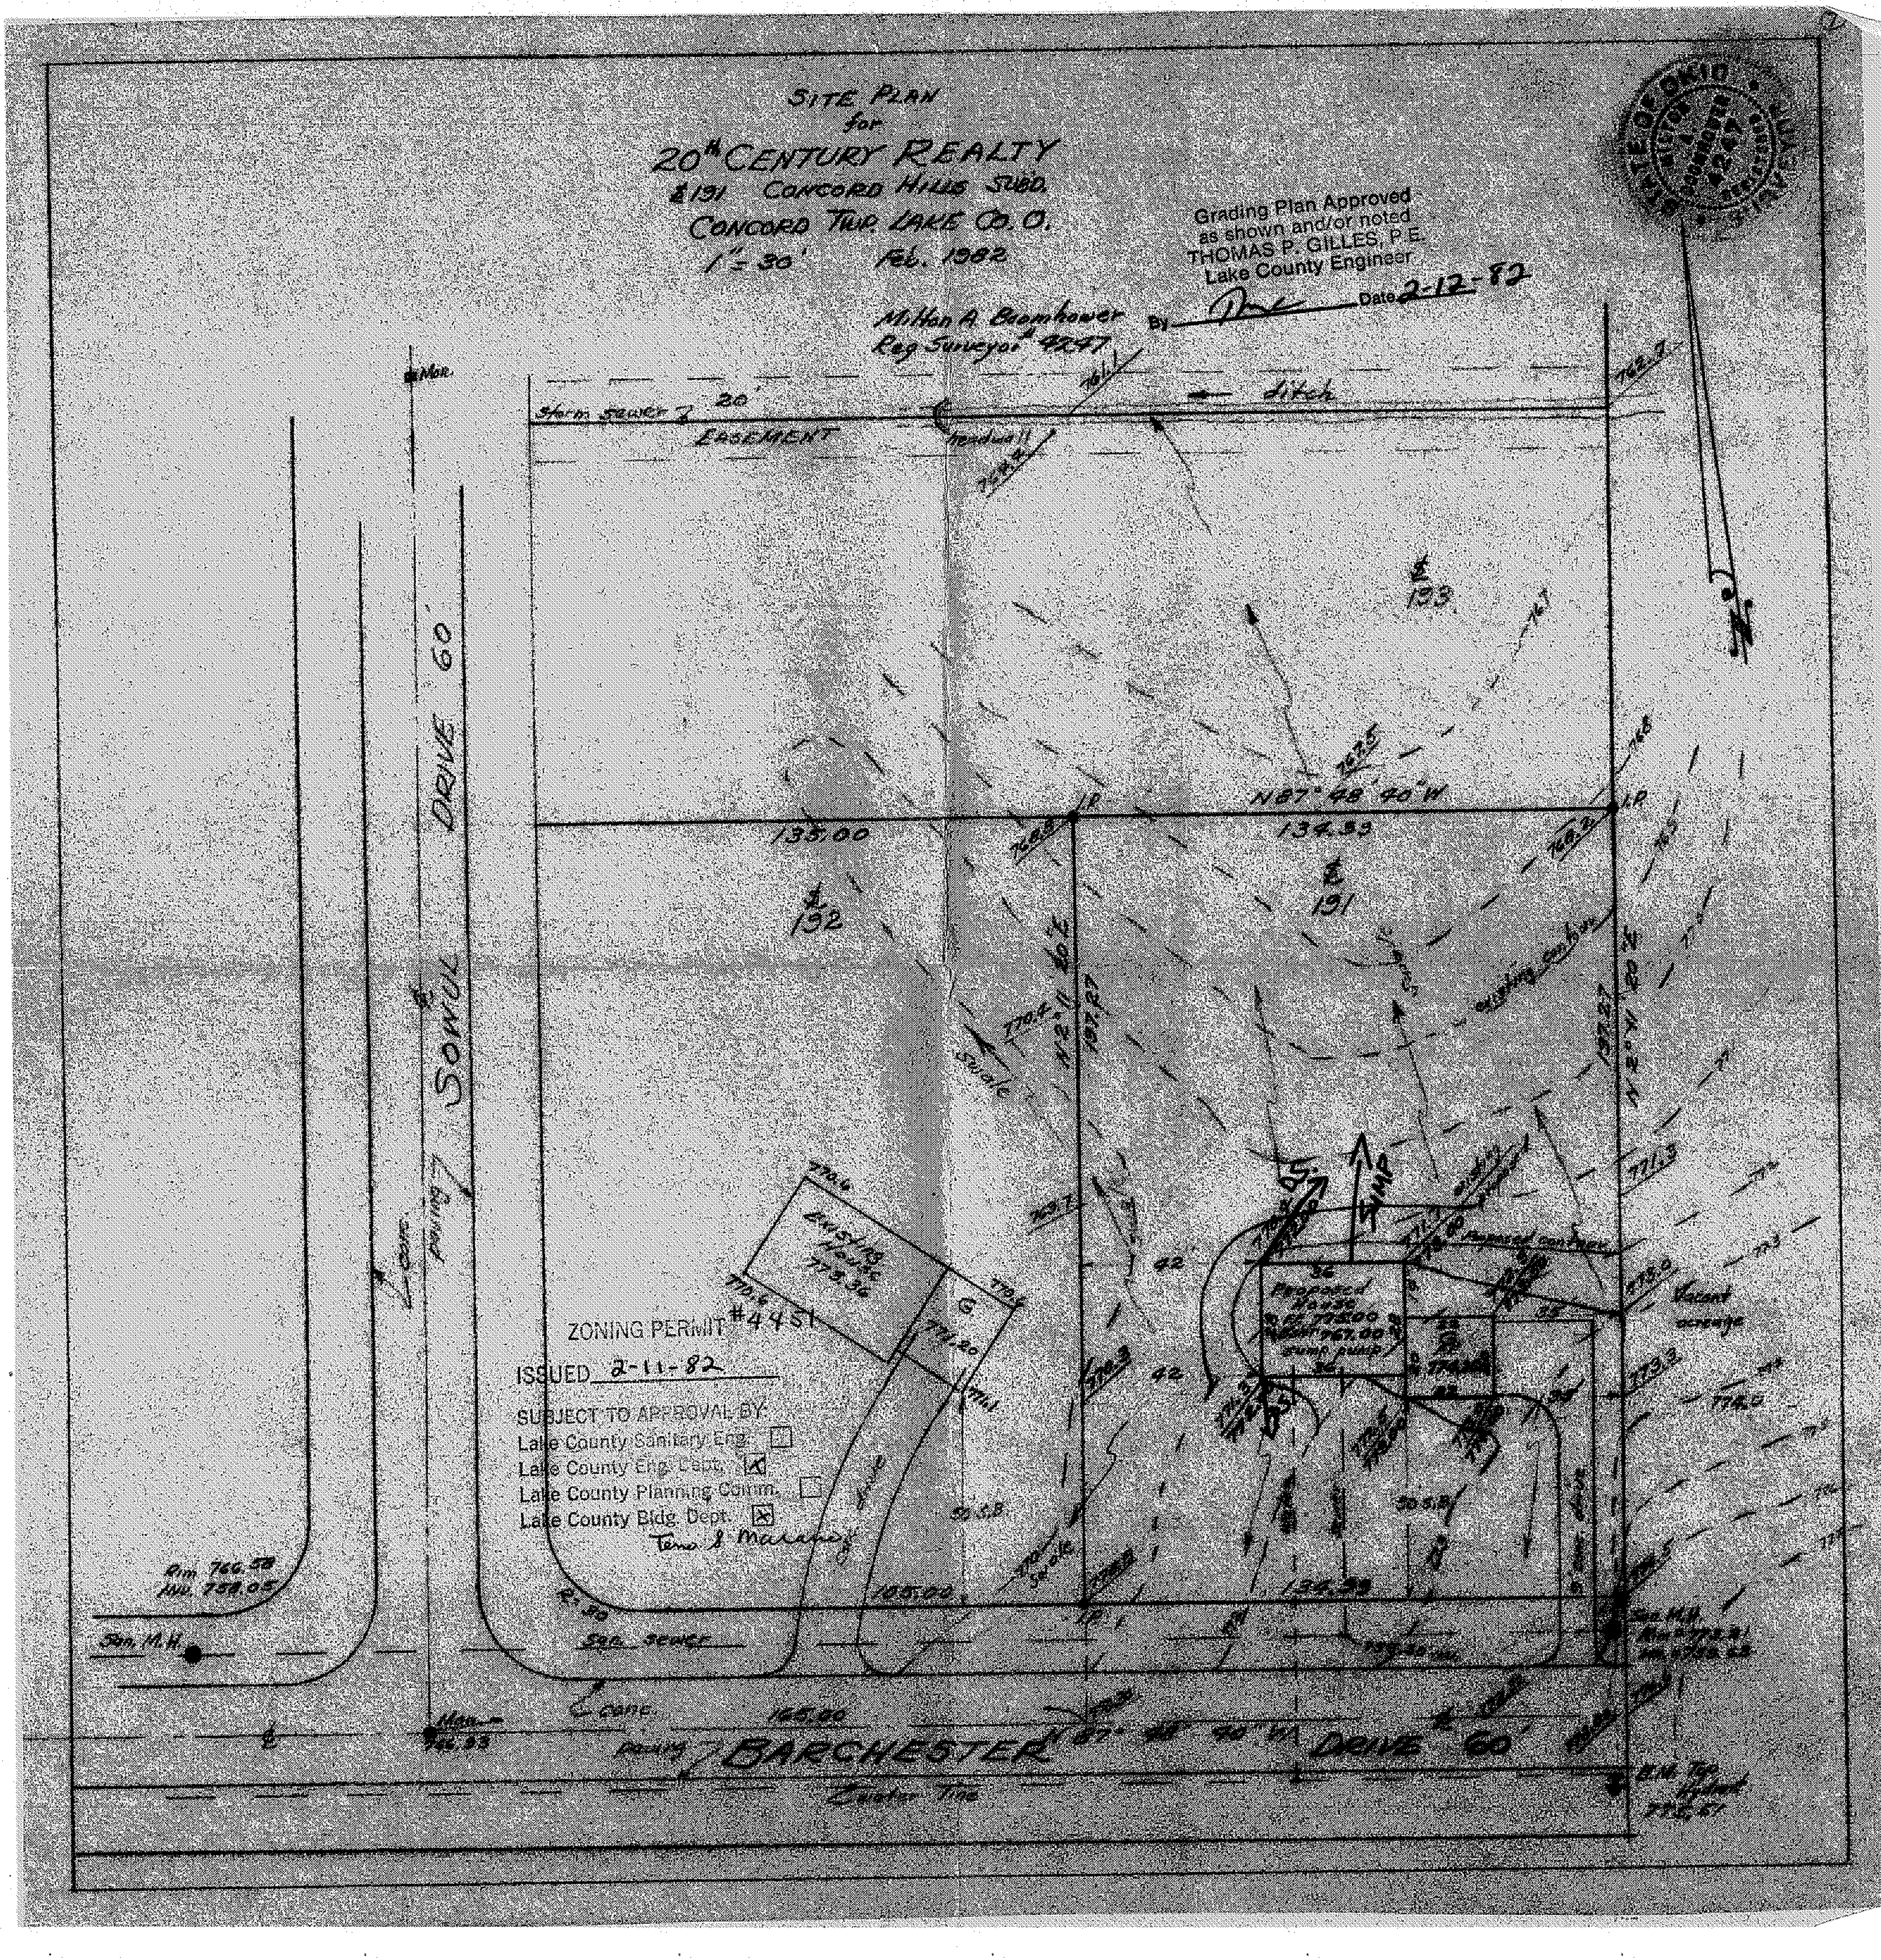
SITE PLAN
for
20th CENTURY REALTY
S/L 191 CONCORD HILLS SUBD.
CONCORD TWP. LAKE CO. O.
1" = 30'
Feb. 1982
Milton A. Bramhower
Reg. Surveyor # 4247
Grading Plan Approved
as shown and/or noted
THOMAS P. GILLES, P.E.
Lake County Engineer
By
Date 2-12-82
Storm sewer
20' EASEMENT
ditch
N 87° 48' 40" W
134.39
135.00
S/L 193
S/L 192
S/L 191
N 2° 11' 20" E
197.27
Swale
existing contour
proposed contour
Existing House
G
Proposed House
sump pump
ZONING PERMIT #4451
ISSUED 2-11-82
SUBJECT TO APPROVAL BY:
Lake County Sanitary Eng.
Lake County Eng. Dept.
Lake County Planning Comm.
Lake County Bldg. Dept.
Vacant acreage
SOWUL DRIVE 60'
BARCHESTER DRIVE 60'
San. M.H.
Rim 766.58
Inv. 758.05
San. sewer
165.00
105.00
135.33
N 87° 48' 40" W

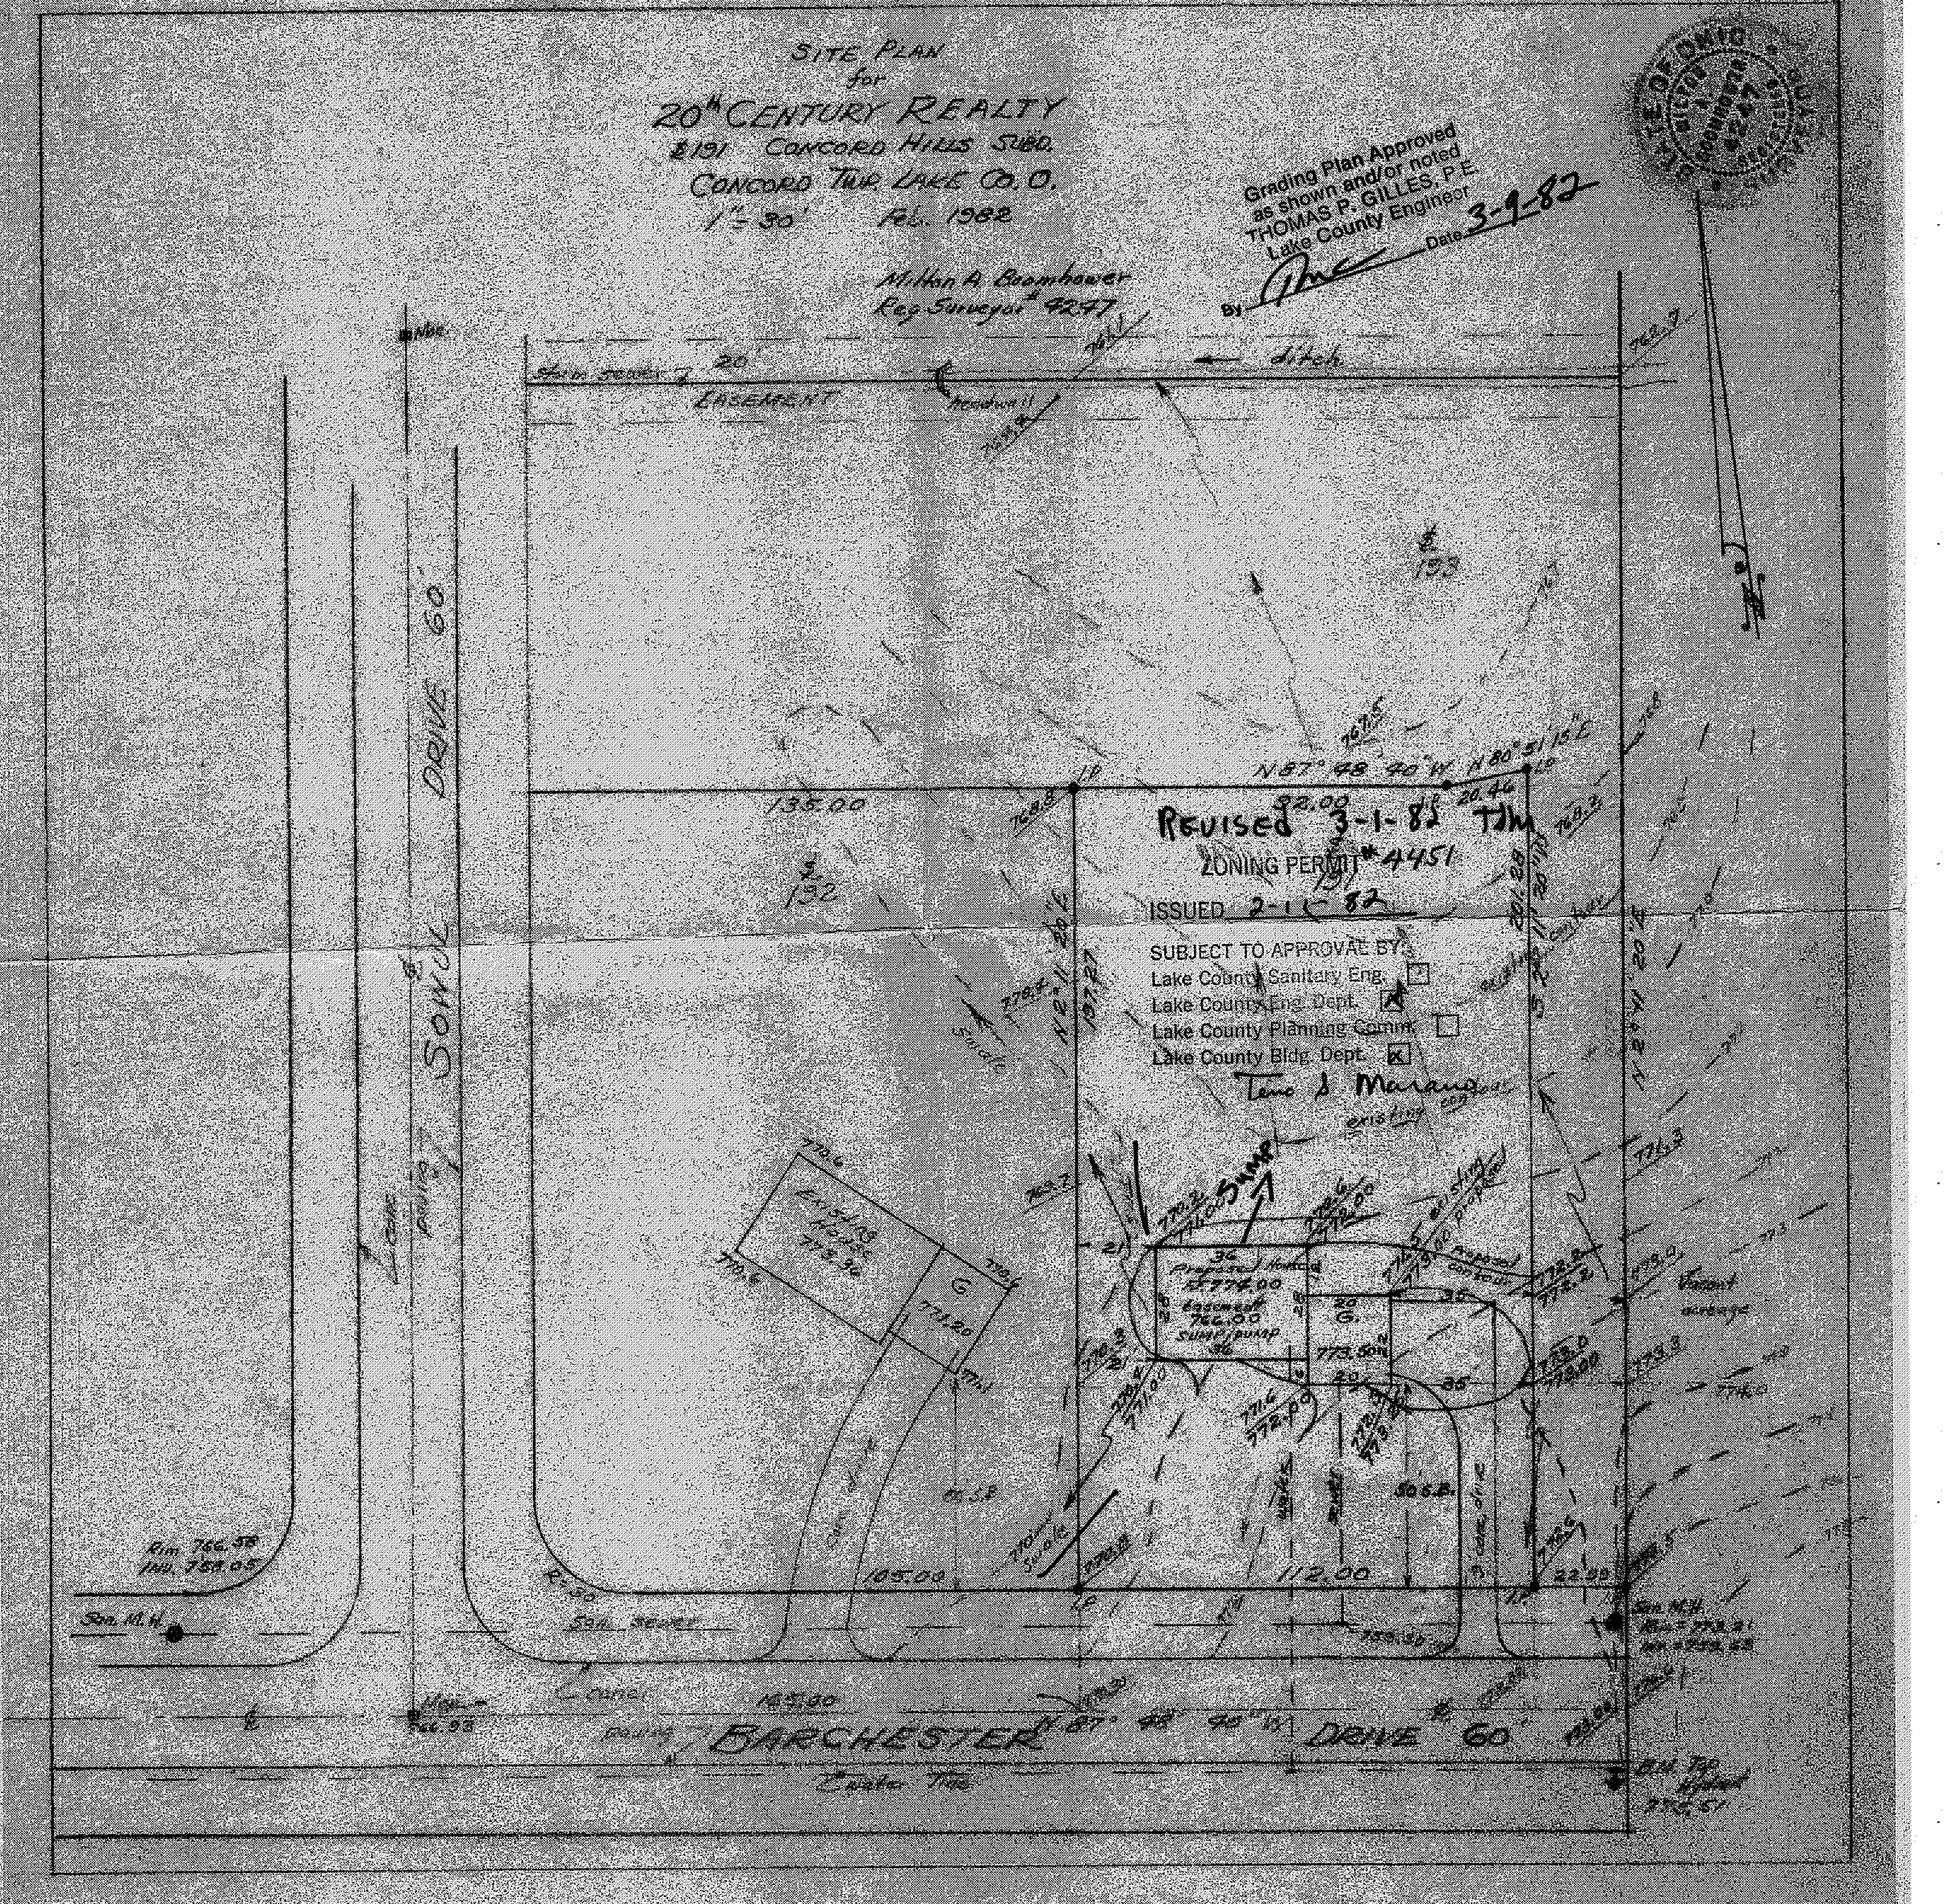
SITE PLAN
for
20th CENTURY REALTY
S191 CONCORD HILLS SUBD.
CONCORD TWP. LAKE CO. O.
1" = 30' FEB. 1982
Milton A. Baumhower
Reg. Surveyor # 4247
Grading Plan Approved
as shown and/or noted
THOMAS P. GILLES, P.E.
Lake County Engineer
By
Date 3-9-82
Storm sewer
20' EASEMENT
headwall
ditch
S. 193
S. 192
135.00
N 87° 48' 40" W
N 80° 51' 15" E
92.00
20.46
REVISED 3-1-82 TJM
ZONING PERMIT # 4451
ISSUED 2-1-82
SUBJECT TO APPROVAL BY:
Lake County Sanitary Eng.
Lake County Eng. Dept.
Lake County Planning Comm.
Lake County Bldg. Dept.
Teno S Marano
existing
proposed
SUMP
Existing House 773.30
G 771.20
36 Proposed House 774.00
Basement 766.00
sump pump
20 G.
773.50
35
proposed contour
Vacant acreage
swale
105.00
112.00
22.95
SOWUL DRIVE 60'
BARCHESTER N 87° 48' 40" W DRIVE 60'
Conc. paving
Center line
R=30
San. sewer
Rim 766.58
Inv. 759.05
San. M.H.
San. M.H.
B.M. Top Hydrant 775.51
165.80