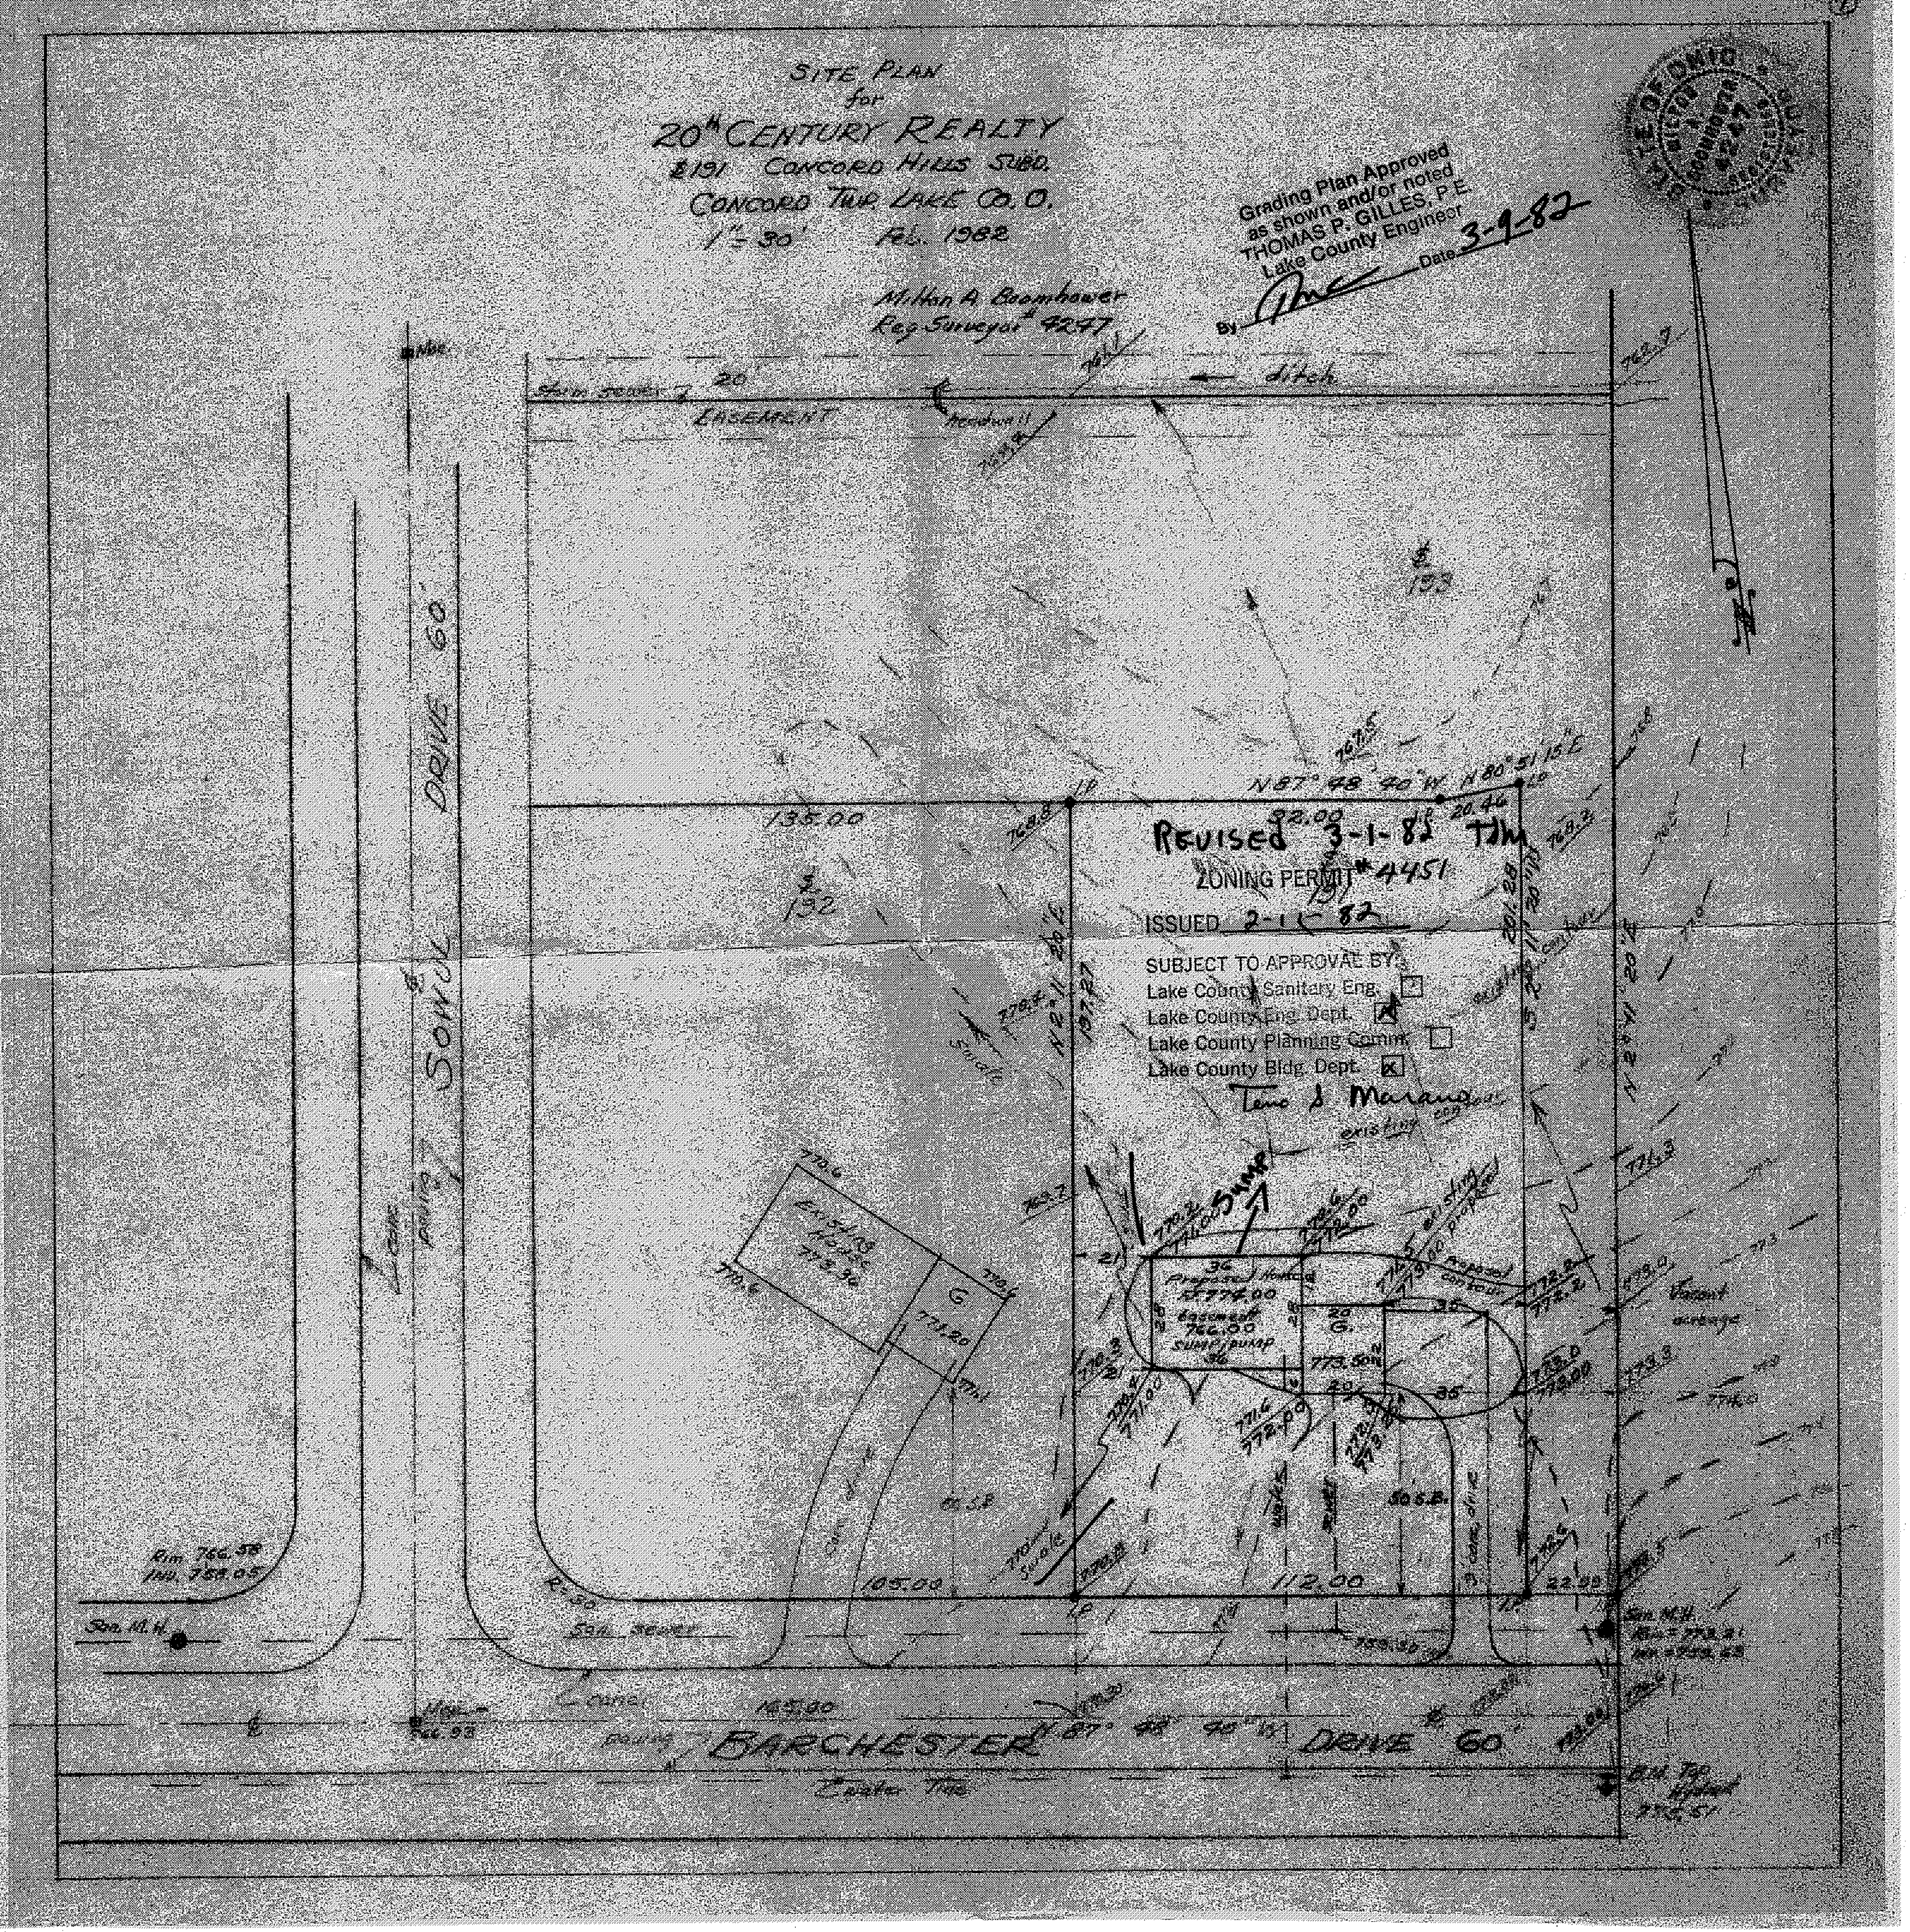

SITE PLAN
for
20th CENTURY REALTY
#191 CONCORD HILLS SUBD.
CONCORD TWP. LAKE CO. O.
1" = 30' FEB. 1982
Milton A. Baumhower
Reg. Surveyor # 4247
Grading Plan Approved
as shown and/or noted
THOMAS P. GILLES, P.E.
Lake County Engineer
By
Date 3-9-82
20' EASEMENT
ditch
headwall
135.00
132
133
N 87° 48' 40" W
N 80° 51' 15" E
20.46
REVISED 3-1-82 TJM
ZONING PERMIT # 4451
ISSUED 2-1 82
SUBJECT TO APPROVAL BY:
Lake County Sanitary Eng.
Lake County Eng. Dept.
Lake County Planning Comm.
Lake County Bldg. Dept.
existing
Existing House 773.30
G 771.20
SUMP
Proposed House 774.00
Basement 766.00
sump pump
20 G.
773.50
35
proposed contour
Vacant acreage
swale
105.00
112.00
22.35
R=30
San. sewer
Rim 766.58
Inv. 759.05
San. M.H.
SOWUL DRIVE 60'
BARCHESTER N 87° 48' 40" W DRIVE 60'
165.90
Center Line
B.M. Top Hydrant