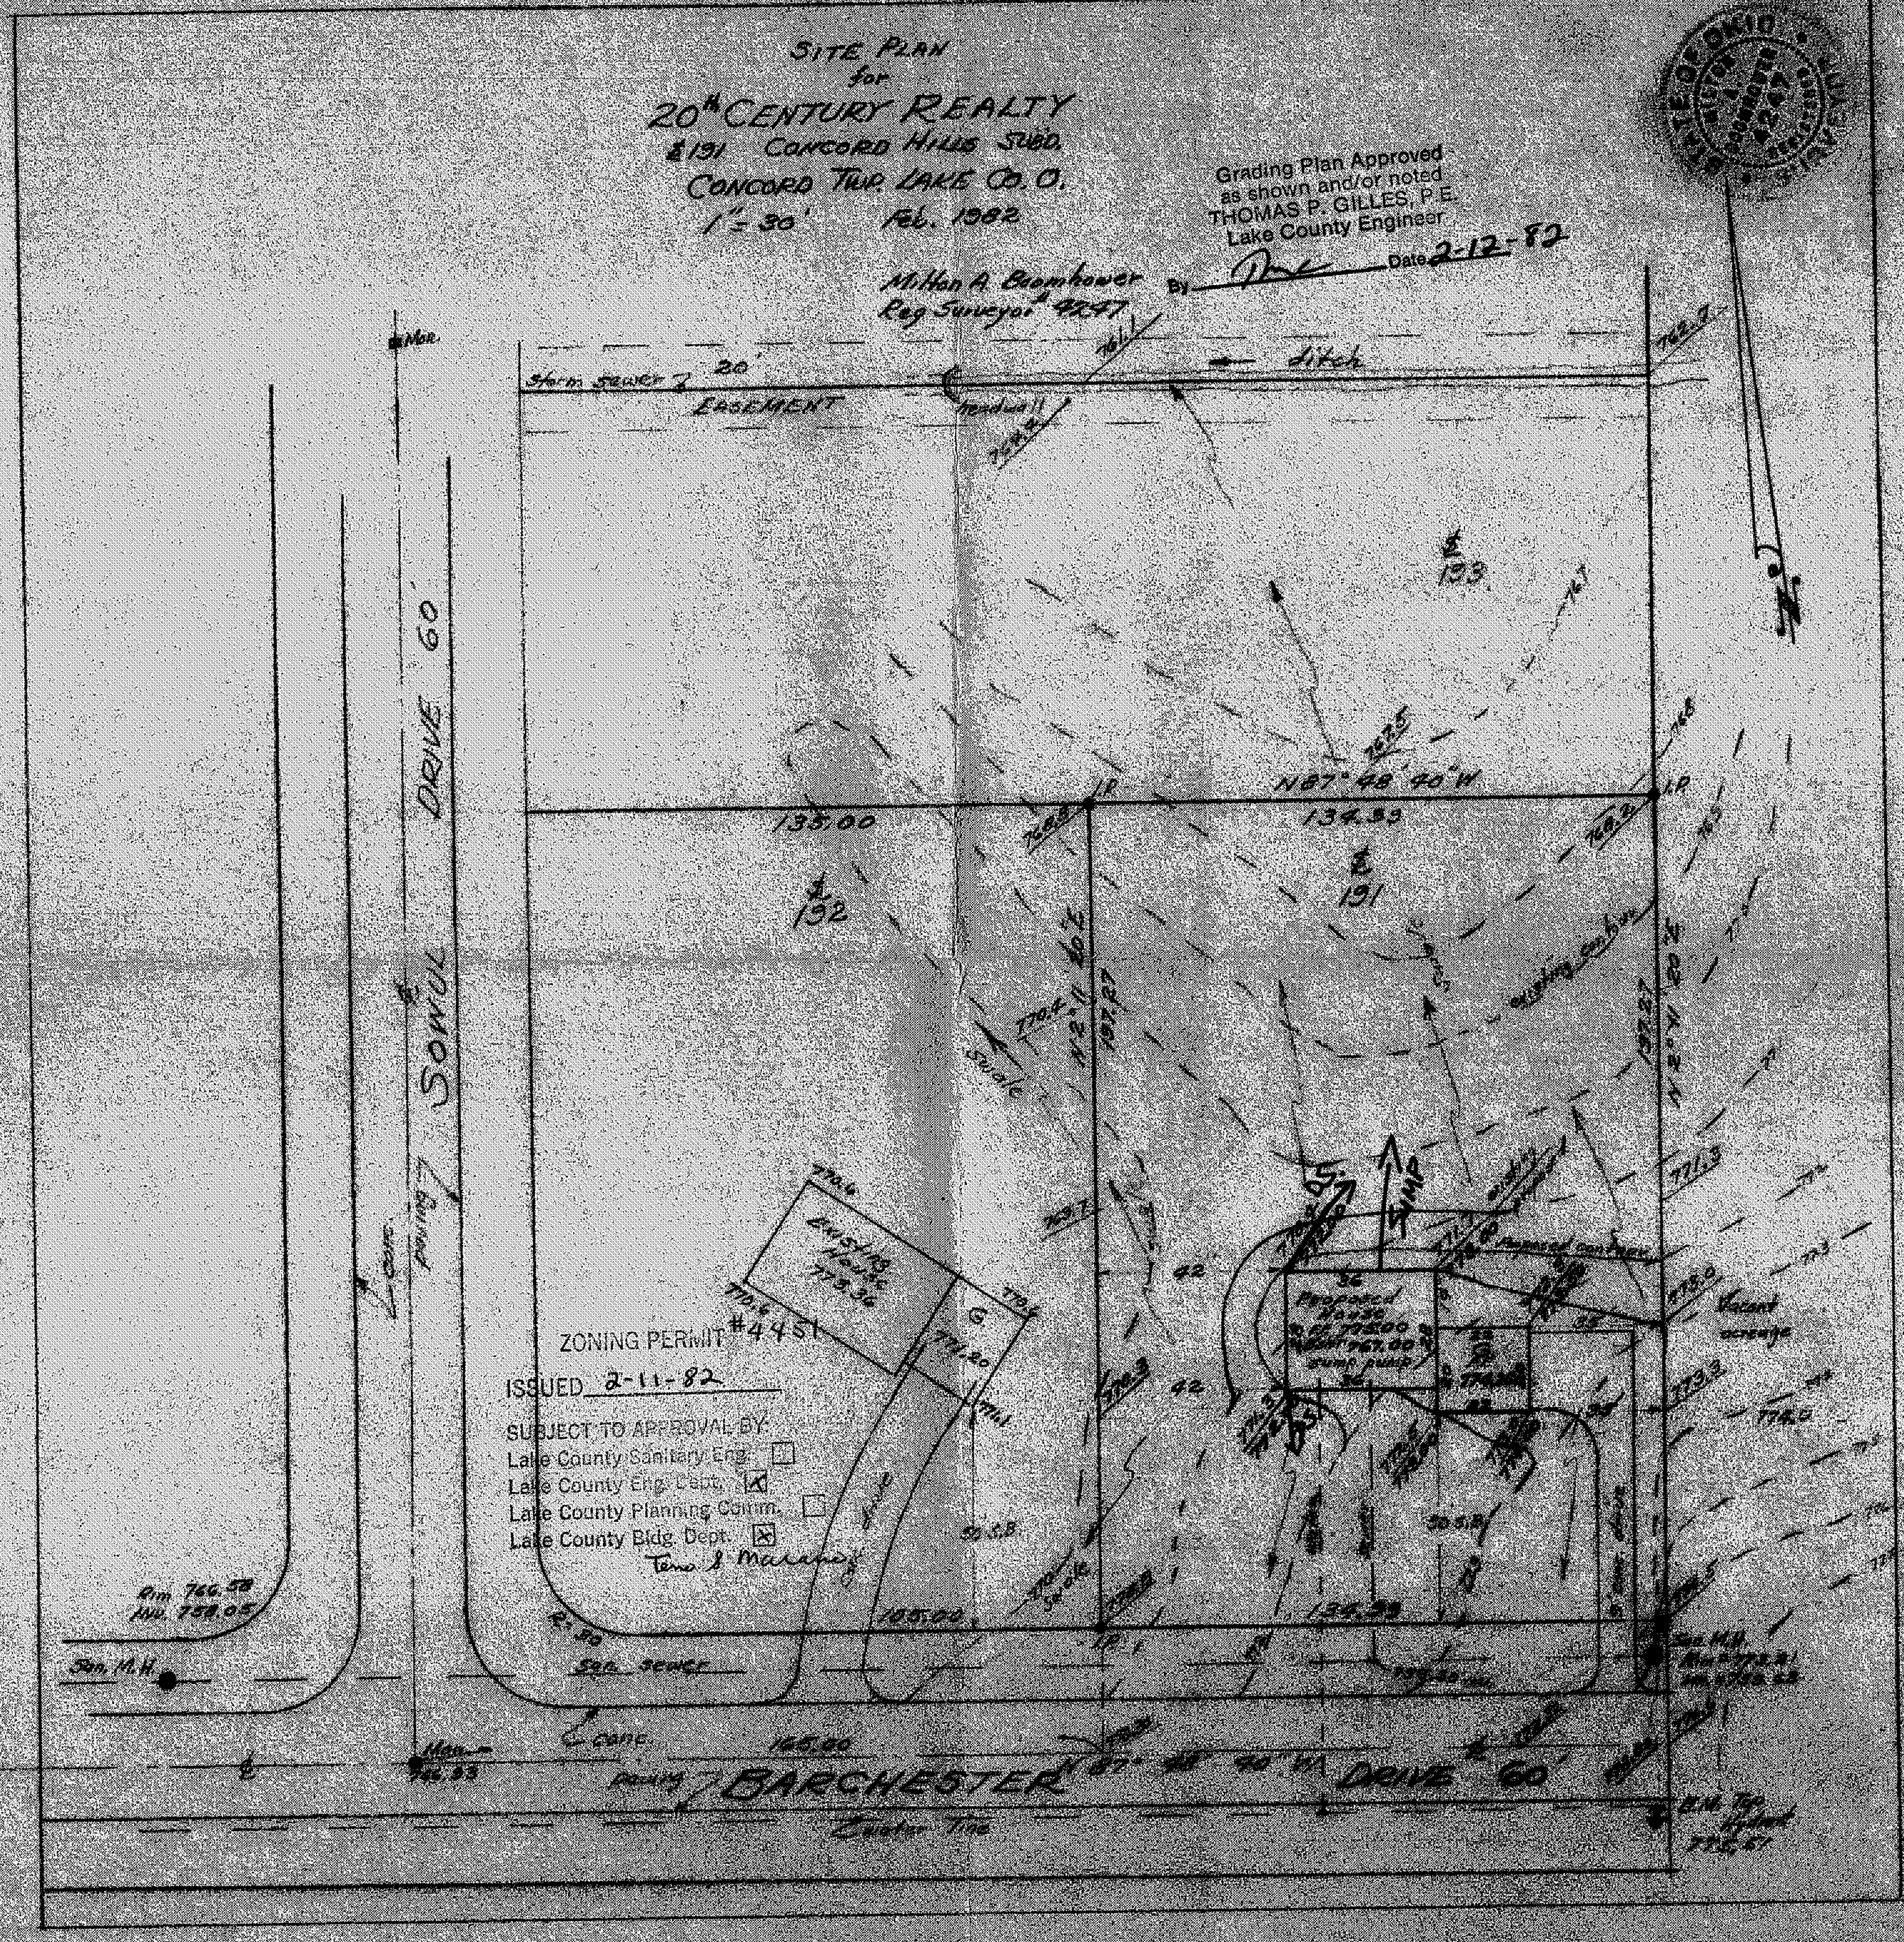
SITE PLAN
for
20th CENTURY REALTY
S/L 191 CONCORD HILLS SUBD.
CONCORD TWP. LAKE CO. O.
1" = 30'
Feb. 1982
Milton A. Baumhower
Reg. Surveyor #4247
Grading Plan Approved
as shown and/or noted
THOMAS P. GILLES, P.E.
Lake County Engineer
By
Date 2-12-82
Storm sewer
20'
EASEMENT
ditch
N 87° 48' 40" W
135.00
134.33
132
131
133
N 2° 11' 20" E
197.27
Swale
Existing House
Proposed House
G
ZONING PERMIT #4451
ISSUED 2-11-82
SUBJECT TO APPROVAL BY:
Lake County Sanitary Eng.
Lake County Eng. Dept.
Lake County Planning Comm.
Lake County Bldg. Dept.
105.00
165.00
San. sewer
SOMUL DRIVE 60'
BARCHESTER DRIVE 60'
San. M.H.
Vacant acreage