Pg 51 of 75 L. County profile A-A Big Creek @ 86
100 yr elev 624± TMC

SITE PLAN
FOR
HOWARD VENALECK
BEING SUBLOT NO. 37 OF THE BIG CREEK SUB'D IN THE TOWNSHIP OF CONCORD, LAKE COUNTY, OHIO

Grading Plan Approved as shown and/or noted
THOMAS P. GILLES, P.E.
Lake County Engineer
By JCG Date 5-17-87

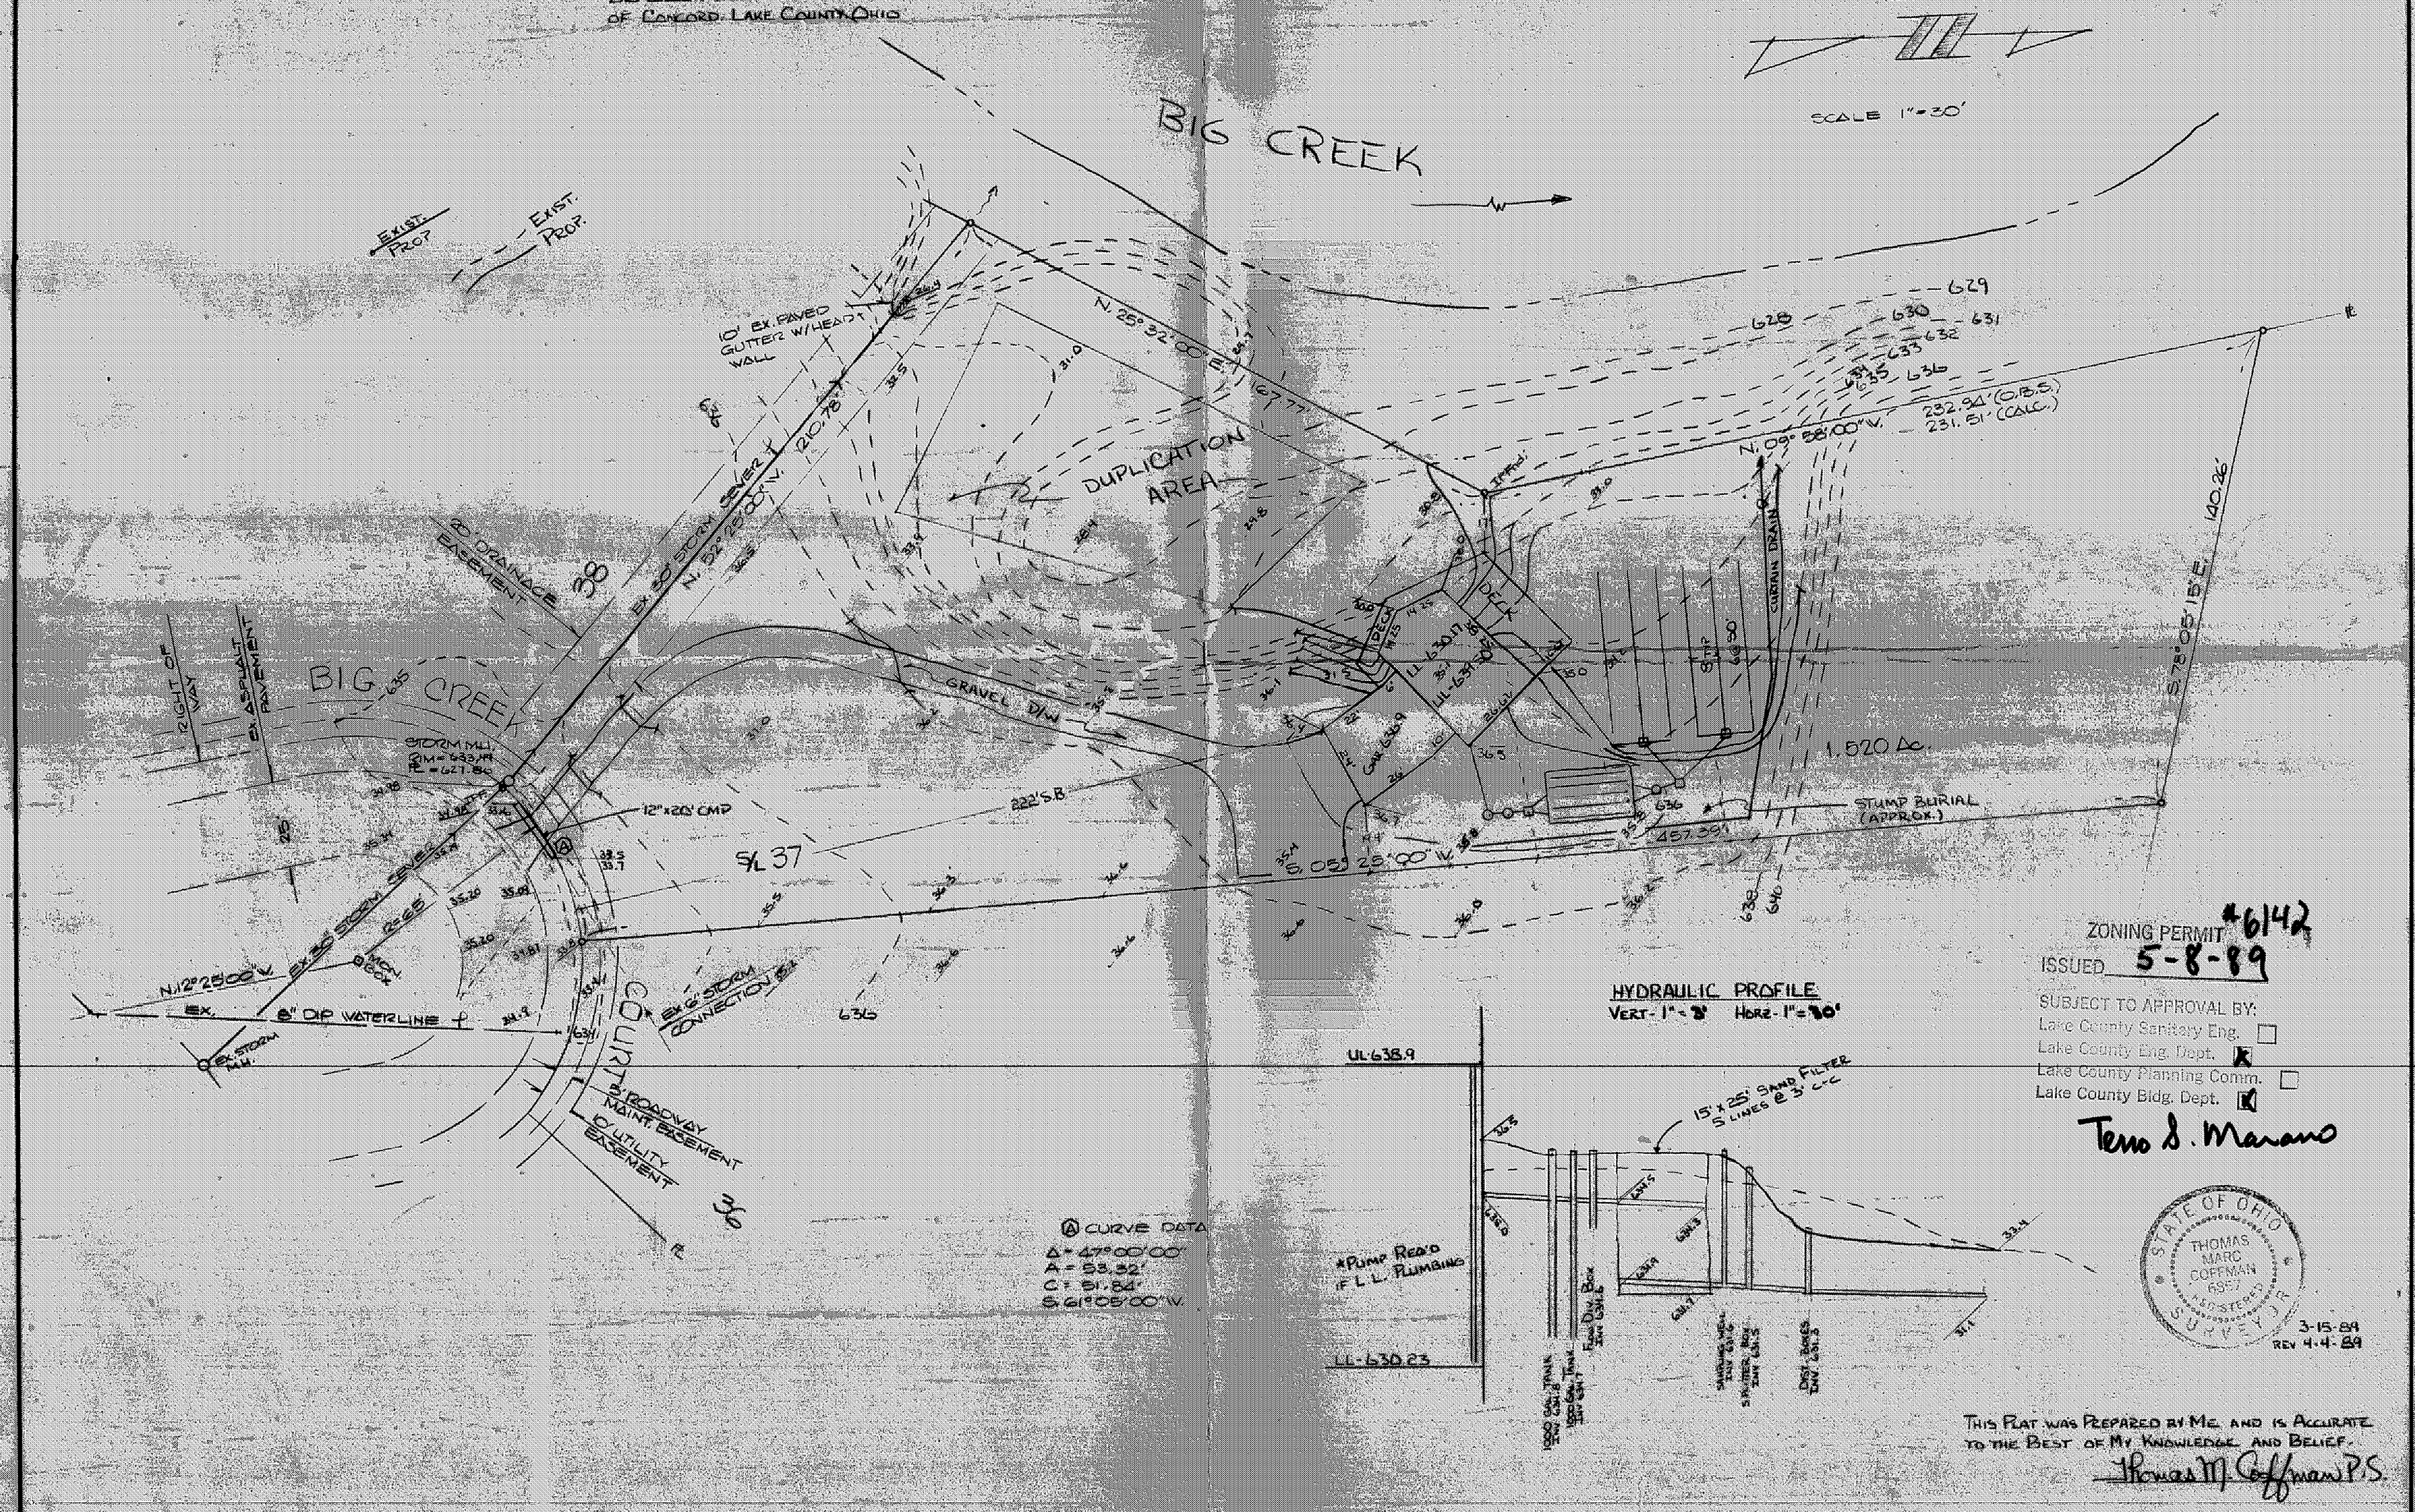

ZONING PERMIT #6142
ISSUED 5-8-89
SUBJECT TO APPROVAL BY:
Lake County Sanitary Eng. ☐
Lake County Eng. Dept. ☒
Lake County Planning Comm. ☐
Lake County Bldg. Dept. ☒
Terro S. Marano

Ⓐ CURVE DATA
Δ = 47°00'00"
A = 53.32'
C = 51.84'
S. 61°05'00" W.

STATE OF OHIO
THOMAS MARC COFFMAN
6857
REGISTERED
SURVEYOR

3-15-89
REV 4-4-89

THIS PLAT WAS PREPARED BY ME AND IS ACCURATE TO THE BEST OF MY KNOWLEDGE AND BELIEF.
Thomas M. Coffman P.S.