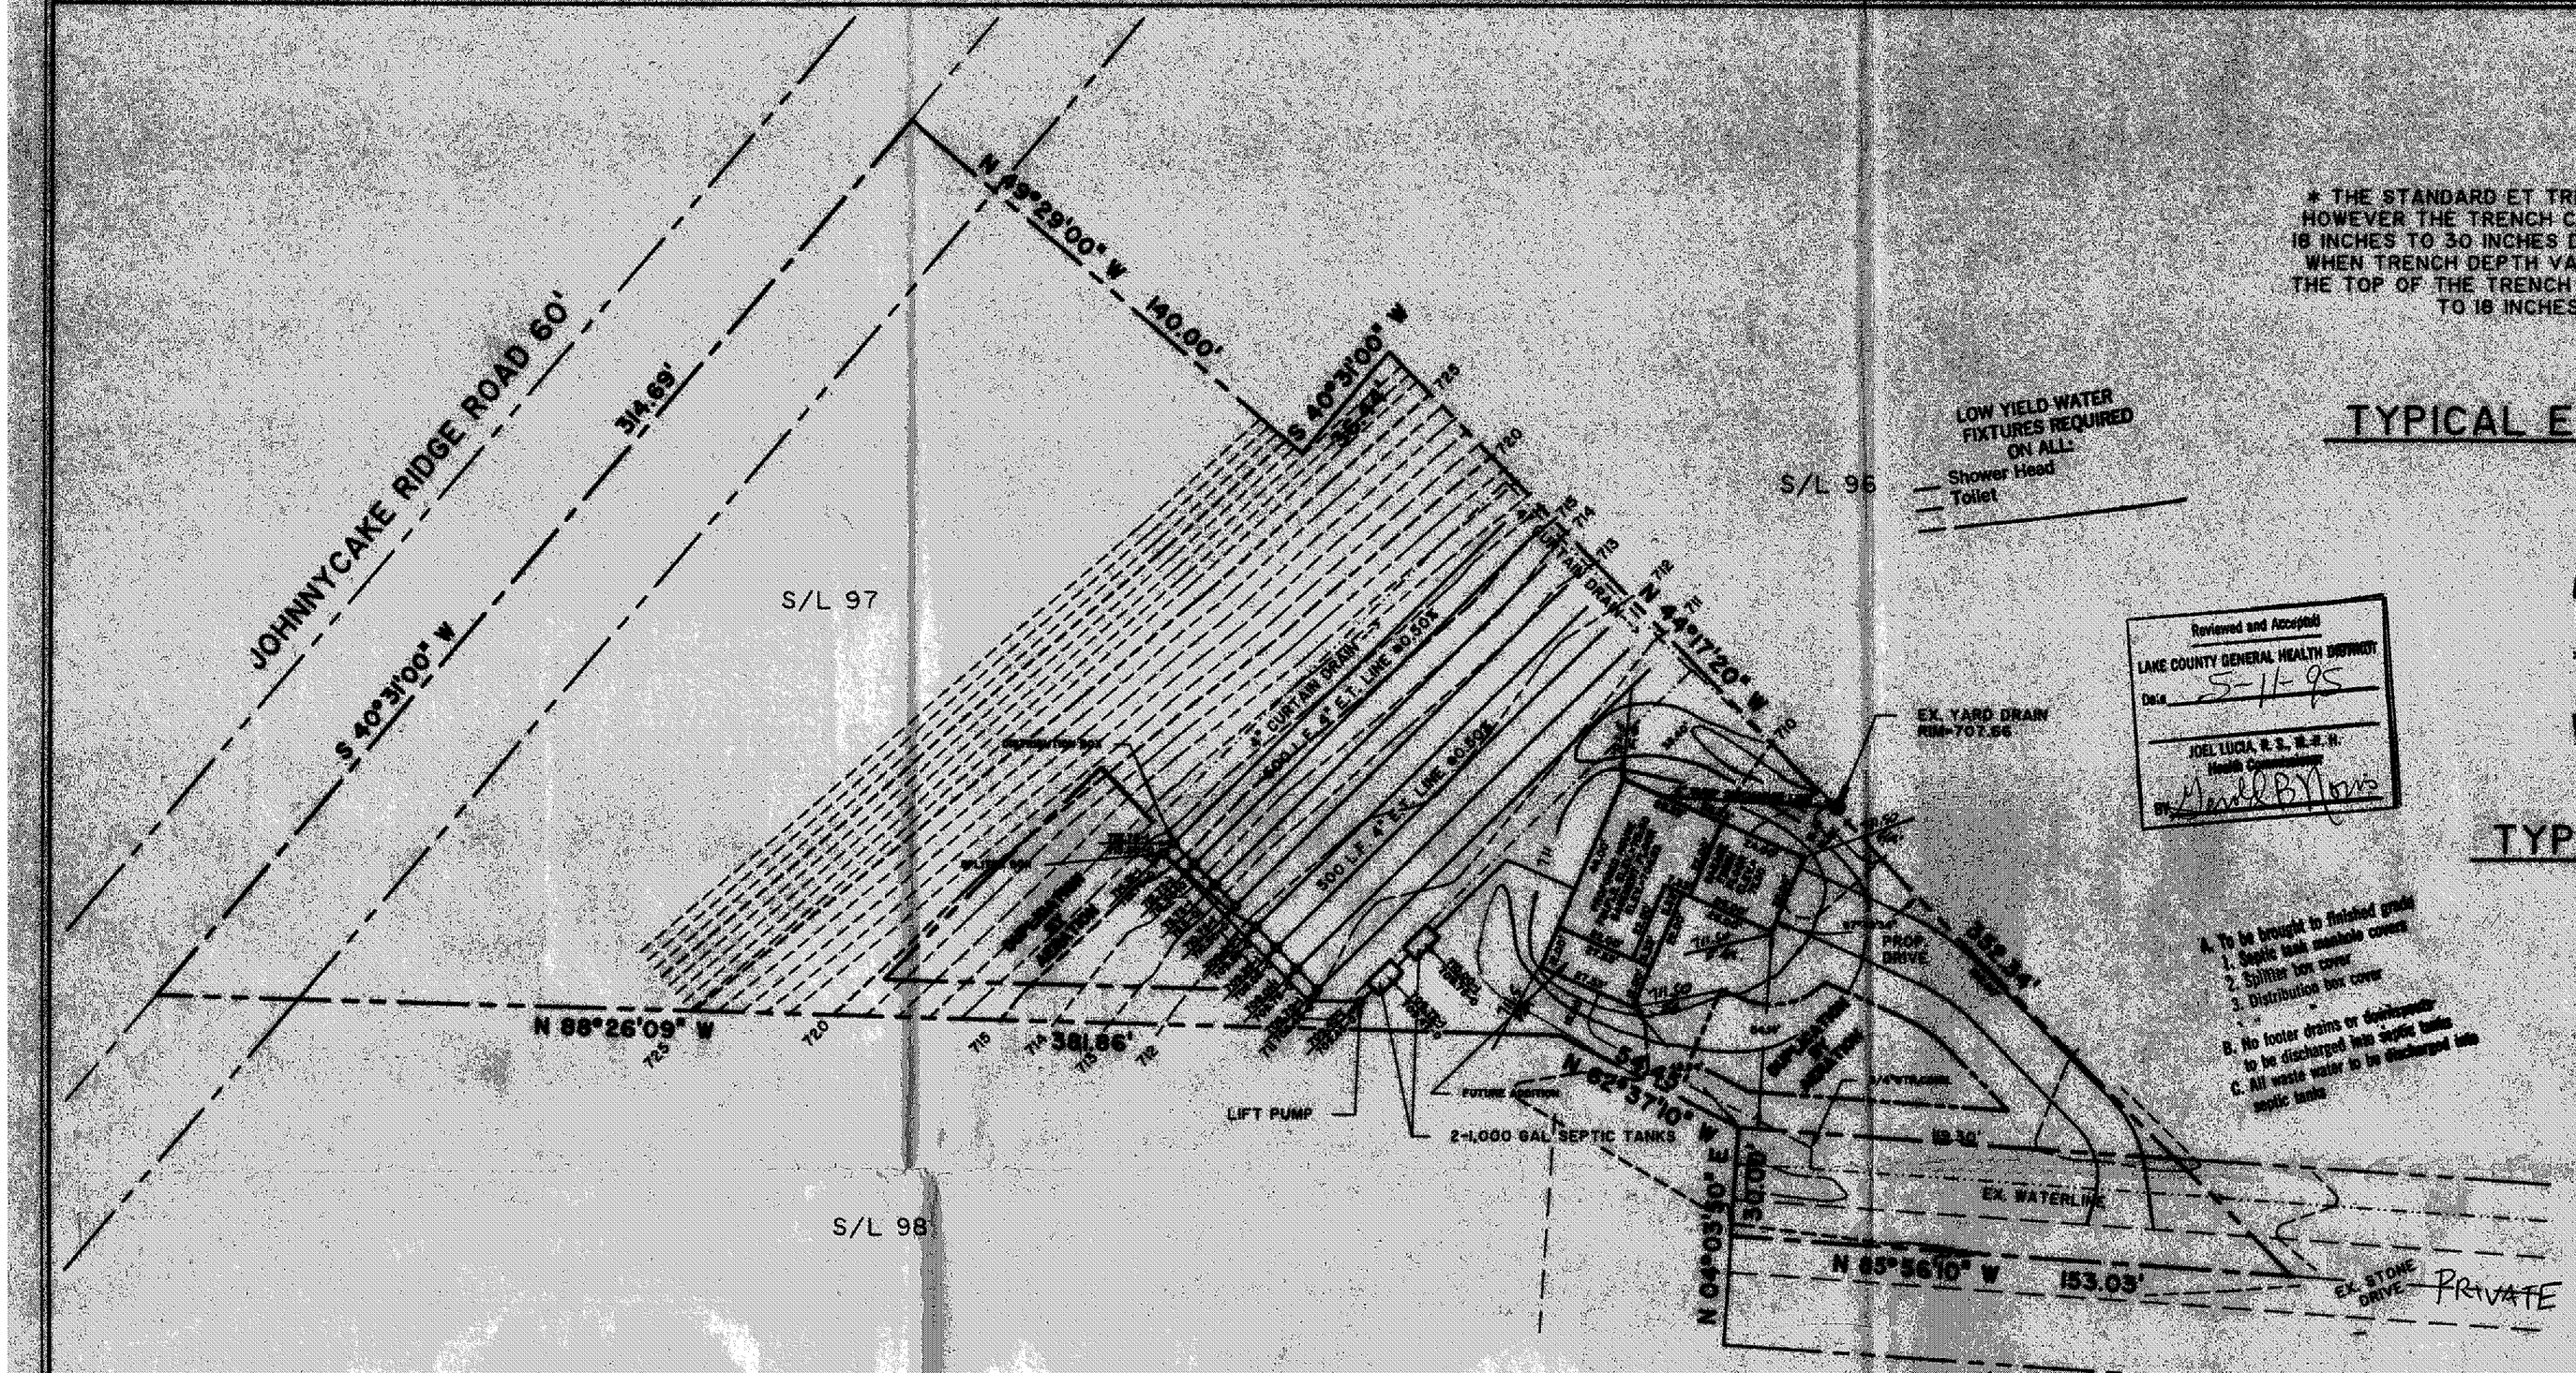

LOW YIELD WATER FIXTURES REQUIRED ON ALL:
- Shower Head
- Toilet

Reviewed and Accepted
LAKE COUNTY GENERAL HEALTH DISTRICT
Date 5-11-95
JOEL LUCIA, R.S., M.P.H.
Health Commissioner
By: Harold B Lyons

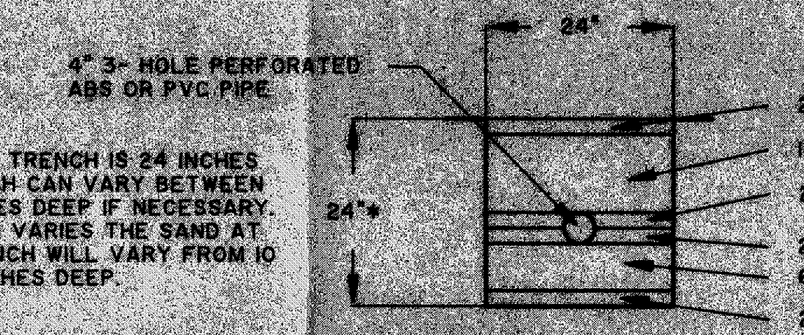

* THE STANDARD ET TRENCH IS 24 INCHES HOWEVER THE TRENCH CAN VARY BETWEEN 18 INCHES TO 30 INCHES DEEP IF NECESSARY. WHEN TRENCH DEPTH VARIES THE SAND AT THE TOP OF THE TRENCH WILL VARY FROM 10 TO 18 INCHES DEEP.

TYPICAL EVAPOTRANSPIRATION TRENCH CROSS SECTION

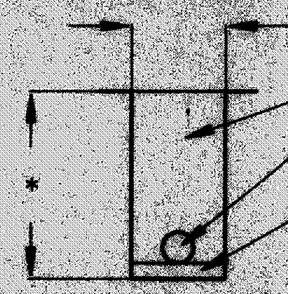

* THE CURTAIN DRAIN MUST BE 6 INCHES DEEPER THAN DEEPEST ET/LEACHING TRENCH BOTTOM

TYPICAL CURTAIN DRAIN CROSS SECTION

A. To be brought to finished grade
1. Septic tank manhole covers
2. Splitter box cover
3. Distribution box cover
B. No footer drains or downspouts to be discharged into septic tanks
C. All waste water is to be discharged into septic tanks

GENERAL NOTES:

1. DRIVEWAY APRON TO BE 6" THICK
2. BENCHMARK - TOP STEM OF FIRE HYDRANT LOCATED 125 EAST OF SUBLOT 97. ELEV.=709.48

LEGEND

- EXISTING CONTOUR
- PROPOSED CONTOUR
- 100.00 EXISTING ELEVATION
- 100.00 PROPOSED ELEVATION

NORTH

CERTIFICATION:

"I THE UNDERSIGNED HEREBY CERTIFY THAT THIS TOPOGRAPHY INDICATED BY (CONTOURS AND ELEVATIONS SHOWN HEREON REPRESENTS AN ACTUAL SURVEY MADE BY ME ON THE 25th DAY OF JAN. , 1995 AND THE ELEVATIONS WERE TAKEN AT APPROPRIATE INTERVALS AND AS OF THAT DAY THEY EXISTED AS INDICATED HEREON.

"I HEREBY CERTIFY THAT THIS PLAN WAS PREPARED BY ME AND IS CORRECT TO THE BEST OF MY KNOWLEDGE"

DAVID W. NOVAK, P.S. No. 7507

ZONING PERMIT
ISSUED 0595-8140 5/11/95
SUBJECT TO APPROVAL BY:
Lake County Sanitary Eng. ☐
Lake County Eng. Dept. ☒
Lake County Planning Comm. ☐
Lake County Bldg. Dept. ☒

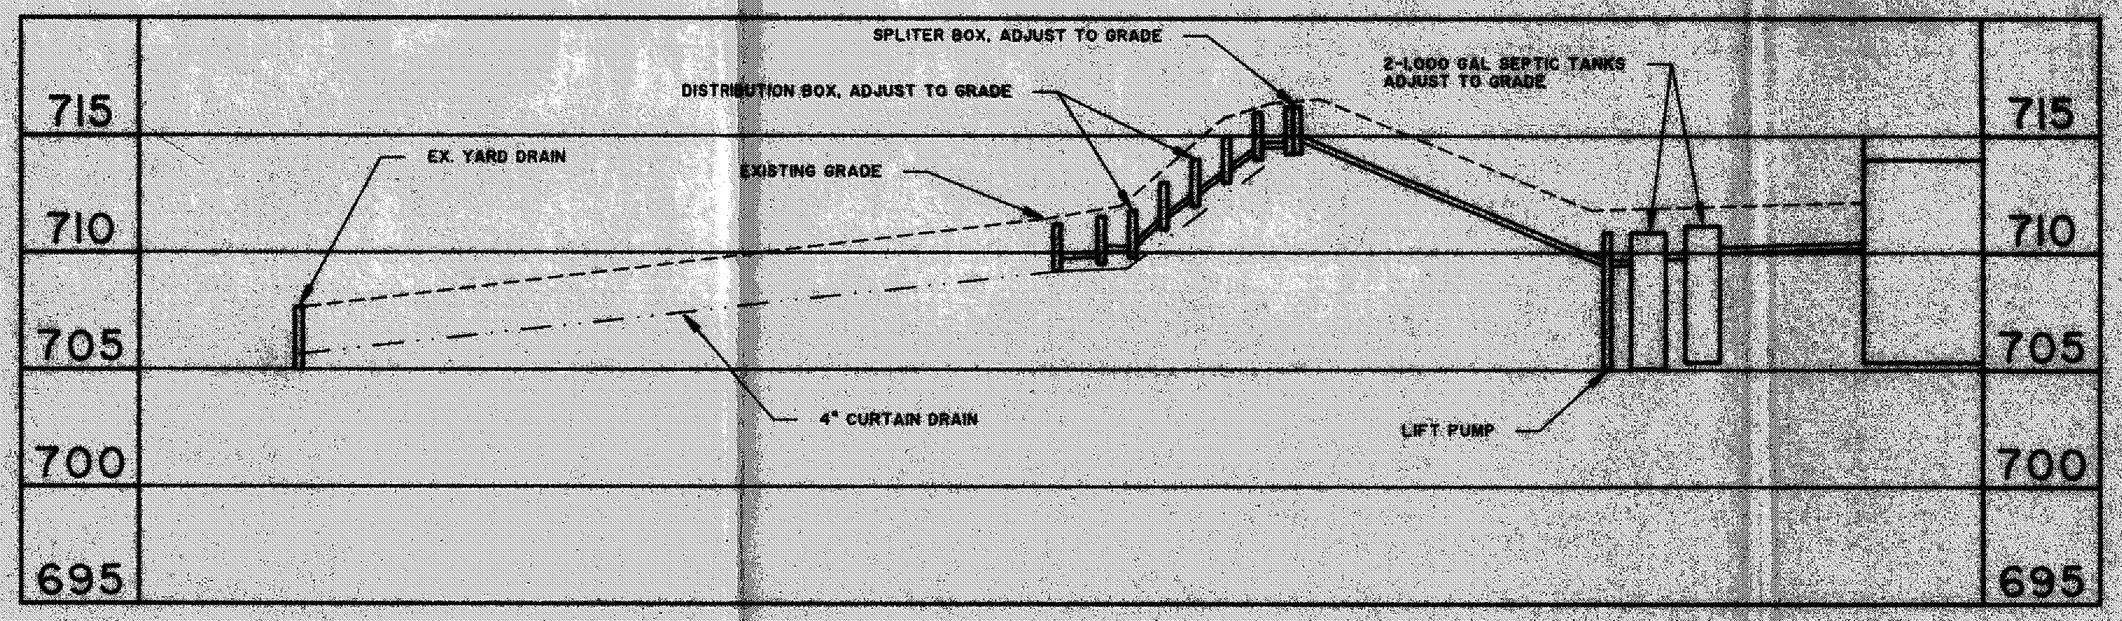

SEWAGE DISPOSAL PERMIT MUST BE OBTAINED BY A LAKE COUNTY LICENSED INSTALLER BEFORE INSTALLATION IS STARTED.

Grading Plan Approved as shown and/or noted
THOMAS P. GILLES, P.E.
Lake County Engineer
By: GJH Date 5 15 95
Downspout shall discharge to splash blocks

GRAPHIC SCALE

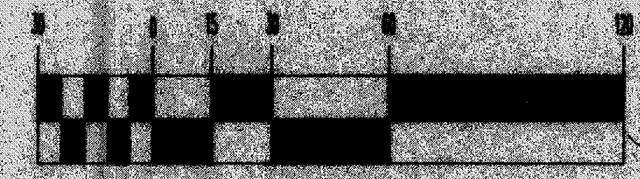

(IN FEET)
1 inch = 8 ft.

ZONING PERMIT
ISSUED
SUBJECT TO APPROVAL BY:
Lake County Sanitary Eng. ☐
Lake County Eng. Dept. ☒
Lake County Planning Comm. ☐
Lake County Bldg. Dept. ☒

REV. No.	DESCRIPTION	DATE	BY	CHK'D.
A	REV. HOUSE LOC. AND SEPTIC SYS.	04/27/95	DWN	
B	REVISED SEPTIC SYSTEM	05/09/95	DWN	

STATE OF OHIO · DAVID W. NOVAK S-7507 · REGISTERED SURVEYOR

Himebaugh and Novak
Surveyors and Site Consultants
8663 Tyler Boulevard
Mentor, Ohio 44060-4346
(216) 974-7670, (216) 255-5900 FAX.

LITTLE MOUNTIAN HOMES, INC.
1447 NORTH RIDGE ROAD, PAINESVILLE, OH. 44077

DATE: JAN. 23, 1995
DRAWN BY: D. W. NOVAK
CHECKED BY: DWN
APPROVED BY:
P.E. No. — P.S. No. —

SITE PLAN
SUBLOT 97, BRADLEY COURT EXTENSION

SCALE:
HORZ.: 1" = 30'
VERT.: 1" = 8'
CONTRACT No. 95004-97
SHEET No. 1 OF 1

MAY 10 1995