SITE PLAN
FOR
MARK UNGER

BEING PARCEL 2 OF ORIG. LOT NO. 14
BREEZEWOOD DRIVE, TOWNSHIP OF
CONCORD, LAKE COUNTY, OHIO.

N
1"=20'

PARCEL "3"
PARCEL "4"
PARCEL "2" - 0.9538 Ac.
PARCEL "1"
S0°11'20"E 328.45'
N0°11'20"W 500.00'
S32°41'40"E 186.05'
IRF
FOOTER & CURTAIN DRAIN
DUPLICATION AREA
PUMP TO DUPLICATION WITH AERATION
PROP WELL
10' RAD
12" @ 83.33'
WATER LINE
F.F. - 818.71
F.F. - 820.25
BSMT - 810.92
3 BDR.
GAR. - 818.25
20' CONC DRIVE
S0°44'45"E 13.50'
S89°10'15"W 40.42'
EXIST 12" x 24" CMP
226.5' TO ℄ OF PYLE WARREN RD.
BREEZEWOOD DR. 60'
EXIST. PROP.
EXIST. PROP.
801 802 803 804 805 806 807 808 809 810 811 812 813 814 815 816 817 818

E.T. CURTAIN DRAIN TRENCH DETAIL

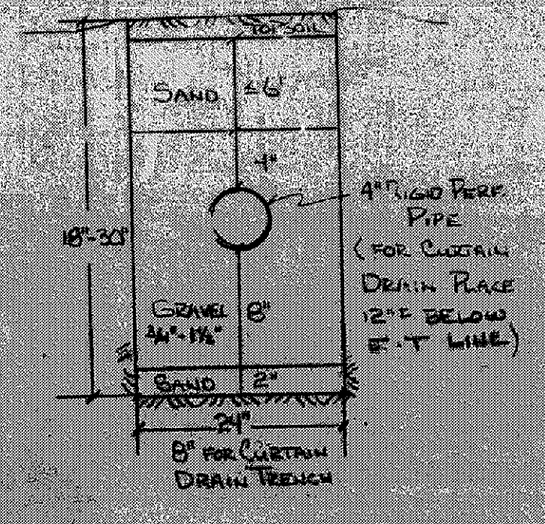

HYDRAULIC PROFILE
VERT. 1"=6' HORZ. 1"=20'

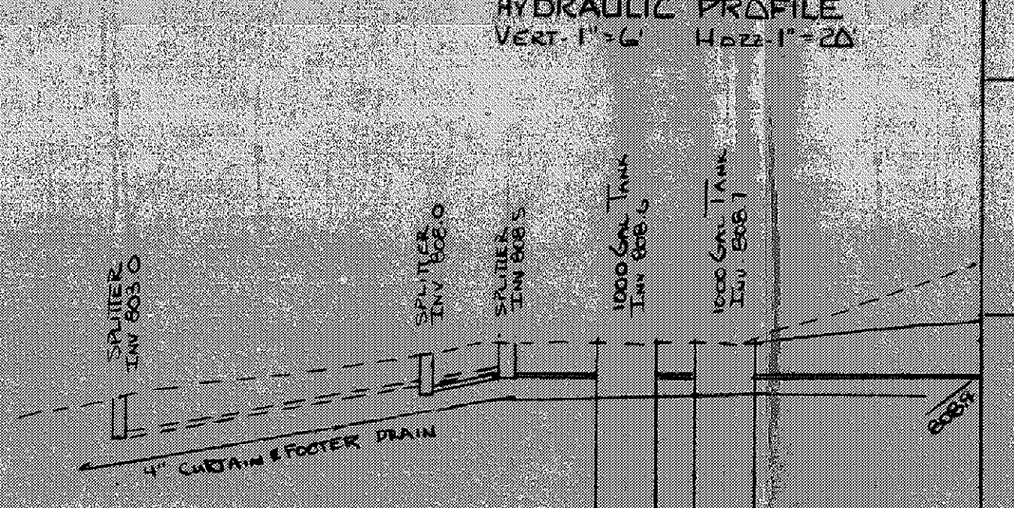

Reviewed and Accepted
LAKE COUNTY GENERAL HEALTH DISTRICT
Date 5-31-90
[illegible], R.S., A.M., P.H.
Health Commissioner
By Neil B. Myers

ZONING PERMIT
ISSUED July 9, 1990 #6538

SUBJECT TO APPROVAL BY:
- Lake County Sanitary Eng. ☐
- Lake County Eng. Dept. ☐
- Lake County Planning Comm. ☐
- Lake County Bldg. Dept. ☐

Grading Plan Approved as shown and/or noted
THOMAS P. GILLES, P.E.
Engineer
GJH 9/5/90

A. To be brought to finished grade
1. Septic tank manhole covers
2. Splitter box cover
3. Distribution box cover
B. No footer drains or downspouts to be discharged into septic tanks
C. All waste water to be discharged into septic tanks

LOW YIELD WATER FIXTURES REQUIRED ON ALL:
- Shower Head
- Toilet

SEWAGE DISPOSAL PERMIT MUST BE OBTAINED BY A LAKE COUNTY LICENSED INSTALLER BEFORE INSTALLATION IS STARTED.

Rev 5-22-90
WELL, DUPL. DRIVE

I, the undersigned hereby certify that this topography, indicated by contours and elevations shown hereon represent an actual field survey made by me on APRIL 24, 1990 and that the elevations were taken at appropriate intervals and that as of this date they existed as indicated hereon.

J.M. Coffman P.S. #6857

VILLAGE SURVEYING Co.
202 THIRD ST., FAIRPORT HBR., OHIO 44077
(216) 357-1359