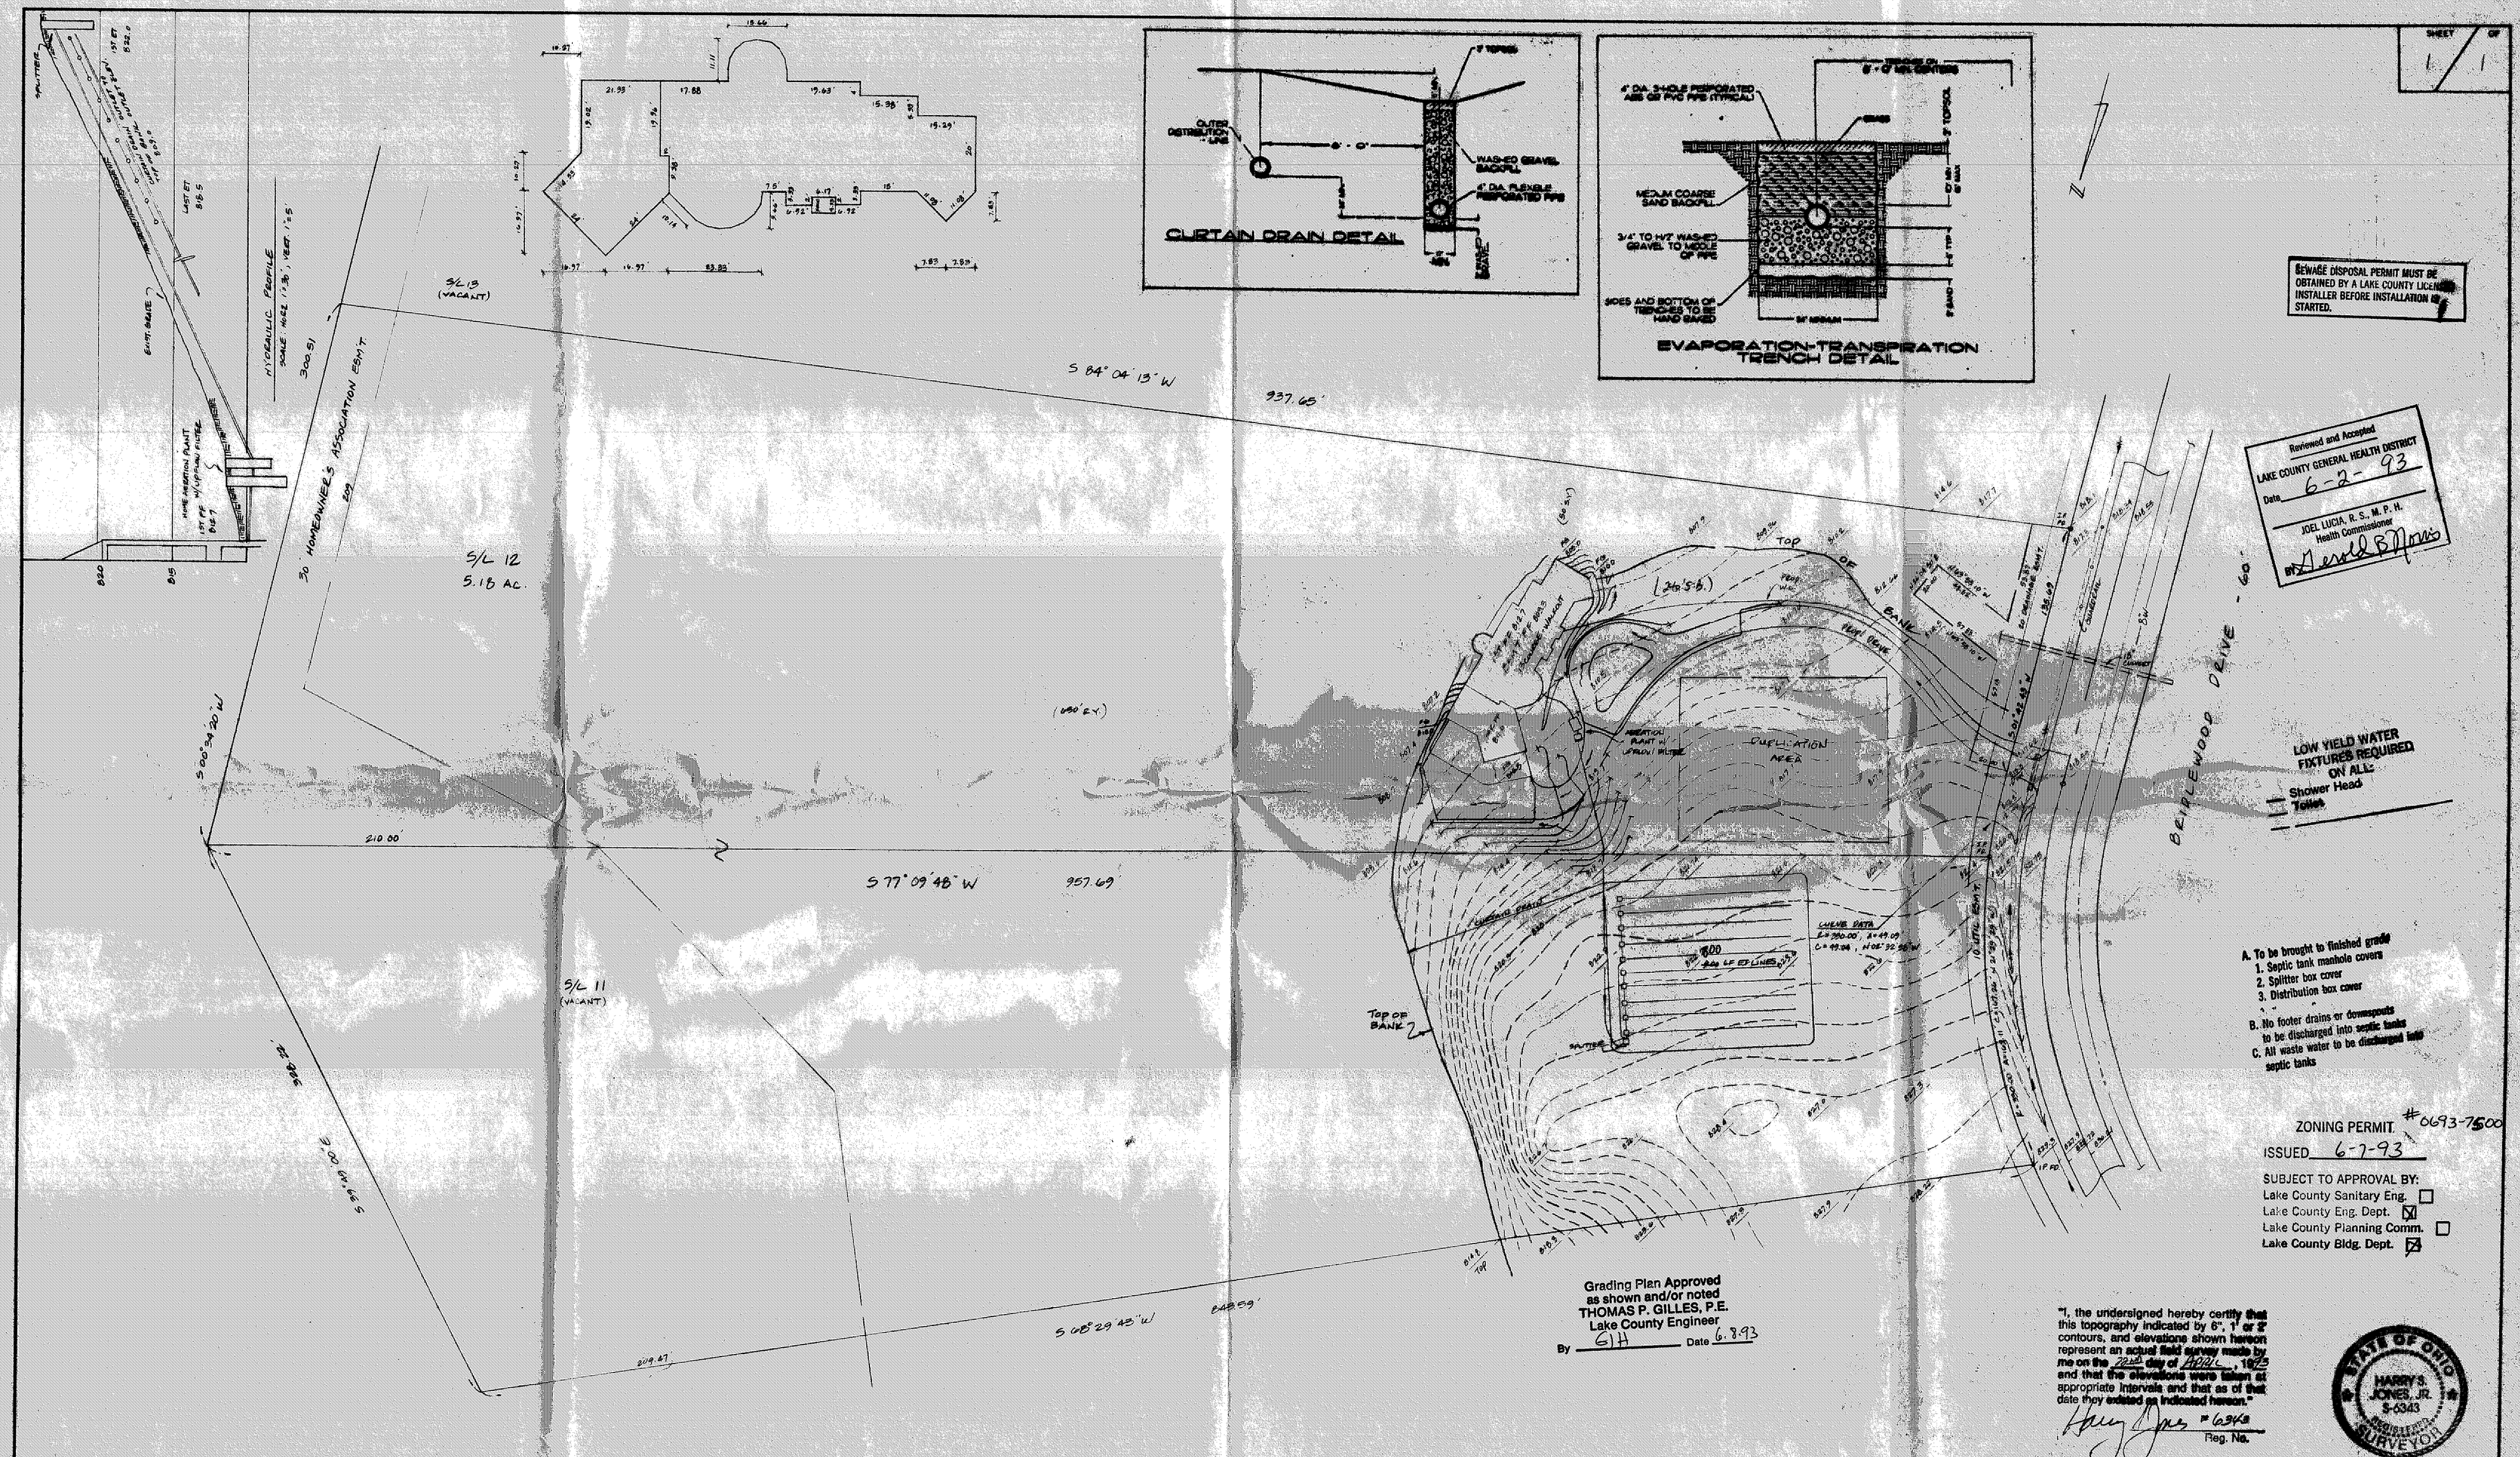


| REV NO. | DESCRIPTION | DATE | BY | CHK'D |
|---|---|---|---|---|
| 1 | HOUSE REVISION. MOVE SEPTIC FIELD TO S/L 11 | 5-3-93 | | |

SITE PLAN
FOR
KERN BUILDING

**BABCOCK, JONES AND ASSOCIATES, INC**
CIVIL ENGINEERS - SURVEYORS - LAND PLANNERS
PAINESVILLE OHIO 44077

| | |
|---|---|
| DATE | 5-5-92 |
| DESIGN BY | |
| DRAWN BY | |
| APPROVED BY | |

S/L 11 & S/L 12 LEFLEWOOD CROSSING AT THE FALLS
VOL. 14 - PG 8
CONCORD TWP., LAKE COUNTY, OHIO

SCALE 1" = 40'
JOB NO. 89-054-12
SHEET 1 OF 1