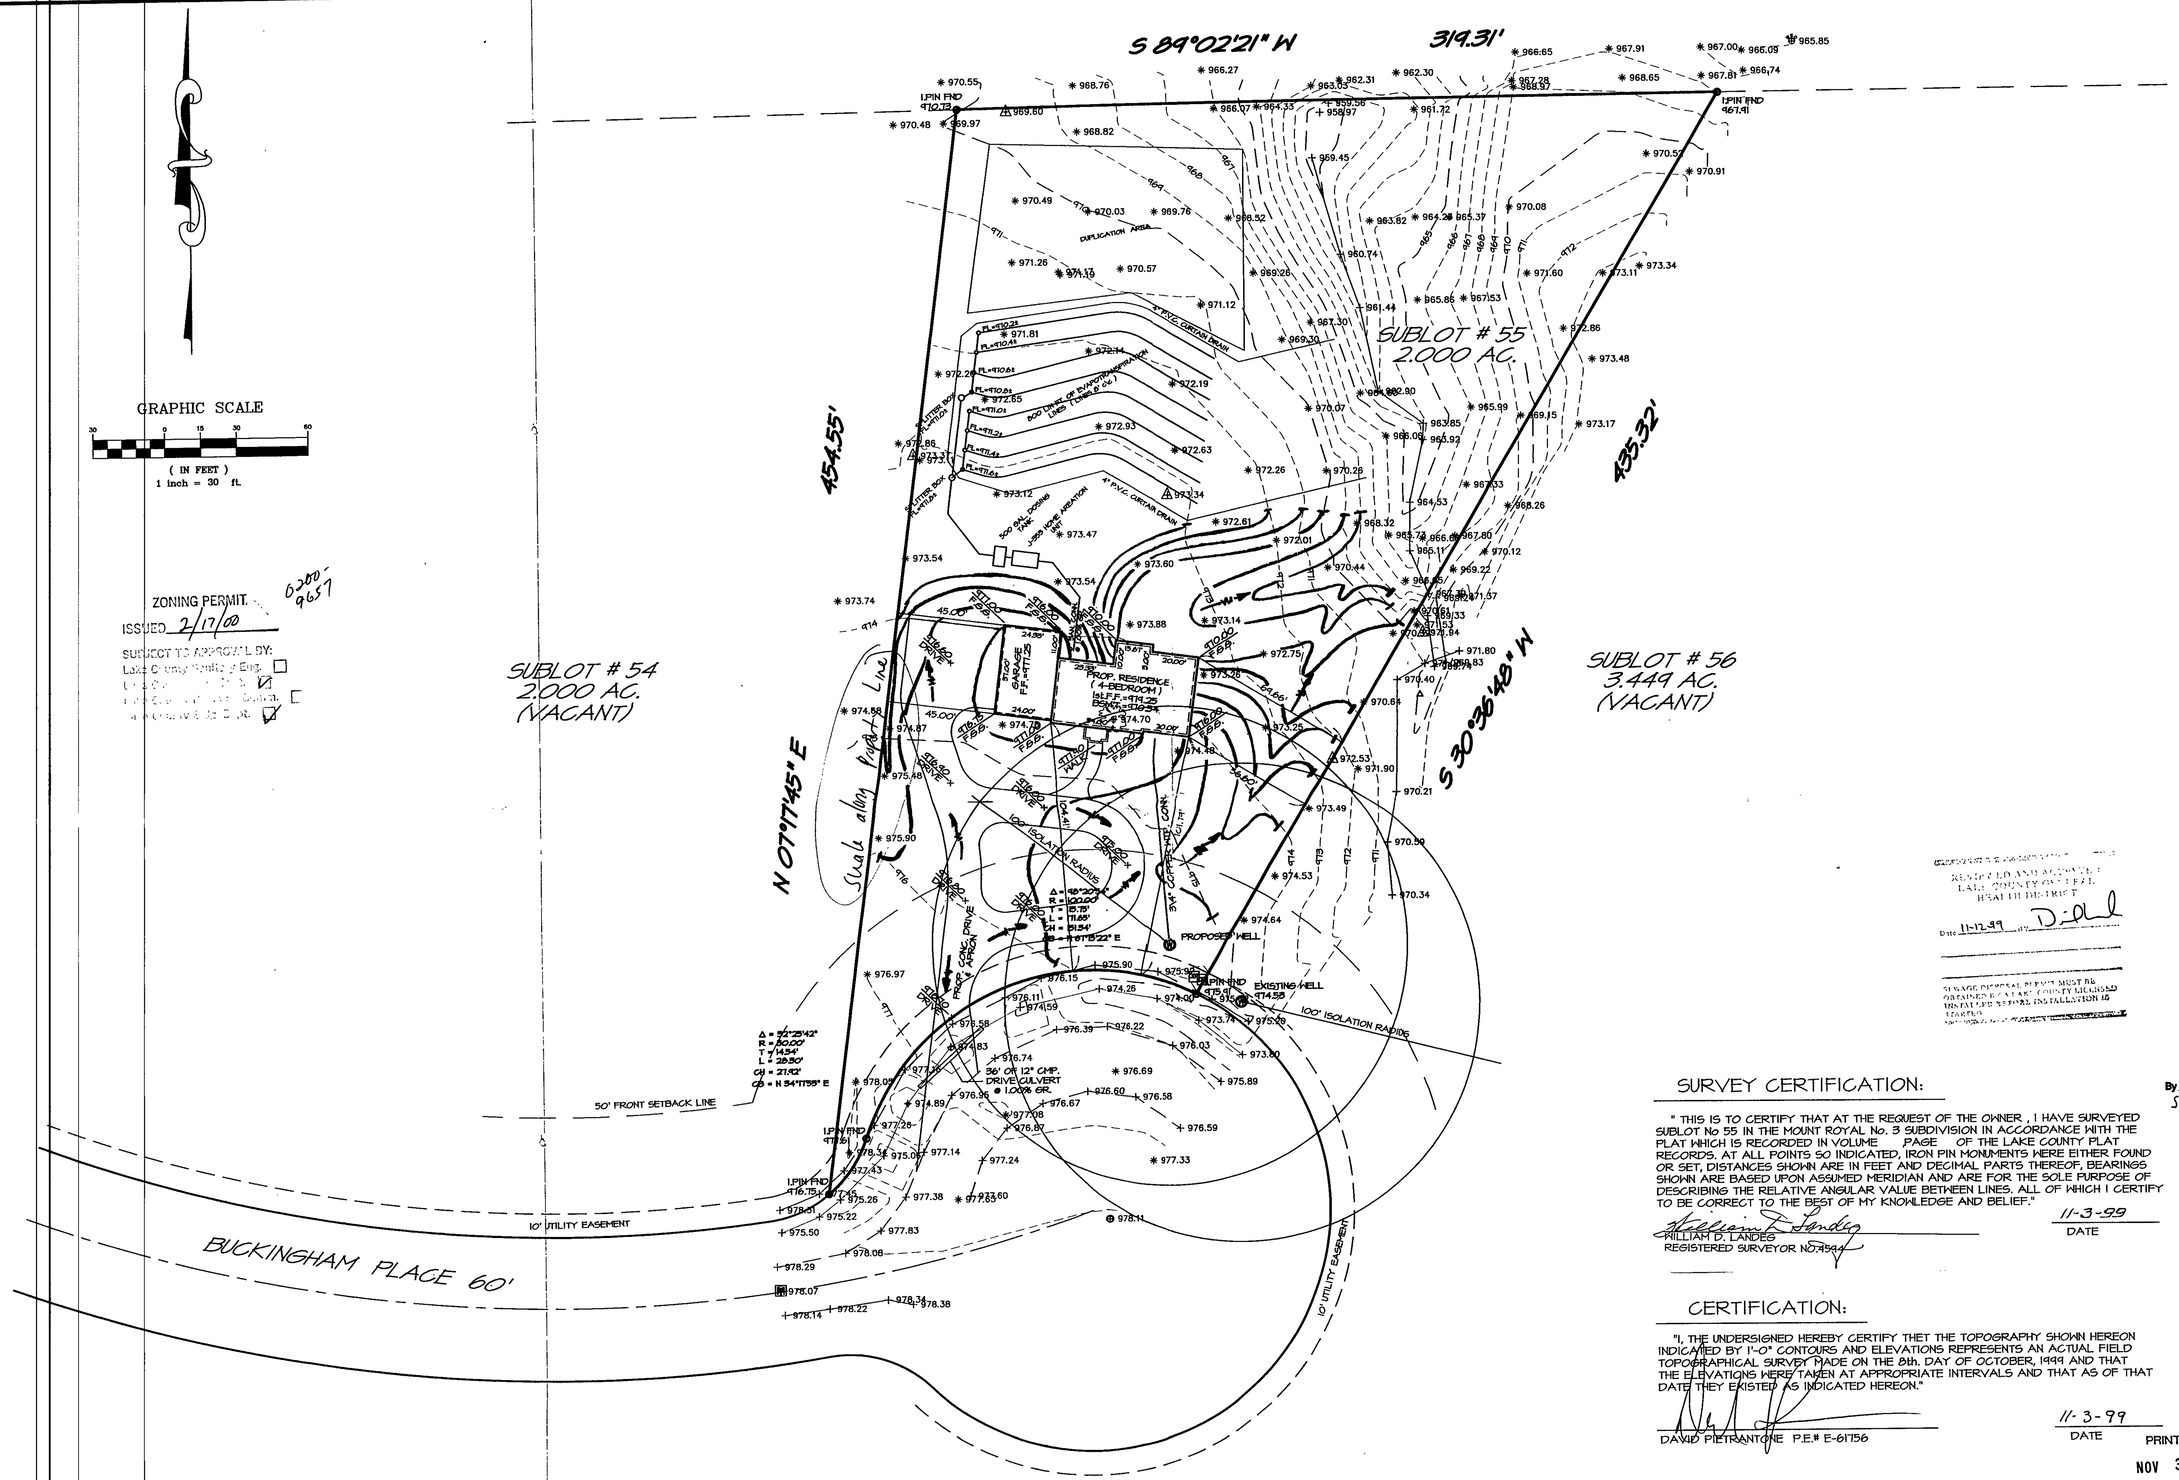

ZONING PERMIT 0200-9657
ISSUED 2/17/00
SUBJECT TO APPROVAL BY:
Lake County Health Dept. ☐
☑
☐
☑

REVIEWED AND APPROVED
LAKE COUNTY GENERAL
HEALTH DISTRICT
Date 11-17-99 By D. Abbott

SEWAGE DISPOSAL REPORT MUST BE
OBTAINED BY LAKE COUNTY LICENSED
INSTALLER BEFORE INSTALLATION IS
STARTED

Grading Plan Approved
as shown and/or noted
THOMAS P. GILLES, P.E.
Lake County Engineer
By GLH Date 2-17-2000
Scale along West property line

SURVEY CERTIFICATION:

" THIS IS TO CERTIFY THAT AT THE REQUEST OF THE OWNER , I HAVE SURVEYED SUBLOT No 55 IN THE MOUNT ROYAL No. 3 SUBDIVISION IN ACCORDANCE WITH THE PLAT WHICH IS RECORDED IN VOLUME PAGE OF THE LAKE COUNTY PLAT RECORDS. AT ALL POINTS SO INDICATED, IRON PIN MONUMENTS WERE EITHER FOUND OR SET, DISTANCES SHOWN ARE IN FEET AND DECIMAL PARTS THEREOF, BEARINGS SHOWN ARE BASED UPON ASSUMED MERIDIAN AND ARE FOR THE SOLE PURPOSE OF DESCRIBING THE RELATIVE ANGULAR VALUE BETWEEN LINES. ALL OF WHICH I CERTIFY TO BE CORRECT TO THE BEST OF MY KNOWLEDGE AND BELIEF."

WILLIAM D. LANDES
REGISTERED SURVEYOR NO. 4594

11-3-99
DATE

STATE OF OHIO
WILLIAM D. LANDES
4594
REGISTERED
SURVEYOR

CERTIFICATION:

"I, THE UNDERSIGNED HEREBY CERTIFY THET THE TOPOGRAPHY SHOWN HEREON INDICATED BY 1'-0" CONTOURS AND ELEVATIONS REPRESENTS AN ACTUAL FIELD TOPOGRAPHICAL SURVEY MADE ON THE 8th. DAY OF OCTOBER, 1999 AND THAT THE ELEVATIONS WERE TAKEN AT APPROPRIATE INTERVALS AND THAT AS OF THAT DATE THEY EXISTED AS INDICATED HEREON."

DAVID PIETRANTONE P.E.# E-61756

11-3-99
DATE

STATE OF OHIO
DAVID A. PIETRANTONE
E-61756
REGISTERED
PROFESSIONAL ENGINEER

PRINTED
NOV 3 1999
LAKE INC.

LAKE, INC.
ENGINEERS & SURVEYORS
30601 EUCLID AVENUE WICKLIFFE, OHIO 44092
PHONE: (440) 585-2100 FAX: (440) 585-5122

Rev. No.	Description	Date	By	CH'K'D.

SITE PLAN for
SIGNATURE HOMES Inc.
MOUNT ROYAL No.3

Drawn By:	D. Abbott
Filename:	99-109\99-109 dwg.
Checked By:	
Approved By:	
Date:	OCT.13,1999

SUBLOT No. 55
THE FOX RESIDENCE
CONCORD TOWNSHIP, LAKE COUNTY

Scale:
1"= 30'
1"= 5'

Sheet No.	Of
1	2

#99-109