

| REVISIONS | BY |
|-----------|----|
| | |
| | |
| | |
| | |
| | |
| | |
| | |
| | |
| | |
| | |

Barrington
CONSULTING GROUP, INC.
9114 TYLER BLVD., MENTOR, OHIO 44060
PHONE 440.285.1760 FAX 440.285.1762
www.BarringtonCGI.com



SITE PLAN
7990 BUTTERFLY ST., CONCORD TWP., OHIO 44077
NATURE PRESERVE NORTH PH. 1 VOL. 48 PG. 26
KNEZ CONSTRUCTION, INC.

DATE
CHECKED
DWN
DATE
JULY 02, 2009
SCALE
1" = 30'
JOB NO.
09049-050
SHEET
1/2
OF SHEETS

GENERAL NOTES:

1. BENCHMARK - TOP STEM OF EXISTING FIRE HYDRANT LOCATED AS SHOWN IN SITE PLAN, ELEVATION = 971.05.
2. DRIVEWAY APRON TO BE 6" THICK CONCRETE.
3. ALL DOWNSPOUTS TO BE OUTLETTED TO SPLASH BLOCKS.
4. CONTRACTOR RESPONSIBLE FOR CONTACTING THE OHIO UTILITY PROTECTION SERVICE (1.800.362.2764) AND ALL UTILITY COMPANIES A MINIMUM OF 48 HOURS PRIOR TO CONSTRUCTION.
5. THE LOCATION BOTH HORIZONTAL AND VERTICAL OF EXISTING UNDERGROUND UTILITIES SHOWN HEREON, HAVE BEEN OBTAINED BY A DILIGENT AND COMPREHENSIVE SEARCH OF AVAILABLE RECORDS. VERIFICATION BY FIELD OBSERVATION HAS BEEN CONDUCTED WHERE PRACTICAL, HOWEVER, BARRINGTON CONSULTING GROUP, INC. DOES NOT GUARANTEE THE COMPLETENESS, NOR ACCURACY THEREOF.
6. CONTRACTOR SHALL VERIFY ELEVATIONS OF LATERAL INVERTS IN THE FIELD PRIOR TO FOUNDATION EXCAVATION.
7. SEE SHEET 2 FOR EROSION AND SEDIMENT-CONTROL PLAN
8. SEE SHEET 2 FOR SEEDING INFORMATION


CERTIFICATION :

"I THE UNDERSIGNED HEREBY CERTIFIES THAT THIS TOPOGRAPHY INDICATED BY 1 FOOT CONTOURS AND ELEVATION SHOWN HEREON REPRESENTS AN ACTUAL SURVEY MADE BY ME ON THE 1st DAY OF JULY, 2009 AND THE ELEVATIONS WERE TAKEN AT AN APPROPRIATE INTERVAL AND AS OF THAT DAY THEY EXISTED AS INDICATED HEREON.


"I HEREBY CERTIFY THAT THIS PLAN WAS PREPARED BY ME AND IS CORRECT TO THE BEST OF MY KNOWLEDGE AND BELIEF"

David W. Novak
DAVID W. NOVAK, P.S. No. 7507

CONCORD TOWNSHIP ZONING OFFICE
Zoning Permit # 0709-USE FF ELEV.
Issued 7/15/09
Subject to Approval By:
 Lake Co. Engineer/Storm Water Mgmt.
 Lake Co. Utilities Dept.
 Lake Co. Soil + Water District
 Lake Co. Health District
 Lake Co. Building Dept.
BARRINGTON CONSULTING GROUP, INC.
7990 BUTTERFLY ST., CONCORD TWP., OHIO 44077
NATURE PRESERVE NORTH PH. 1 VOL. 48 PG. 26

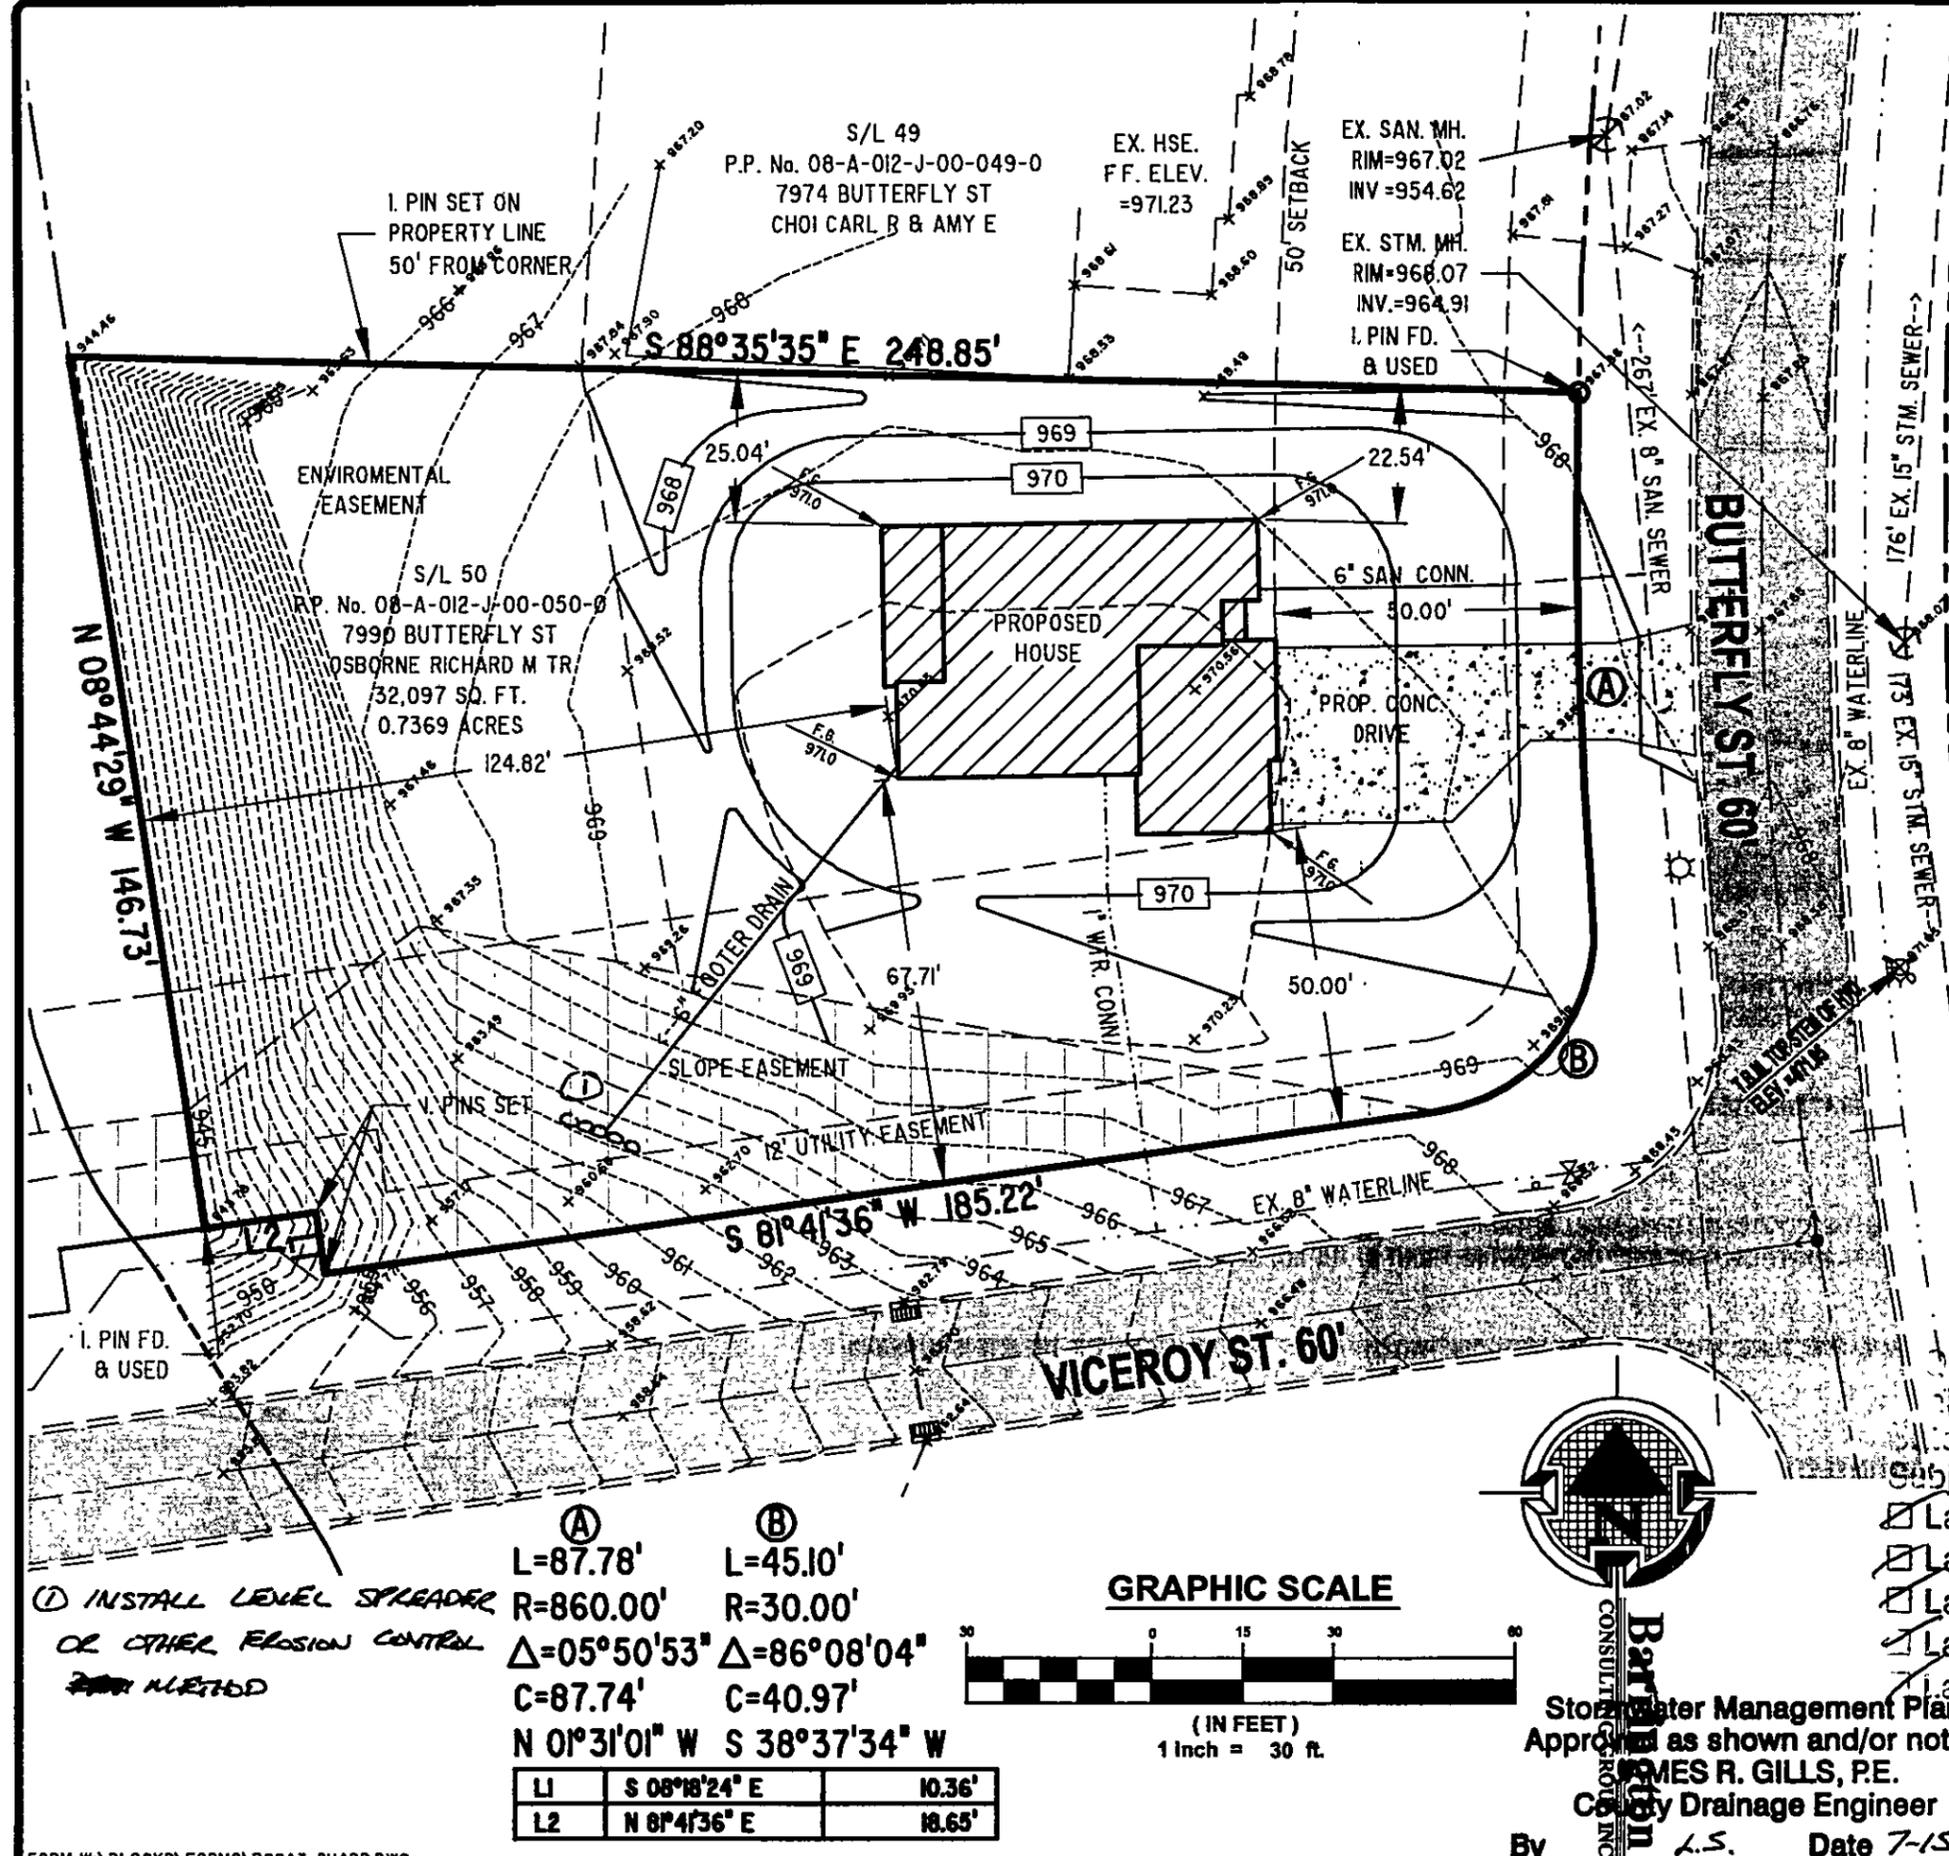

| | | | | | | | |
|--|---|--------|---------------|--------|----|---------------|--------|
| ① INSTALL LEVEL SPREADER OR OTHER EROSION CONTROL METHOD | ① L=87.78' R=860.00' Δ=05°50'53" C=87.74' N 01°31'01" W ② L=45.10' R=30.00' Δ=86°08'04" C=40.97' S 38°37'34" W | | | | | | |
| | <table border="1"> <tr> <td>L1</td> <td>S 08°18'24" E</td> <td>10.36'</td> </tr> <tr> <td>L2</td> <td>N 81°41'36" E</td> <td>18.65'</td> </tr> </table> | L1 | S 08°18'24" E | 10.36' | L2 | N 81°41'36" E | 18.65' |
| L1 | S 08°18'24" E | 10.36' | | | | | |
| L2 | N 81°41'36" E | 18.65' | | | | | |

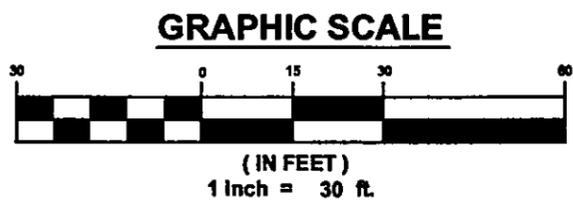

Barrington
CONSULTING GROUP, INC.
Storm Water Management Plan
Approved as shown and/or noted
JAMES R. GILLS, P.E.
County Drainage Engineer
By *L.S.* Date 7-15-09

W:\2009\09-04\01\09049-050.dwg, 7/15/2009 7:48:08 AM, Copyright Barrington Consulting Group