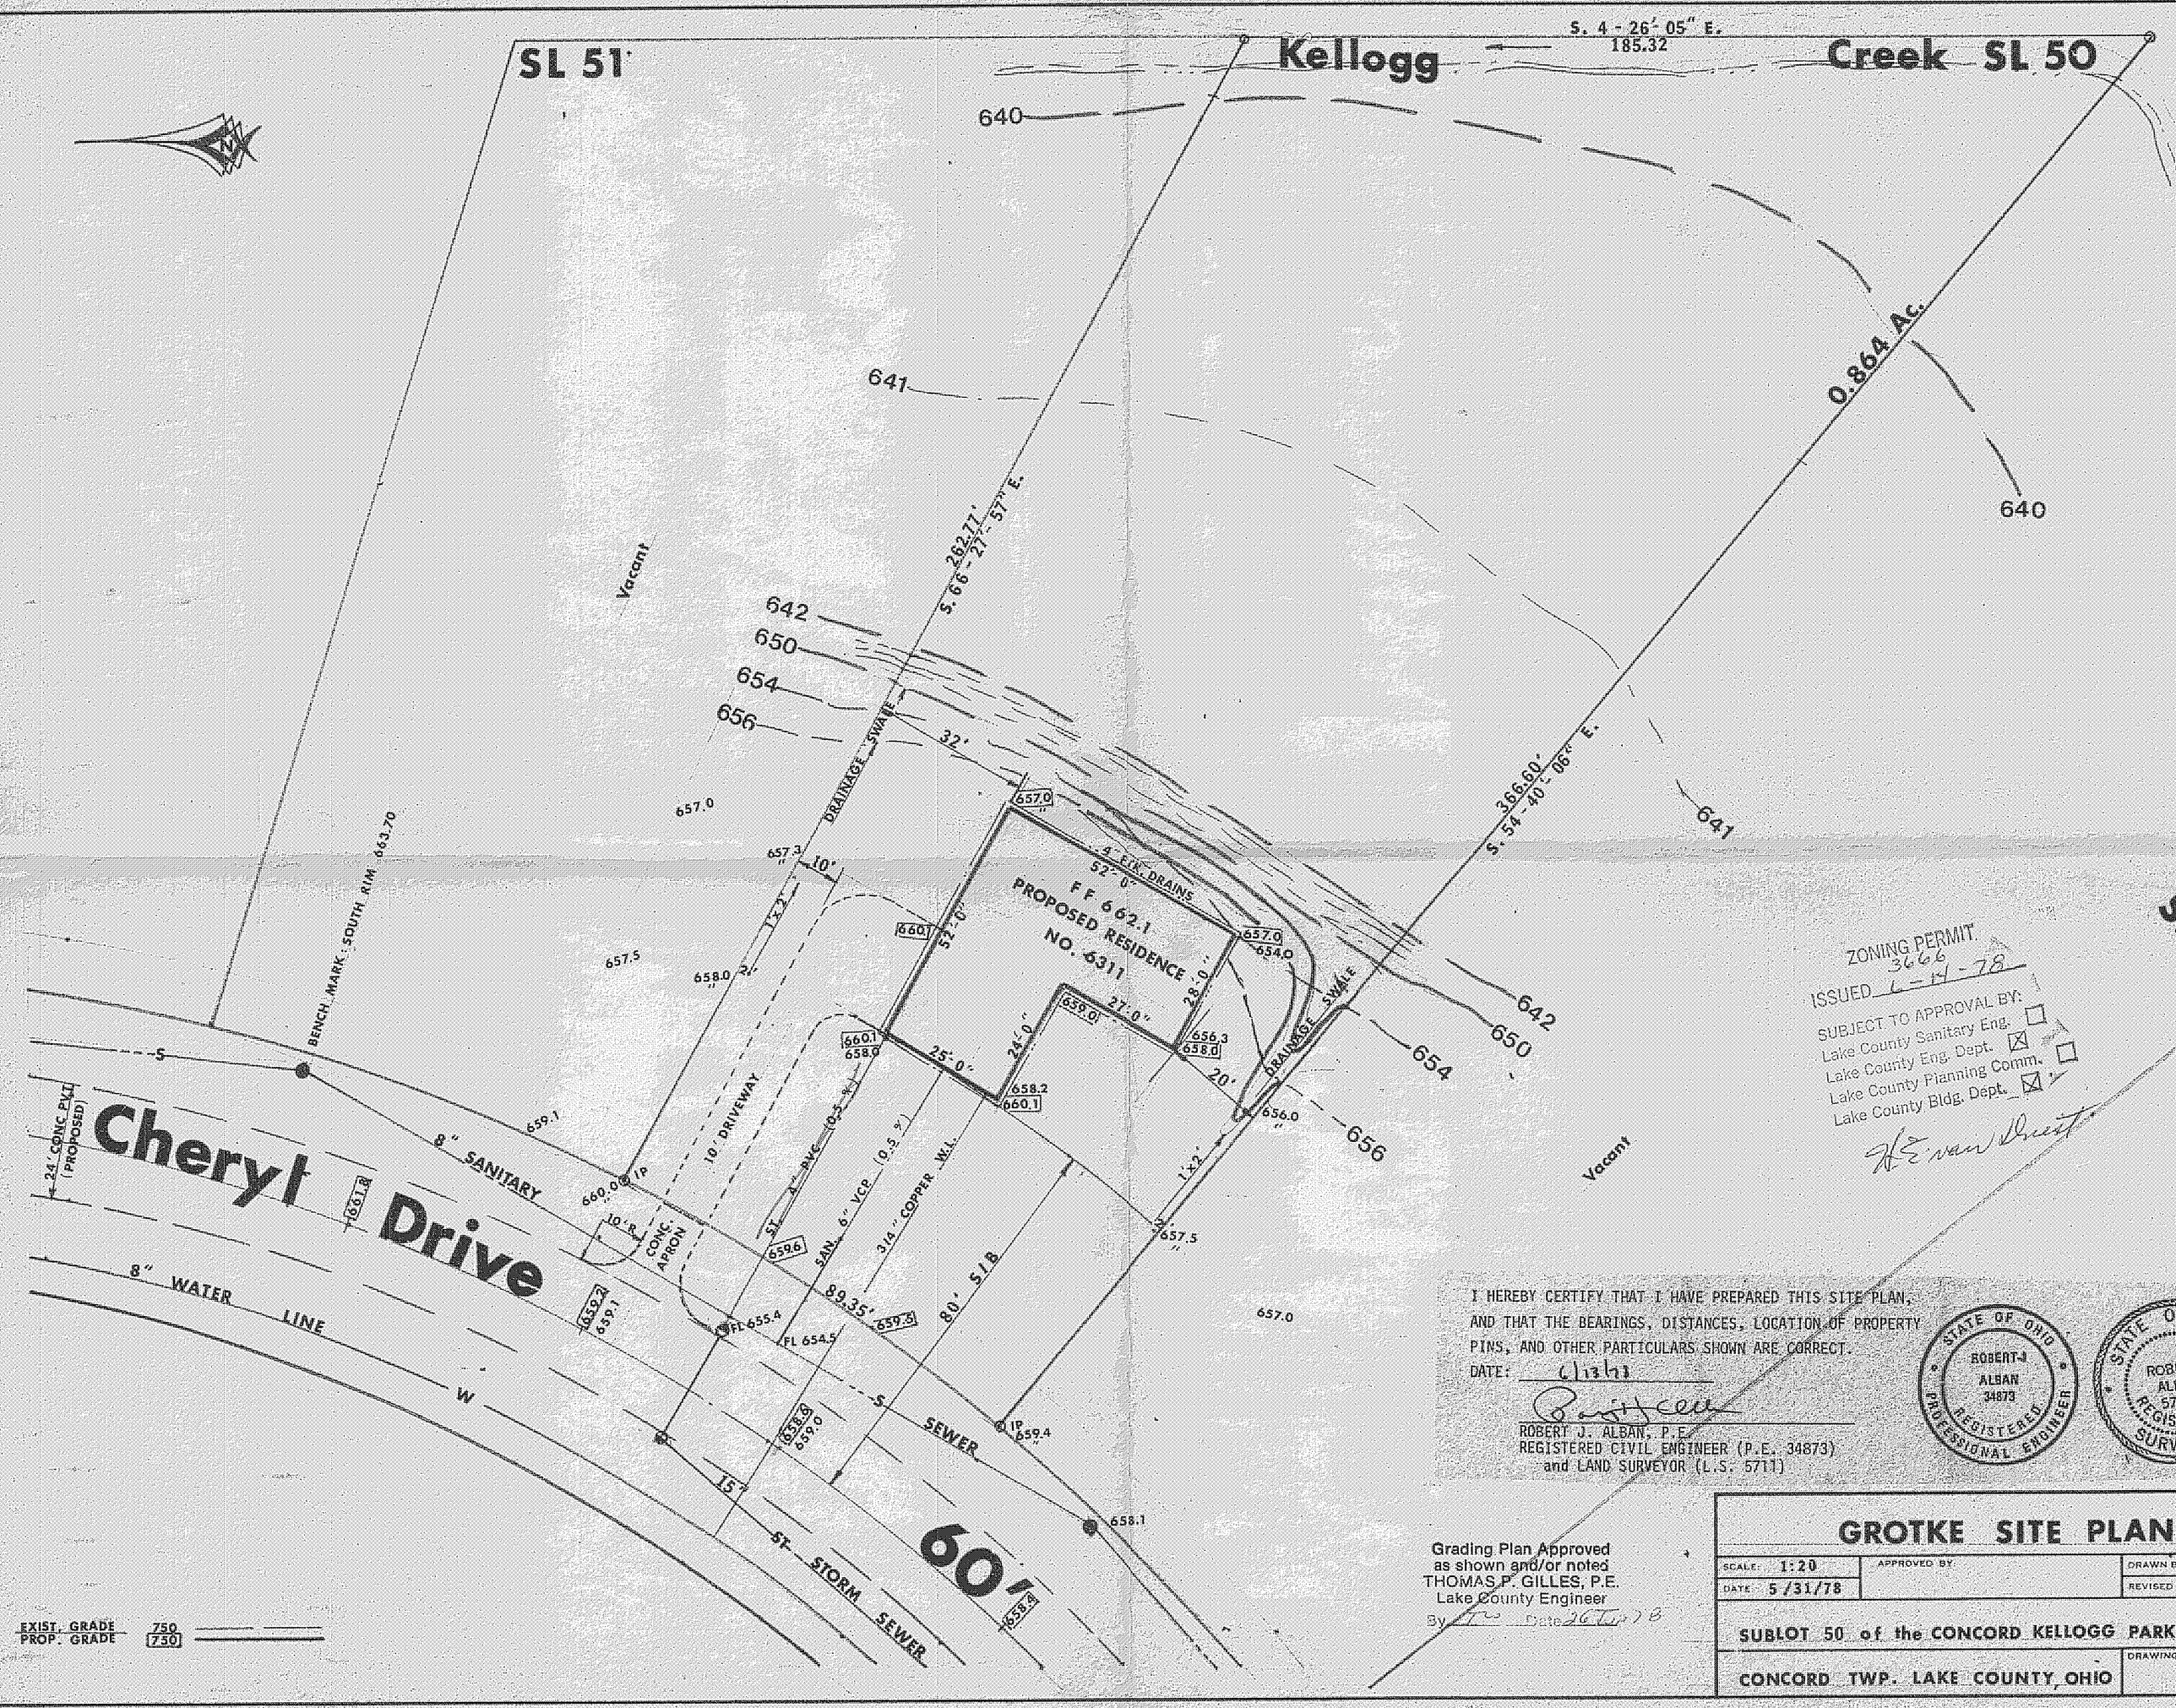

ZONING PERMIT
3666
ISSUED 6-14-78
SUBJECT TO APPROVAL BY:
Lake County Sanitary Eng. ☐
Lake County Eng. Dept. ☒
Lake County Planning Comm. ☐
Lake County Bldg. Dept. ☒
H. E. van Driest

I HEREBY CERTIFY THAT I HAVE PREPARED THIS SITE PLAN, AND THAT THE BEARINGS, DISTANCES, LOCATION OF PROPERTY PINS, AND OTHER PARTICULARS SHOWN ARE CORRECT.
DATE: 6/13/78

ROBERT J. ALBAN, P.E.
REGISTERED CIVIL ENGINEER (P.E. 34873)
and LAND SURVEYOR (L.S. 5711)

STATE OF OHIO
ROBERT J. ALBAN
34873
REGISTERED
PROFESSIONAL ENGINEER

Grading Plan Approved
as shown and/or noted
THOMAS P. GILLES, P.E.
Lake County Engineer
By [illegible] Date 26 Jun 78

GROTKE SITE PLAN

SCALE: 1:20	APPROVED BY:	DRAWN B
DATE: 5/31/78		REVISED

SUBLOT 50 of the CONCORD KELLOGG PARK

CONCORD TWP. LAKE COUNTY, OHIO

DRAWING

OCE INDUSTRIES INC. #2319 ELLCO VEL T/P