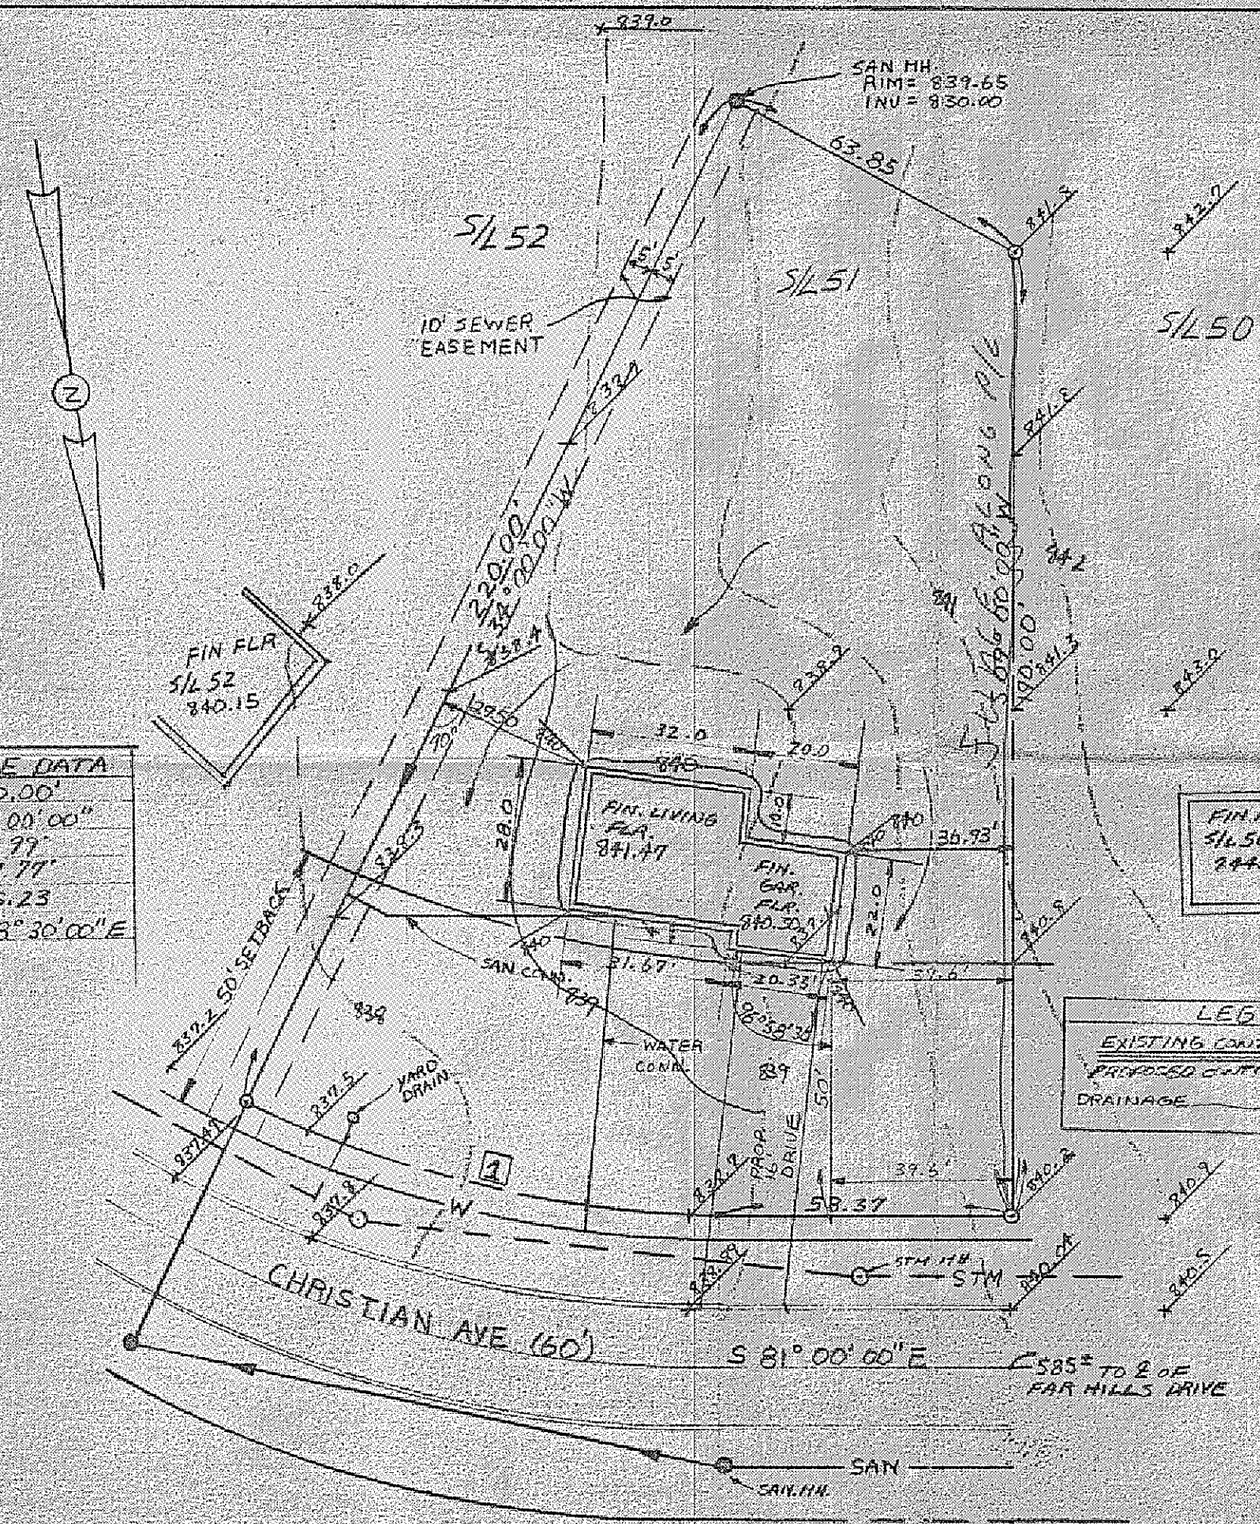

CURVE DATA	
R	220.00'
Δ	25° 00' 00"
A	95.99'
T	48.77'
C	95.23
CB	S 68° 30' 00" E

LEGEND	
EXISTING CONTOUR	850
PROPOSED CONTOUR	850
DRAINAGE	

SITE PLAN FOR:

RYAN HOMES
8141 TYLER BLVD.
MENTOR, OHIO

BEING SUBLOT NO. 51 IN THE FAR HILLS SUBD. IN CONCORD, OHIO.

Grading Plan Approved as shown and/or noted
THOMAS P. GILLES, P. E.
Lake County Engineer
By [signature] Date 12 APR 78

PREPARED BY:

WM. R. GRAY ASSOC. INC.
7547 MENTOR AVE.
MENTOR, OHIO

SCALE: 1" = 30'
DATE: 4-3-78

CERTIFICATION:

I HEREBY CERTIFY THAT THIS PLAT IS CORRECT TO THE BEST OF MY KNOWLEDGE.

By [signature]
WM. R. GRAY REG. SURV. 2752

#3573
ZONING PERMIT
ISSUED 4-11-78

STATE OF OHIO
WM. R. GRAY
2752
REGISTERED PROFESSIONAL SURVEYOR

SUBJECT TO APPROVAL BY:
Lake County Sanitary Eng. ☐
Lake County Eng. Dept. ☑
County Planning Comm. ☐
County Bldg. Dept. ☑

[signature]

F.B. 84-34
DATE 3-29-78