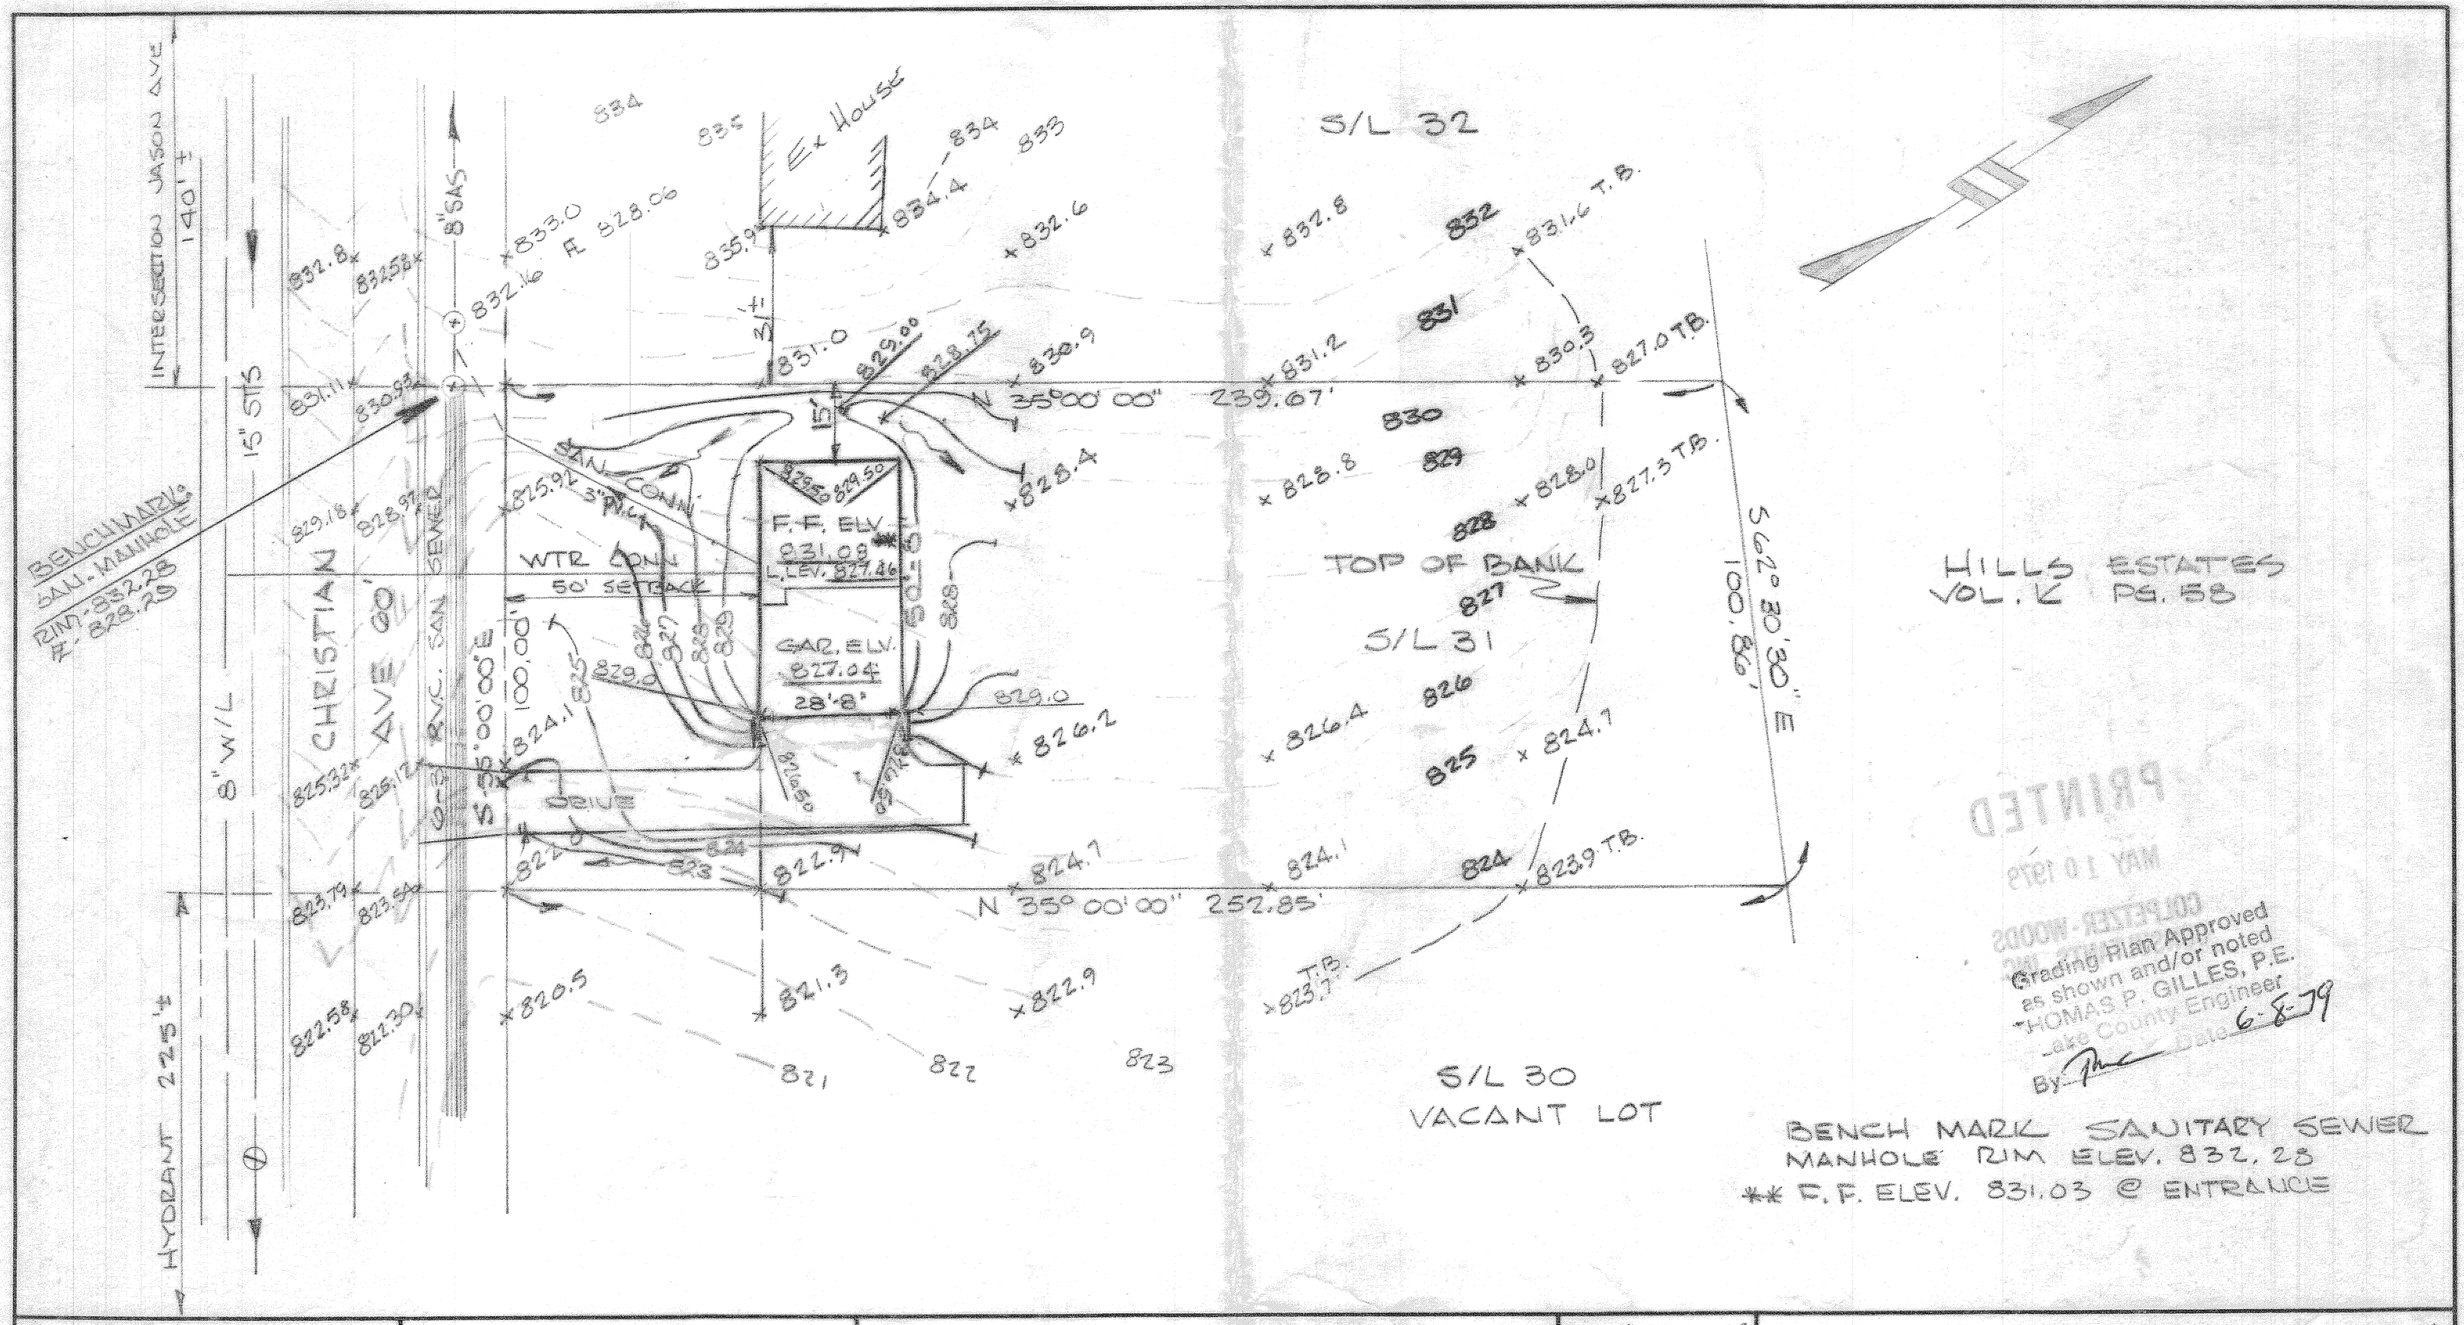

Grading Plan Approved
as shown and/or noted
THOMAS P. GILLES, P.E.
Lake County Engineer
By _____ Date 6-8-79

BENCH MARK SANITARY SEWER
MANHOLE RIM ELEV. 832.28
** F.F. ELEV. 831.03 @ ENTRANCE

DESIGN CERTIFICATION

THIS PLAT WAS PREPARED BY ME, AND IS CORRECT TO THE BEST OF MY KNOWLEDGE AND BELIEF.

Elliot Feline

REG. SURVEYOR NO. 4785

AS BUILT CERTIFICATION

I HEREBY CERTIFY THAT THE CIRCLED GRADES ARE EXISTING FINISH GRADES CHECKED IN THE FIELD ON _____ AND THAT SURVEY IS CORRECT TO THE BEST OF MY KNOWLEDGE AND BELIEF.

REG. SURVEYOR NO. _____

COLPETZER · WOODS
CONSULTANTS, INC.
[illegible] STATE STREET · PAINESVILLE, OHIO [illegible]

DATE 9 MAY 79
SCALE 1"=30'
DRWN BY [illegible]
CHKD BY _____
JOB NO. 79-096
FB 360 PG 146

SITE PLAN FOR CIANFAGLIONE BLD'S
FOR S/L 31
FAR HILLS ESTATES No 2
CONCORD TWP., LAKE CO., OHIO