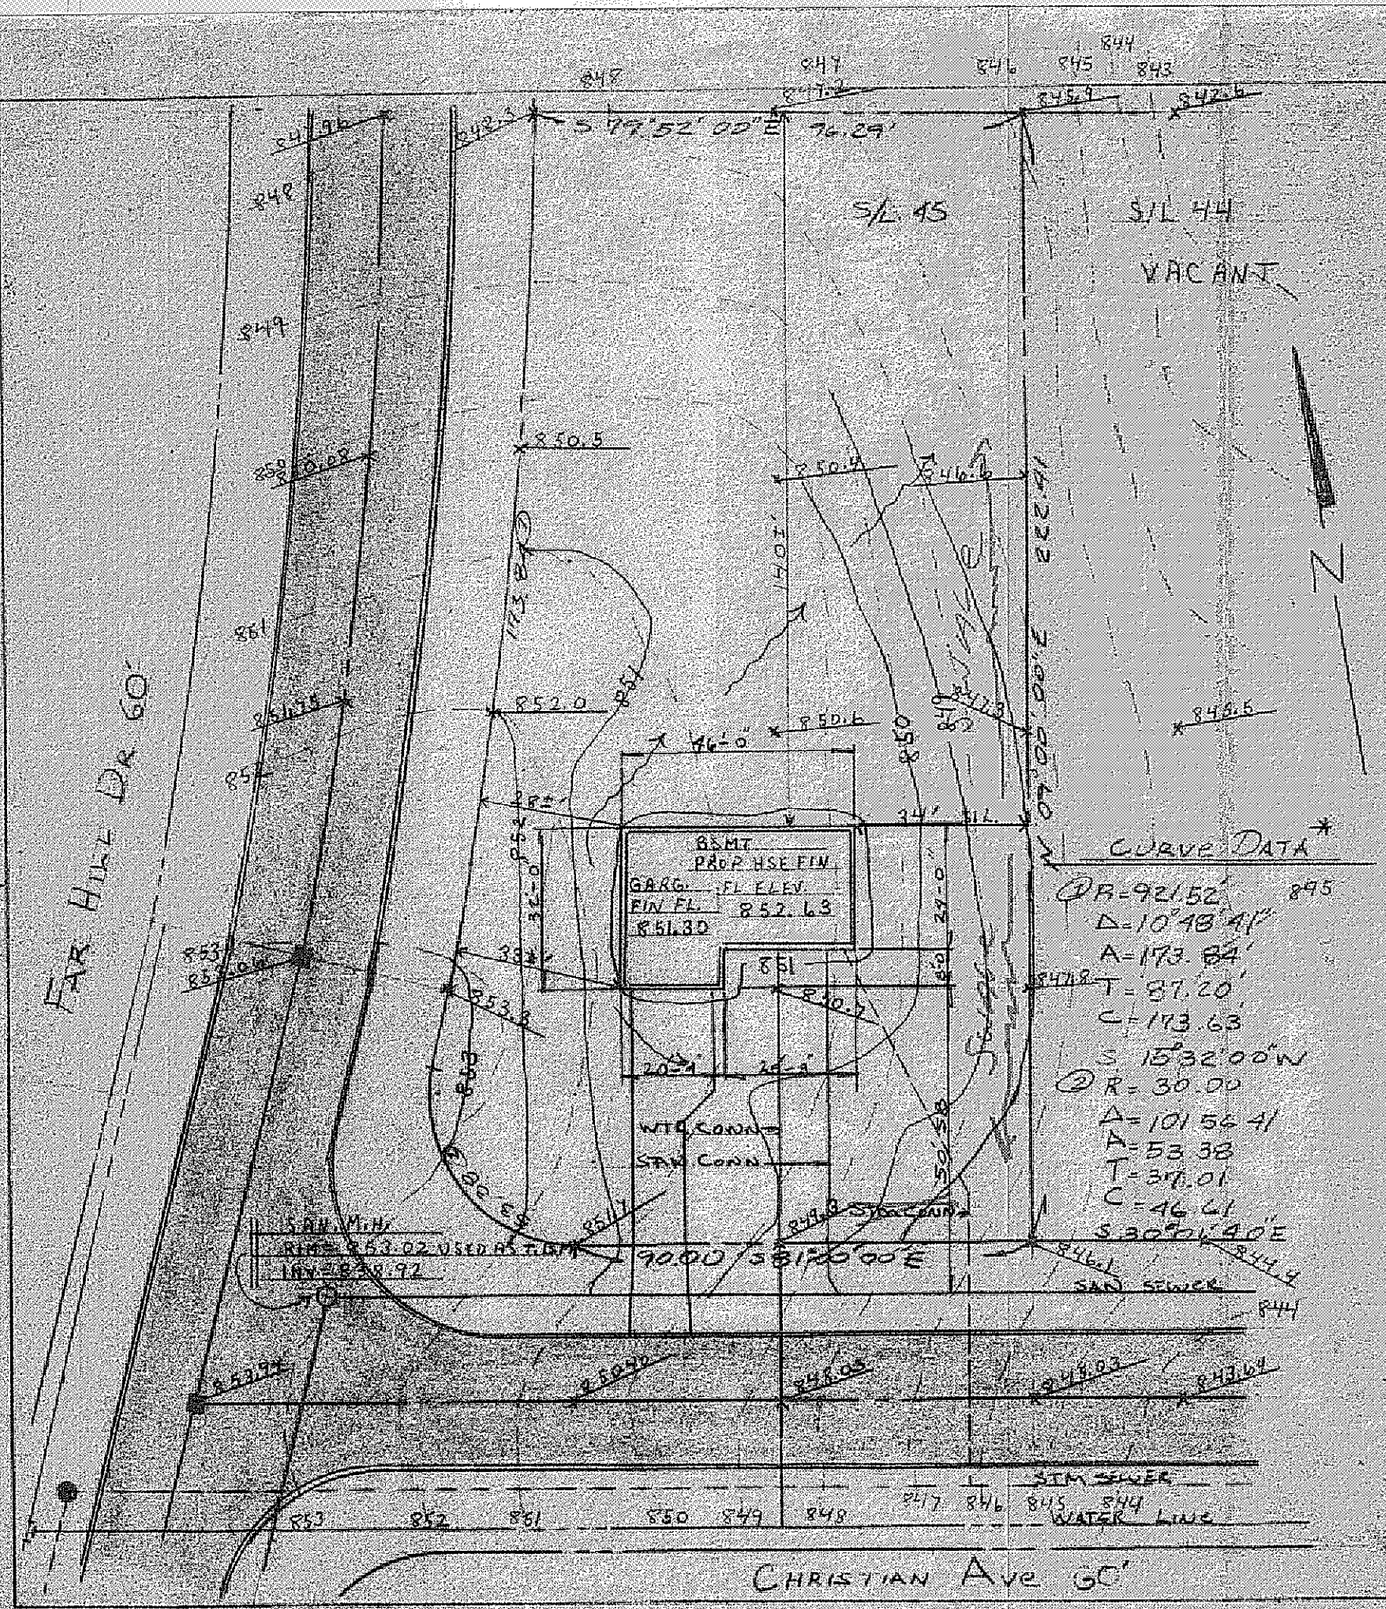

SITE PLAN

RYAN HOMES
8141 TYLER BLVD
MENTOR, OHIO

BEING SUBLOT NUMBER 45
IN THE FAR HILLS ESTATES
NO 2 SUBDIVISION IN CONCORD
TOWNSHIP LAKE COUNTY OHIO

PREPARED BY:

WM. R. GRAY ASSOC INC
7547 MENTOR AVE
MENTOR, OHIO

SCALE : 1" = 30'

DATE: SEPT 7, 1977

CERTIFICATION

I HEREBY CERTIFY THAT
THIS PLAT IS CORRECT TO
THE BEST OF MY KNOWLEDGE
BY Wm R Gray
WM. R. GRAY REG. SURV. #2752

Grading Plan Approved
as shown and/or noted
THOMAS P. GILLES, P.E.
Lake County Engr.
Date 14 Sept 77
No STM. Connection

STATE OF OHIO
WM. R. GRAY
2752
REGISTERED
PROFESSIONAL SURVEYOR

ZONING PERMIT

#3424

Approved 9-12-77