Grading Plan Approved
as shown and/or noted
THOMAS P. GILLES, P.E.
Lake County Engineer
By [illegible] Date 30 MAY 78

SITE PLAN FOR:

RYAN HOMES
8141 TYLER BLVD.
MENTOR, OHIO

BEING SUBLOT No. 22 IN THE
FOX HILL SUBDIVISION IN CONCORD
TOWNSHIP, OHIO

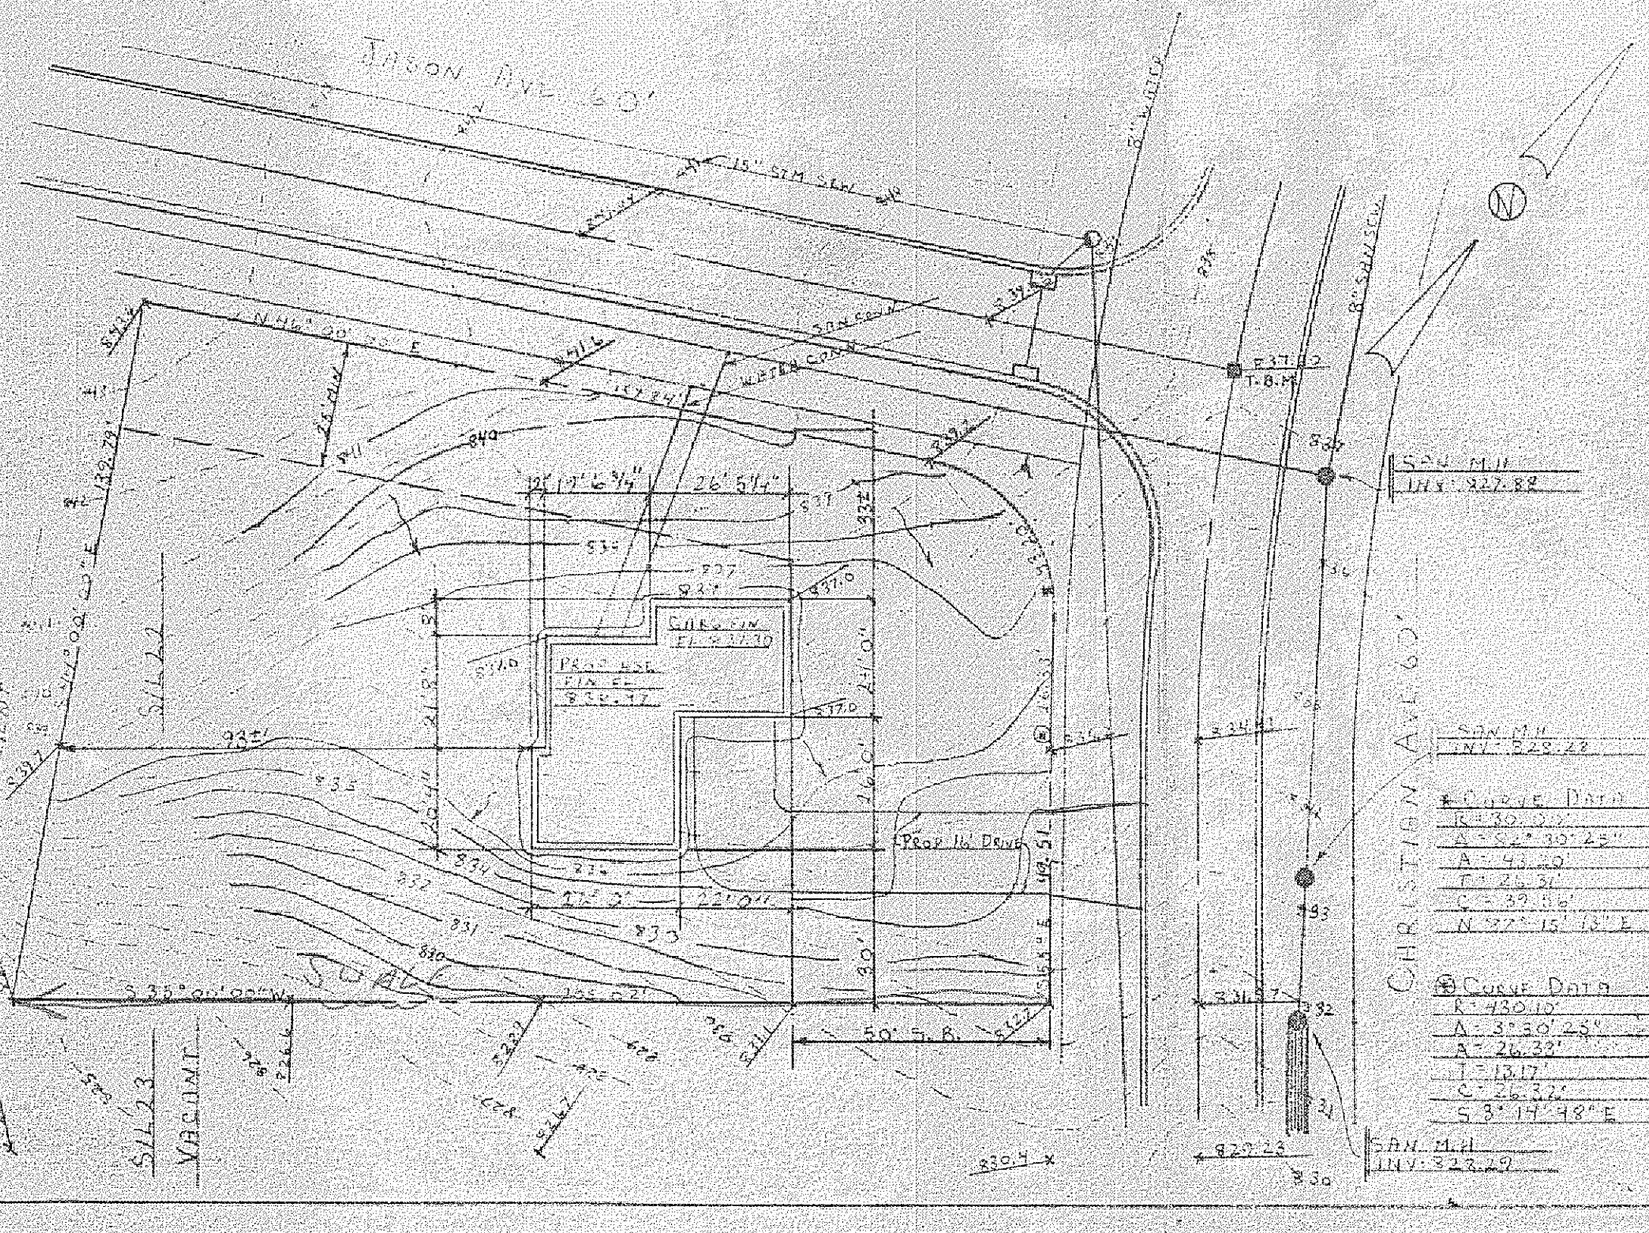

* CURVE DATA
R = 30.00'
Δ = 52° 30' 25"
A = 41.10'
T = 22.21'
C = 39.66'
N 22° 15' 13" E

⊕ CURVE DATA
R = 430.10'
Δ = 3° 30' 25"
A = 26.32'
T = 13.17'
C = 26.32'
S 8° 14' 48" E

PREPARED BY:

WM. R. GRAY ASSOC. INC.
7537 MENTOR AVE.
MENTOR, OHIO
SCALE: 1" = 30'
DATE: MAY 10, 1978

CERTIFICATION:

I HEREBY CERTIFY THAT THIS
PLAT IS CORRECT TO THE BEST
OF MY KNOWLEDGE
BY: Wm. R. Gray

WM. R. GRAY REG. SURV. #2752

STATE OF OHIO
WM. R. GRAY
2752
REGISTERED PROFESSIONAL SURVEYOR

COVINGTON "L" 79-50