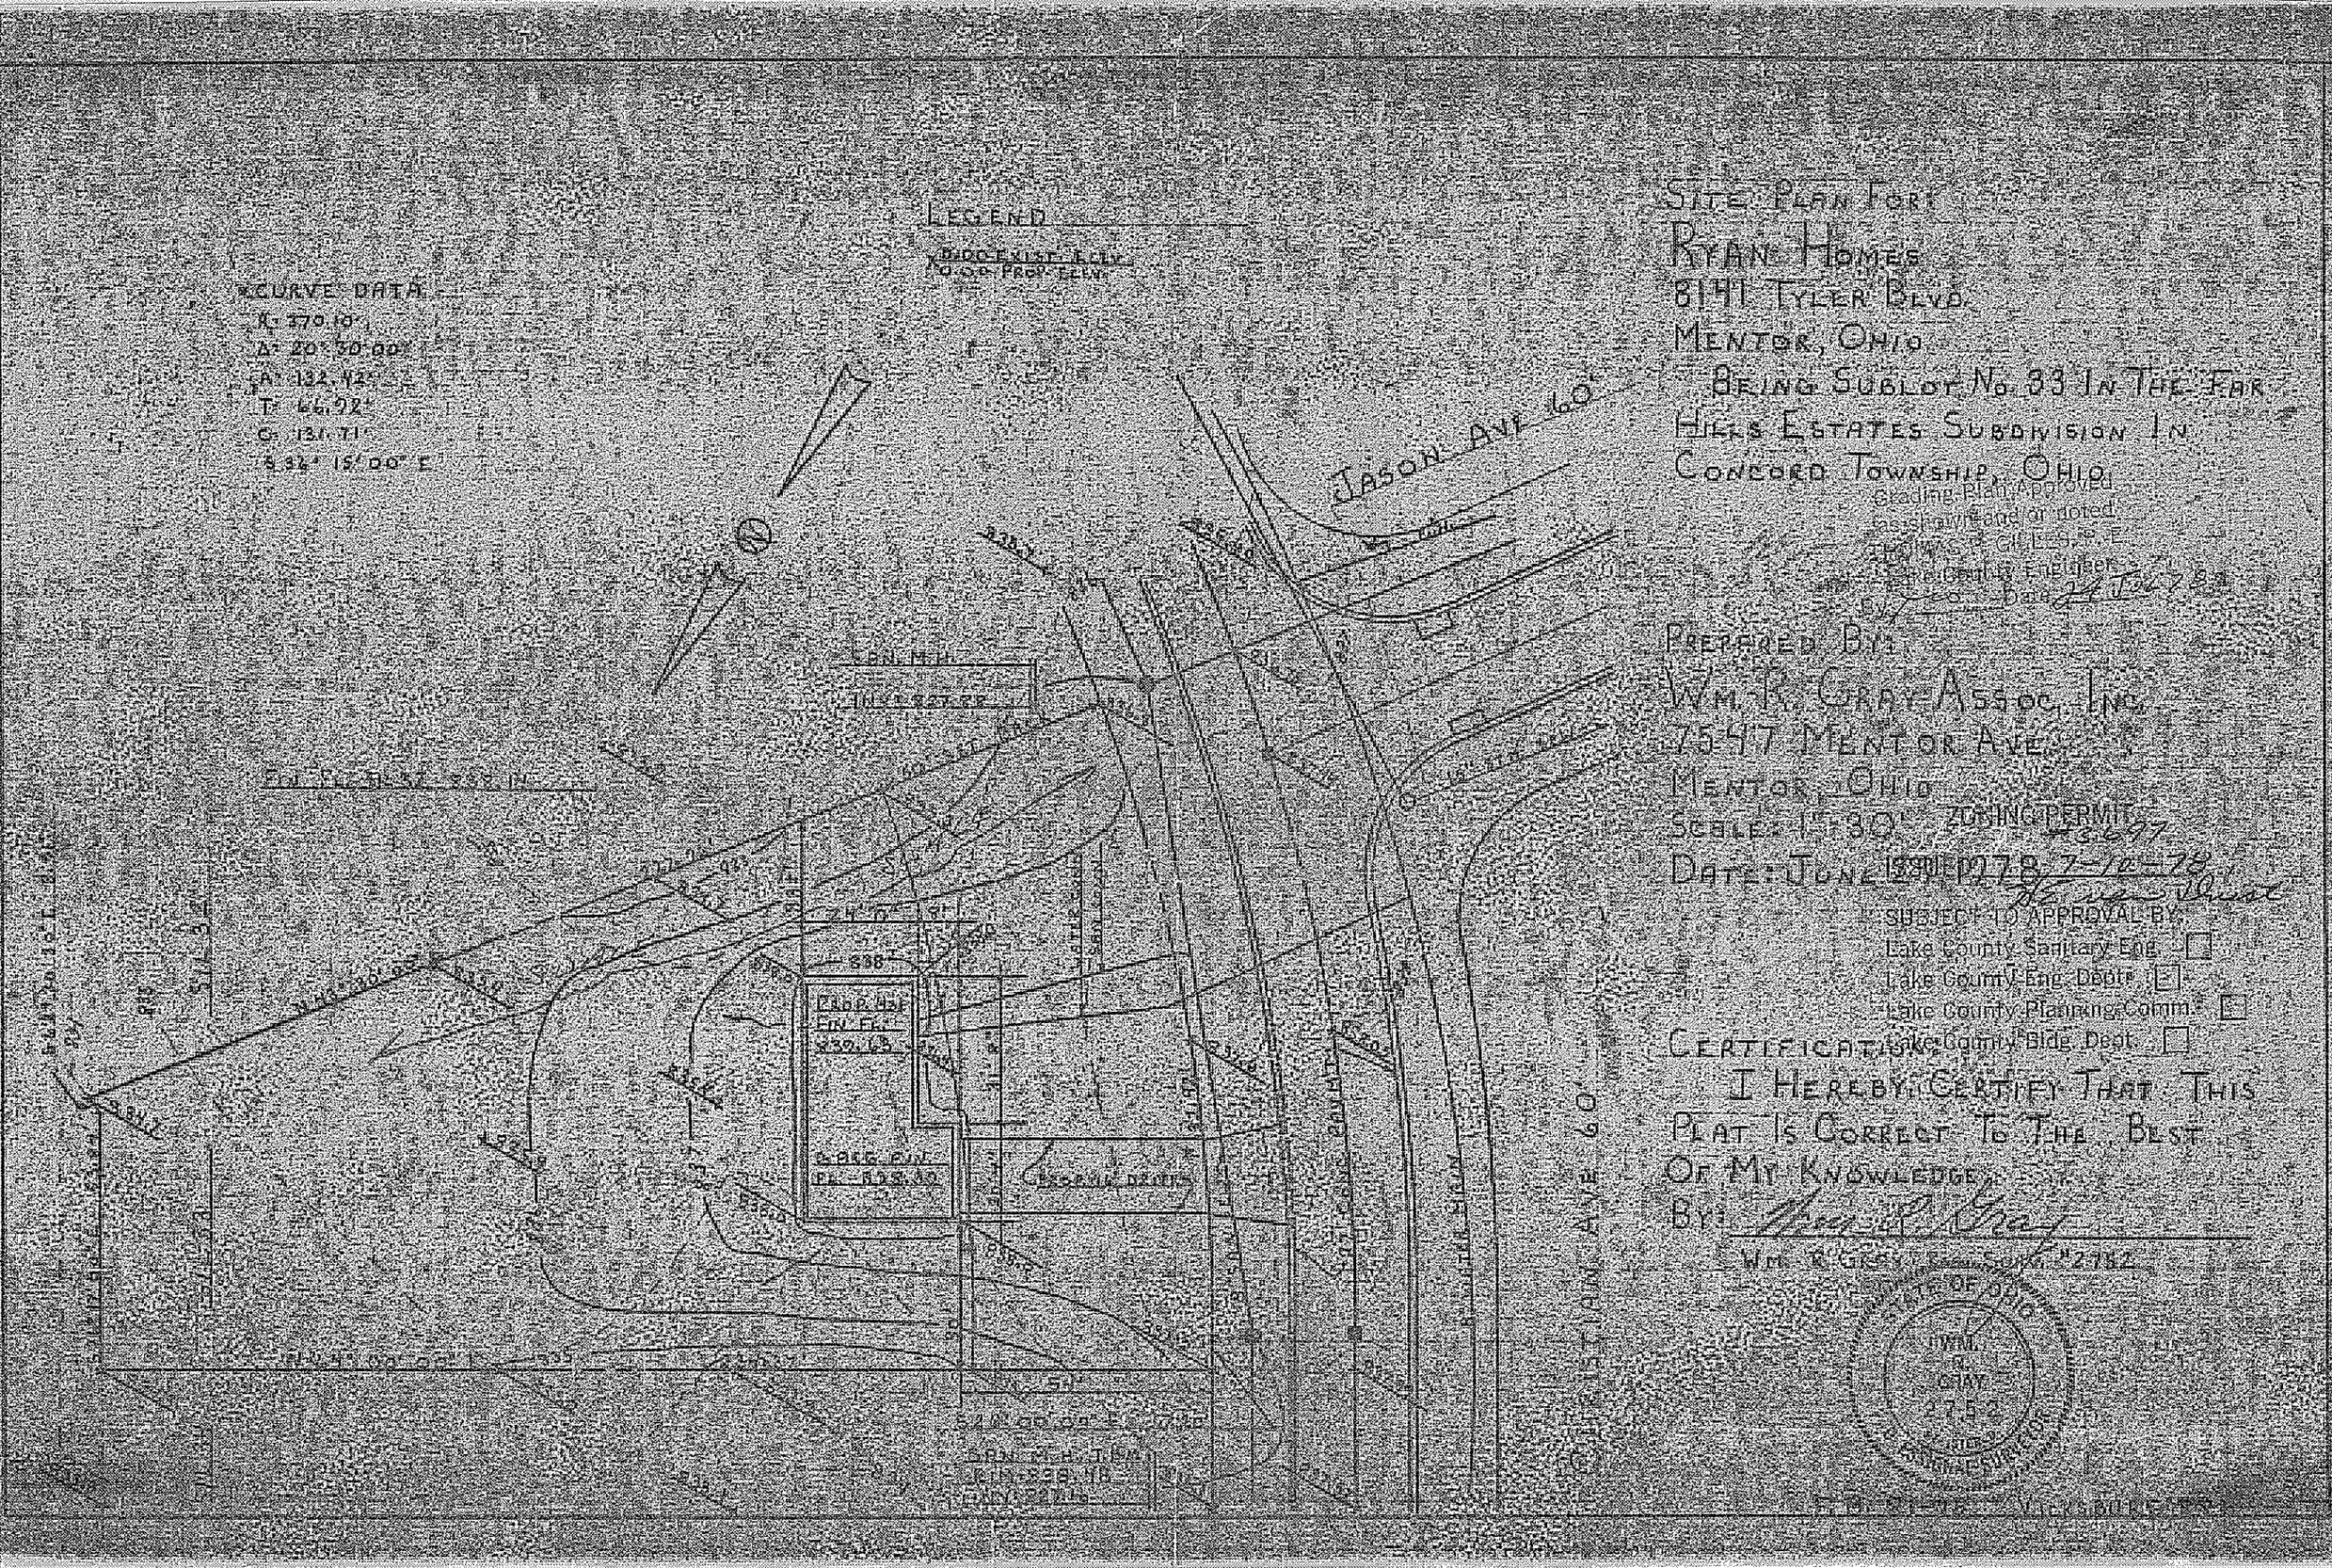
LEGEND
CURVE DATA
R: 370.10'
Δ: 20° 30' 00"
A: 132.42'
T: 66.92'
C: 131.71'
S 34° 15' 00" E
JASON AVE 60'
CHRISTIAN AVE 60'
SITE PLAN FOR:
RYAN HOMES
8141 TYLER BLVD.
MENTOR, OHIO
BEING SUBLOT NO. 33 IN THE FAR HILLS ESTATES SUBDIVISION IN CONCORD TOWNSHIP, OHIO
Grading Plan Approved
as shown and or noted
Lake County Engineer
Date 24 Jul 78
PREPARED BY:
WM. R. GRAY ASSOC. INC.
7547 MENTOR AVE.
MENTOR, OHIO
SCALE: 1"=30'
DATE: JUNE 21, 1978
ZONING PERMIT
#3697
ISSUED 7-10-78
SUBJECT TO APPROVAL BY:
Lake County Sanitary Eng.
Lake County Eng. Dept.
Lake County Planning Comm.
Lake County Bldg. Dept.
CERTIFICATION:
I HEREBY CERTIFY THAT THIS PLAT IS CORRECT TO THE BEST OF MY KNOWLEDGE.
BY:
WM. R. GRAY
STATE OF OHIO
WM. R. GRAY
2752
VICKSBURG