Approved
shown and/or noted
THOMAS P. GILLES, P.E.
Lake County Engineer
By JWK Date 3-1-74

SITE PLAN FOR:

RYAN HOMES
23600 MERCANTILE ROAD
BEACHWOOD, OHIO

BEING SUBLOT NO. 36 IN THE REVERE WOODS
SUBDIVISION NO. 2 IN CONCORD TWP., OHIO

PREPARED BY:

WM. R. GRAY ASSOC., INC.
7547 MENTOR AVENUE
MENTOR, OHIO

DATE: OCTOBER 4, 1973 SCALE: 1"=30'
REV'D: FEBRUARY 14, 1974

ENGINEERS
SURVEYORS

CERTIFICATION:

I HEREBY CERTIFY THAT THIS PLAT IS CORRECT TO THE BEST OF MY KNOWLEDGE.

BY: Wm. R. Gray
WM. R. GRAY R.S. # 2752
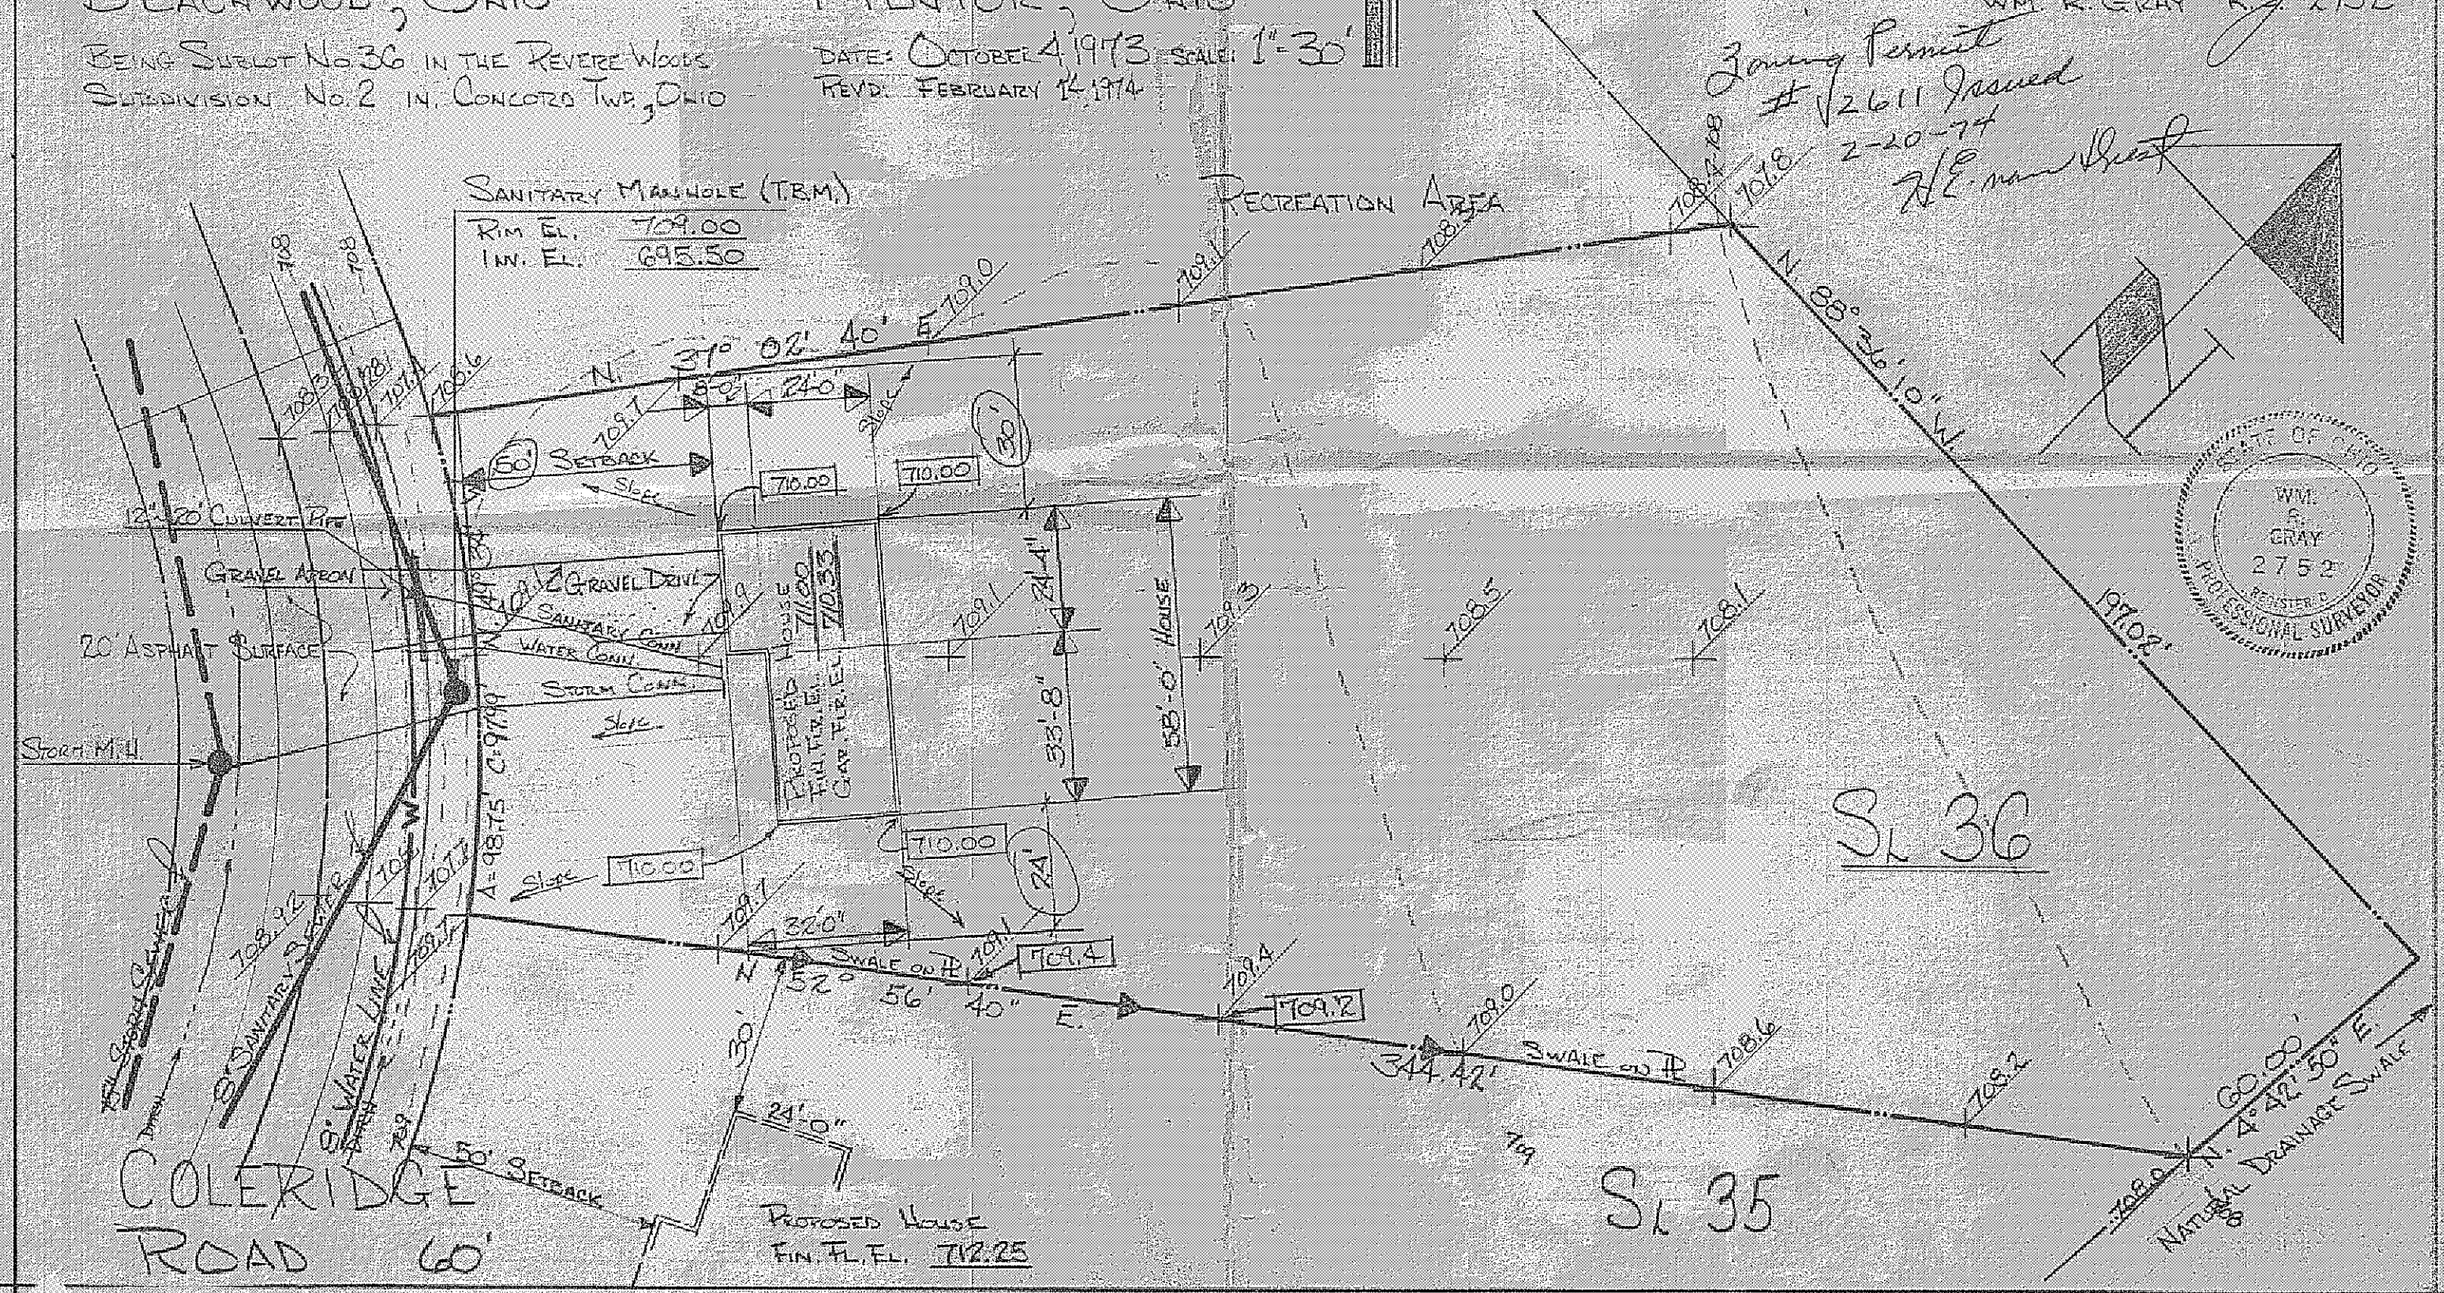
Zoning Permit
# 2611 Issued
2-20-74
H.E. [illegible]