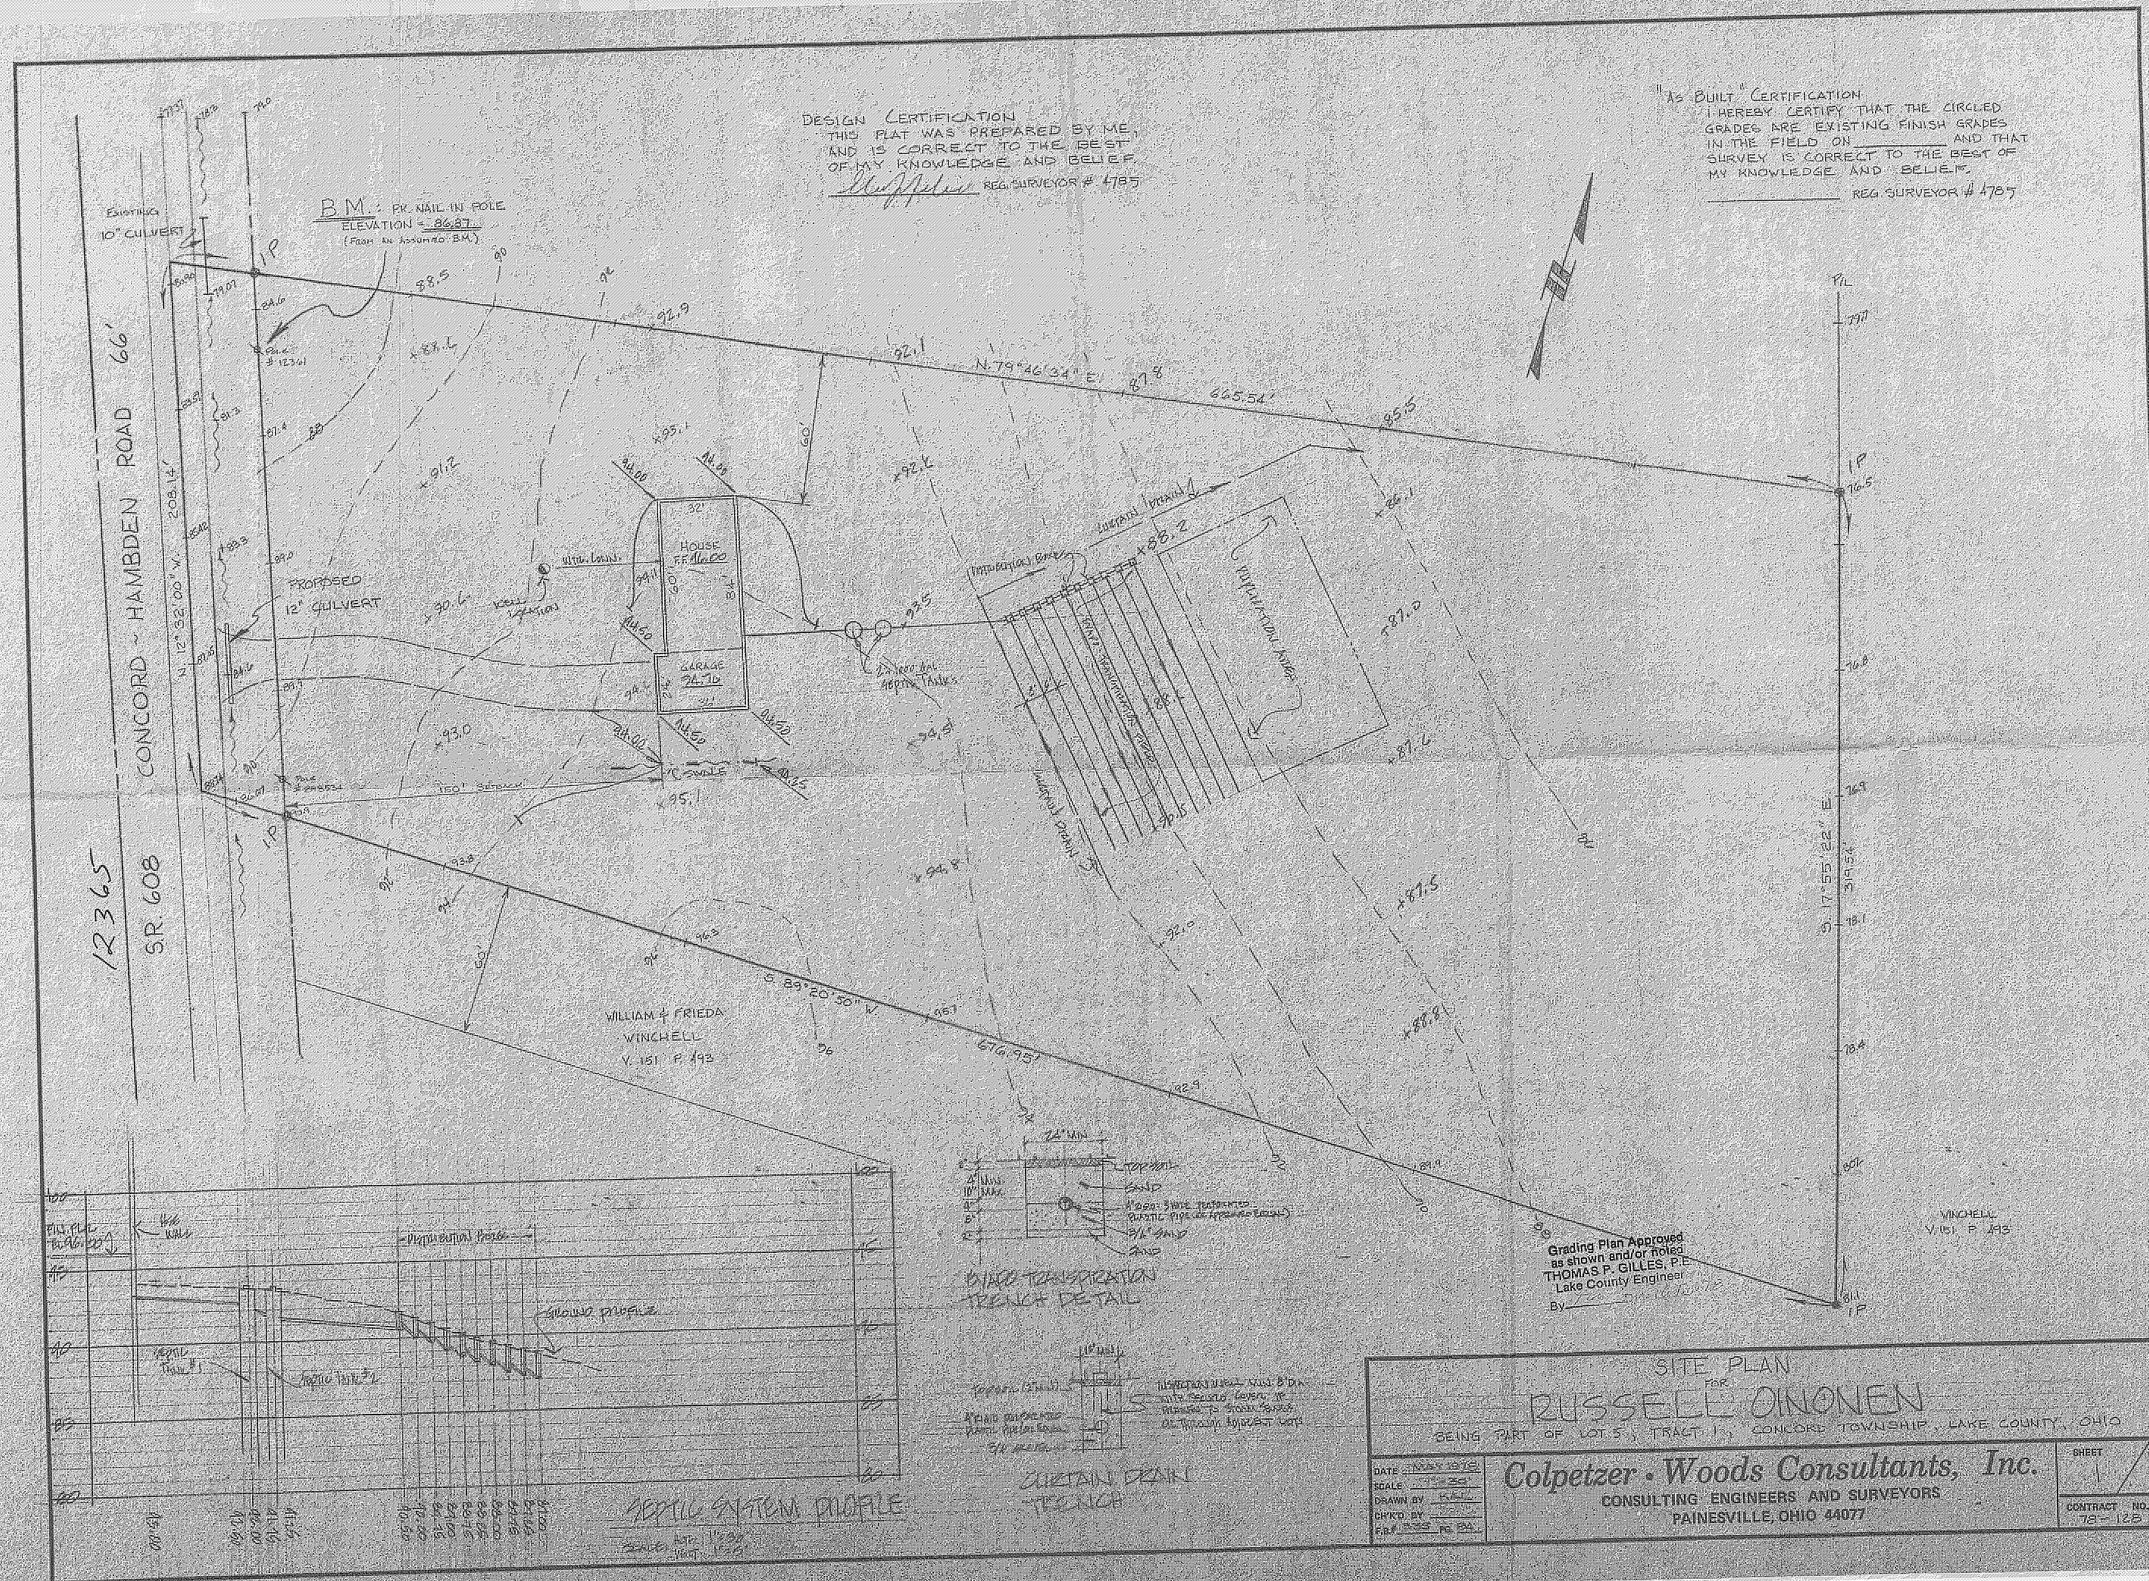
DESIGN CERTIFICATION
THIS PLAT WAS PREPARED BY ME, AND IS CORRECT TO THE BEST OF MY KNOWLEDGE AND BELIEF.
REG. SURVEYOR # 4785
"AS BUILT" CERTIFICATION
I HEREBY CERTIFY THAT THE CIRCLED GRADES ARE EXISTING FINISH GRADES IN THE FIELD ON _____ AND THAT SURVEY IS CORRECT TO THE BEST OF MY KNOWLEDGE AND BELIEF.
_____ REG. SURVEYOR # 4785
B.M.: PK. NAIL IN POLE
ELEVATION = 86.87
(FROM AN ASSUMED B.M.)
EXISTING 10" CULVERT
CONCORD ~ HAMBDEN ROAD 66'
12365
S.R. 608
N. 12°32'00" W. 208.14'
PROPOSED 12" CULVERT
HOUSE
GARAGE
N. 79°46'34" E. 665.54'
S. 89°20'50" W. 676.95'
S. 17°55'22" E. 319.54'
WILLIAM & FRIEDA WINCHELL V. 151 P. 493
WINCHELL V. 151 P. 493
Grading Plan Approved as shown and/or noted
THOMAS P. GILLES, P.E.
Lake County Engineer
By
SEPTIC SYSTEM PROFILE
GROUND PROFILE
SEPTIC TANK #1
SEPTIC TANK #2
BYADO TRANSPIRATION TRENCH DETAIL
CURTAIN DRAIN TRENCH
SITE PLAN
FOR
RUSSELL OINONEN
BEING PART OF LOT 5, TRACT 1, CONCORD TOWNSHIP, LAKE COUNTY, OHIO
DATE MAY 1978
SCALE 1" = 30'
DRAWN BY
CH'K'D BY
F.B.# 335 PG. 84
Colpetzer · Woods Consultants, Inc.
CONSULTING ENGINEERS AND SURVEYORS
PAINESVILLE, OHIO 44077
SHEET 1 OF 1
CONTRACT NO. 78-128